

MIDSHIP SECTION.

DIMENSIONS: 420'-0" B. P. x 53'-9" M^{LD} x 38'-1" K. TO B.

SCALE $\frac{1}{2}$ " = 1 FOOT.

TO CLASS 100 A1 [WITH FREEBOARD.]



COPY TO
MR KEITH 28.5.23
LLOYDS 31.5.23
Do 8.6.23
BELFAST
OWNERS 16.6.23
MURKINSON 26.7.23

NUMERALS.

D = 37.15 d = 25.56
L x D = 419.5 x 37.15 = 15584
L x (B+D) = 419.5 (53.75 + 37.15) = 38133
 $\frac{L}{D}$ TO SHELTER DECK = 11.3
EQUIPMENT "N"
38133 + 328 = 38461.

SHELTER DECK


UPPER DECK

EXTRACTS FROM SPECIFICATION

THE THICKNESSES OF THE FOLLOWING ITEMS ARE EACH TO BE INCREASED 10% ABOVE THOSE APPROVED BY LLOYDS

- TANK CENTRE PLATE
- TANK VERTICAL ANGLES OF TANK CENTRE PLATE
- SOLID & BRACKET FLOOR PLATES
- TANK REVERSE FRAMES
- TANK MARGIN PLATE
- VERTICAL ANGLE ON TANK MARGIN PLATE INSIDE TANK
- INTERCOSTAL PLATES
- TOP & VERTICAL ANGLES ON INTERCOSTAL PLATES
- TANK TOP PLATING
- SHELTER DECK SHEER STRAKE FORE & AFT
- FLAT KEEL PLATES & BOTTOM SHELL
- PLATING FOR $\frac{1}{5}$ LENGTH FOR WIDTH OF DOUBLE BOTTOM, I.E. FROM MARGIN PLATE TO MARGIN PLATE

BETWEEN FRAMES 20" & 7"

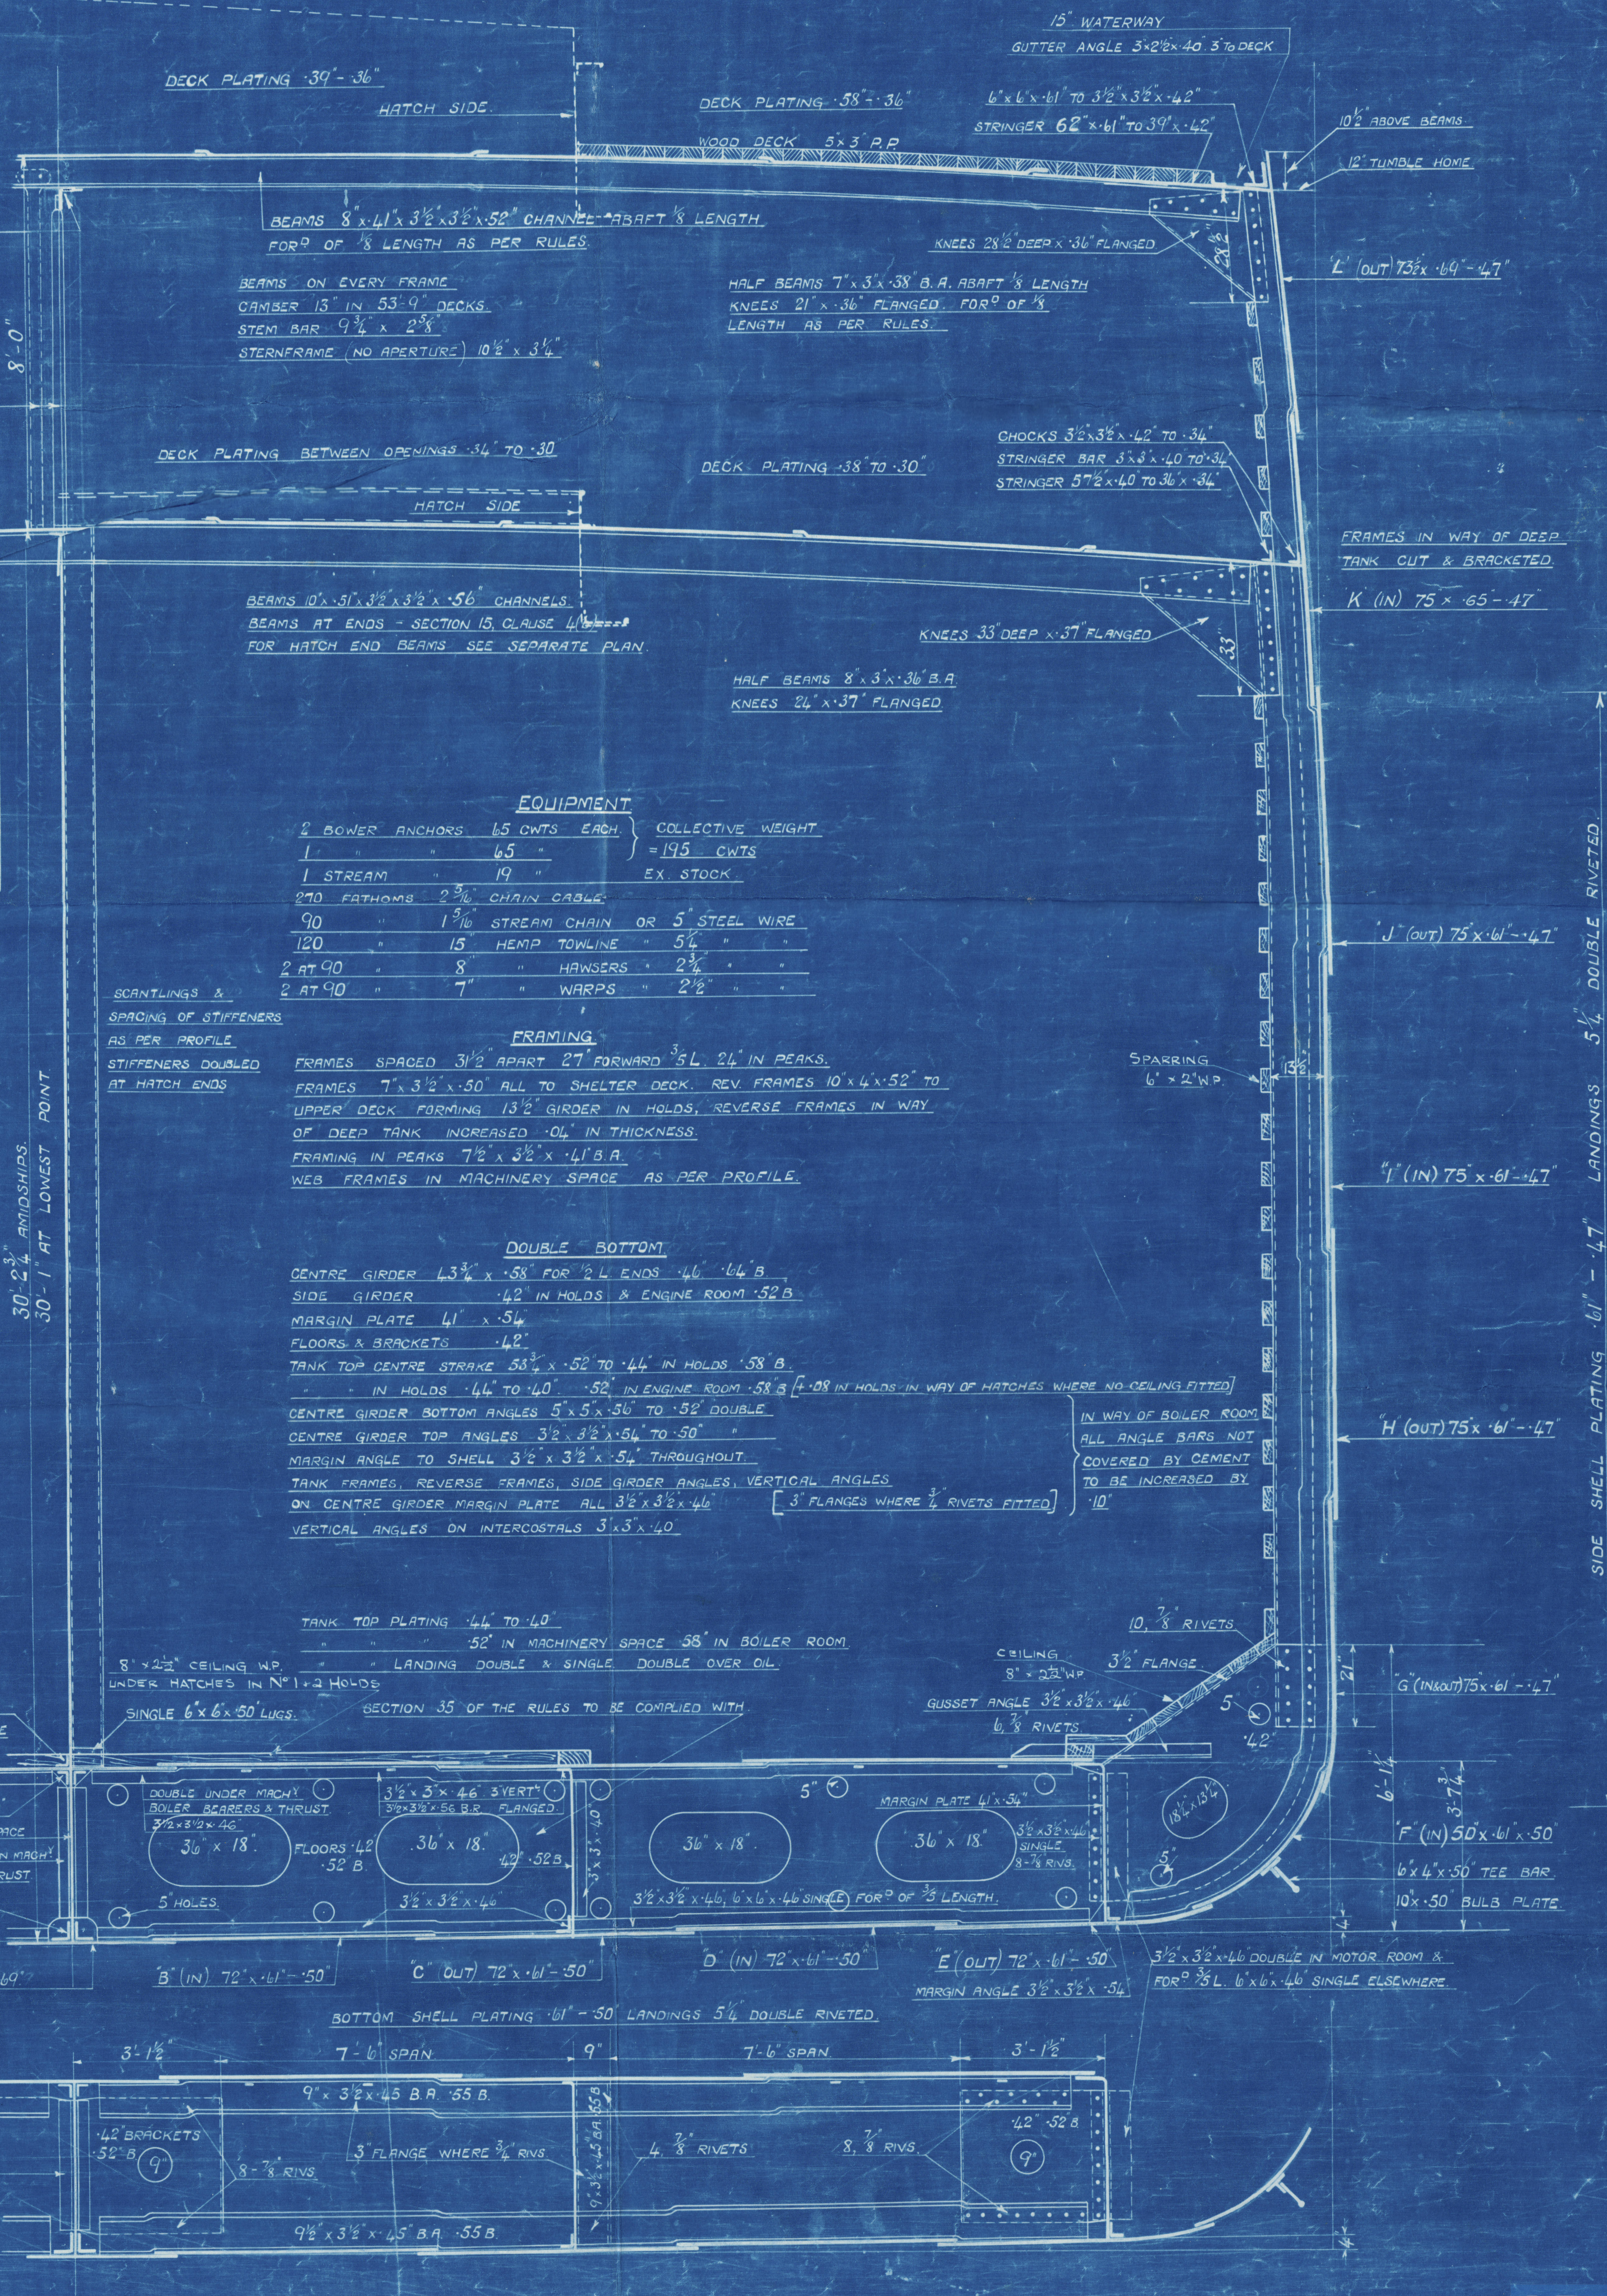

DOUBLE RIVETED. 5 1/4" LANDINGS. 6 1/2" x 47". SIDE SHELL PLATING .61" x 47".

502

38133 + 328

16th Sept. 19.24⁴²

HARLAND & WOLFF LIMITED,
GOVAN, GLASGOW.

© 2019

THIS ENCLOSURE TO BE SENT TO

Lloyds Register of Shipping
Glasgow

W284-0708

TER


6 x 6"

"Birchbank"

Midship Sect
as built.

Glasgow Apt No. 43950.

Harland & Wolff No 656

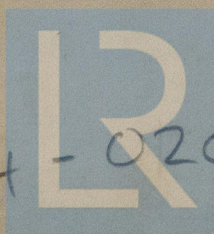

© 2019

W234 - 0208 Lloyd's Register
Foundation