

GHQ/SCAP Records (RG 331, National Archives and Records Service)

Description of contents

- (1) Box no. 2933
- (2) Folder title/number: (3)
Ex-Kakogawa 1st Army Hospital (Cover Title)

(3) Date: July 1946

(4) Subject:



Classification	Type of record
9212, 9230	r

(5) Item description and comment:
Hyogo

(6) Reproduction: Yes No

(7) Film no. Sheet no.


(Compiled by *National Diet Library*)

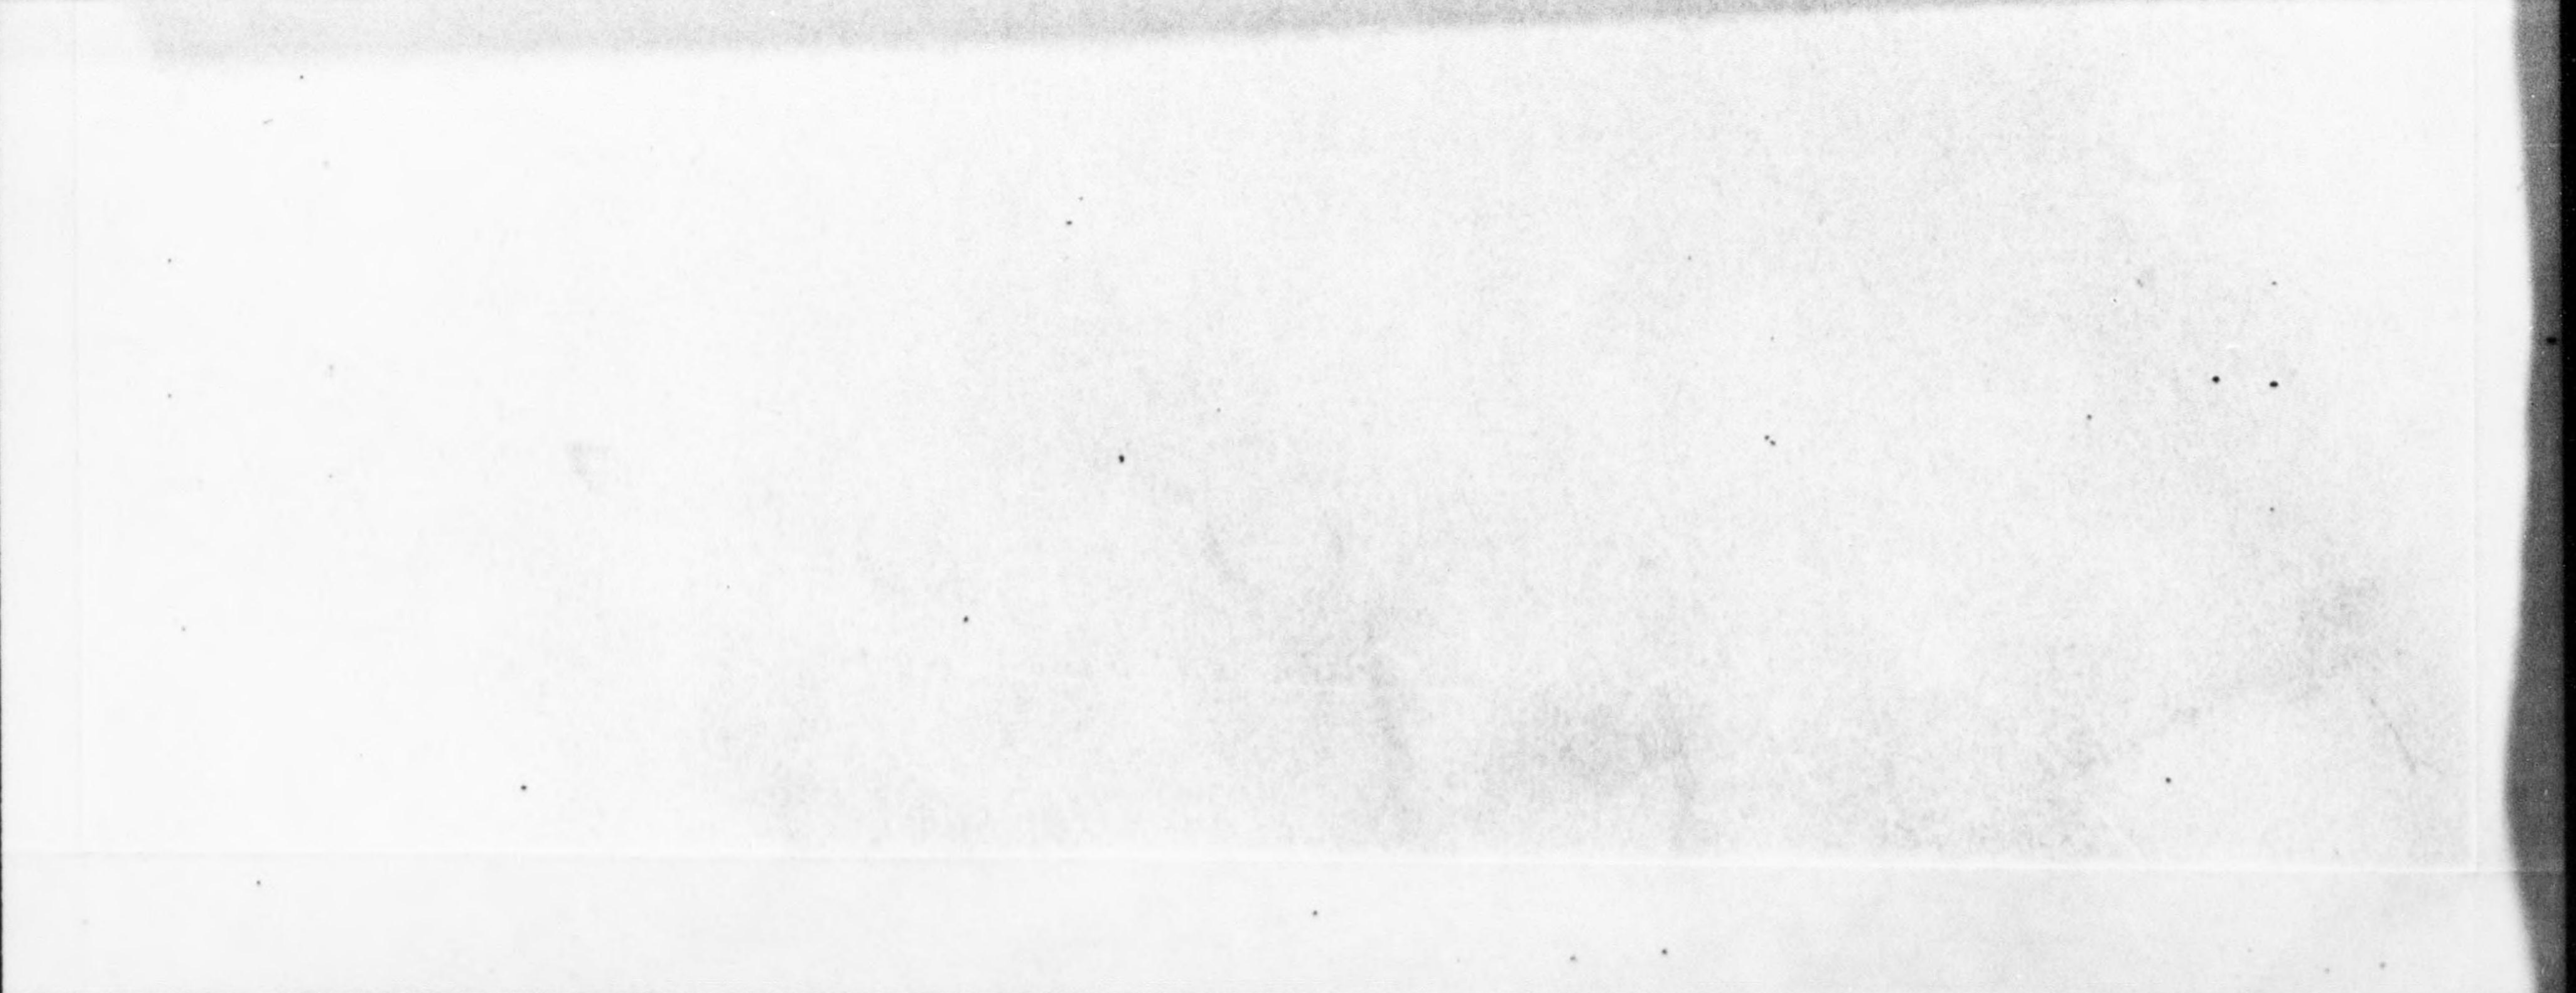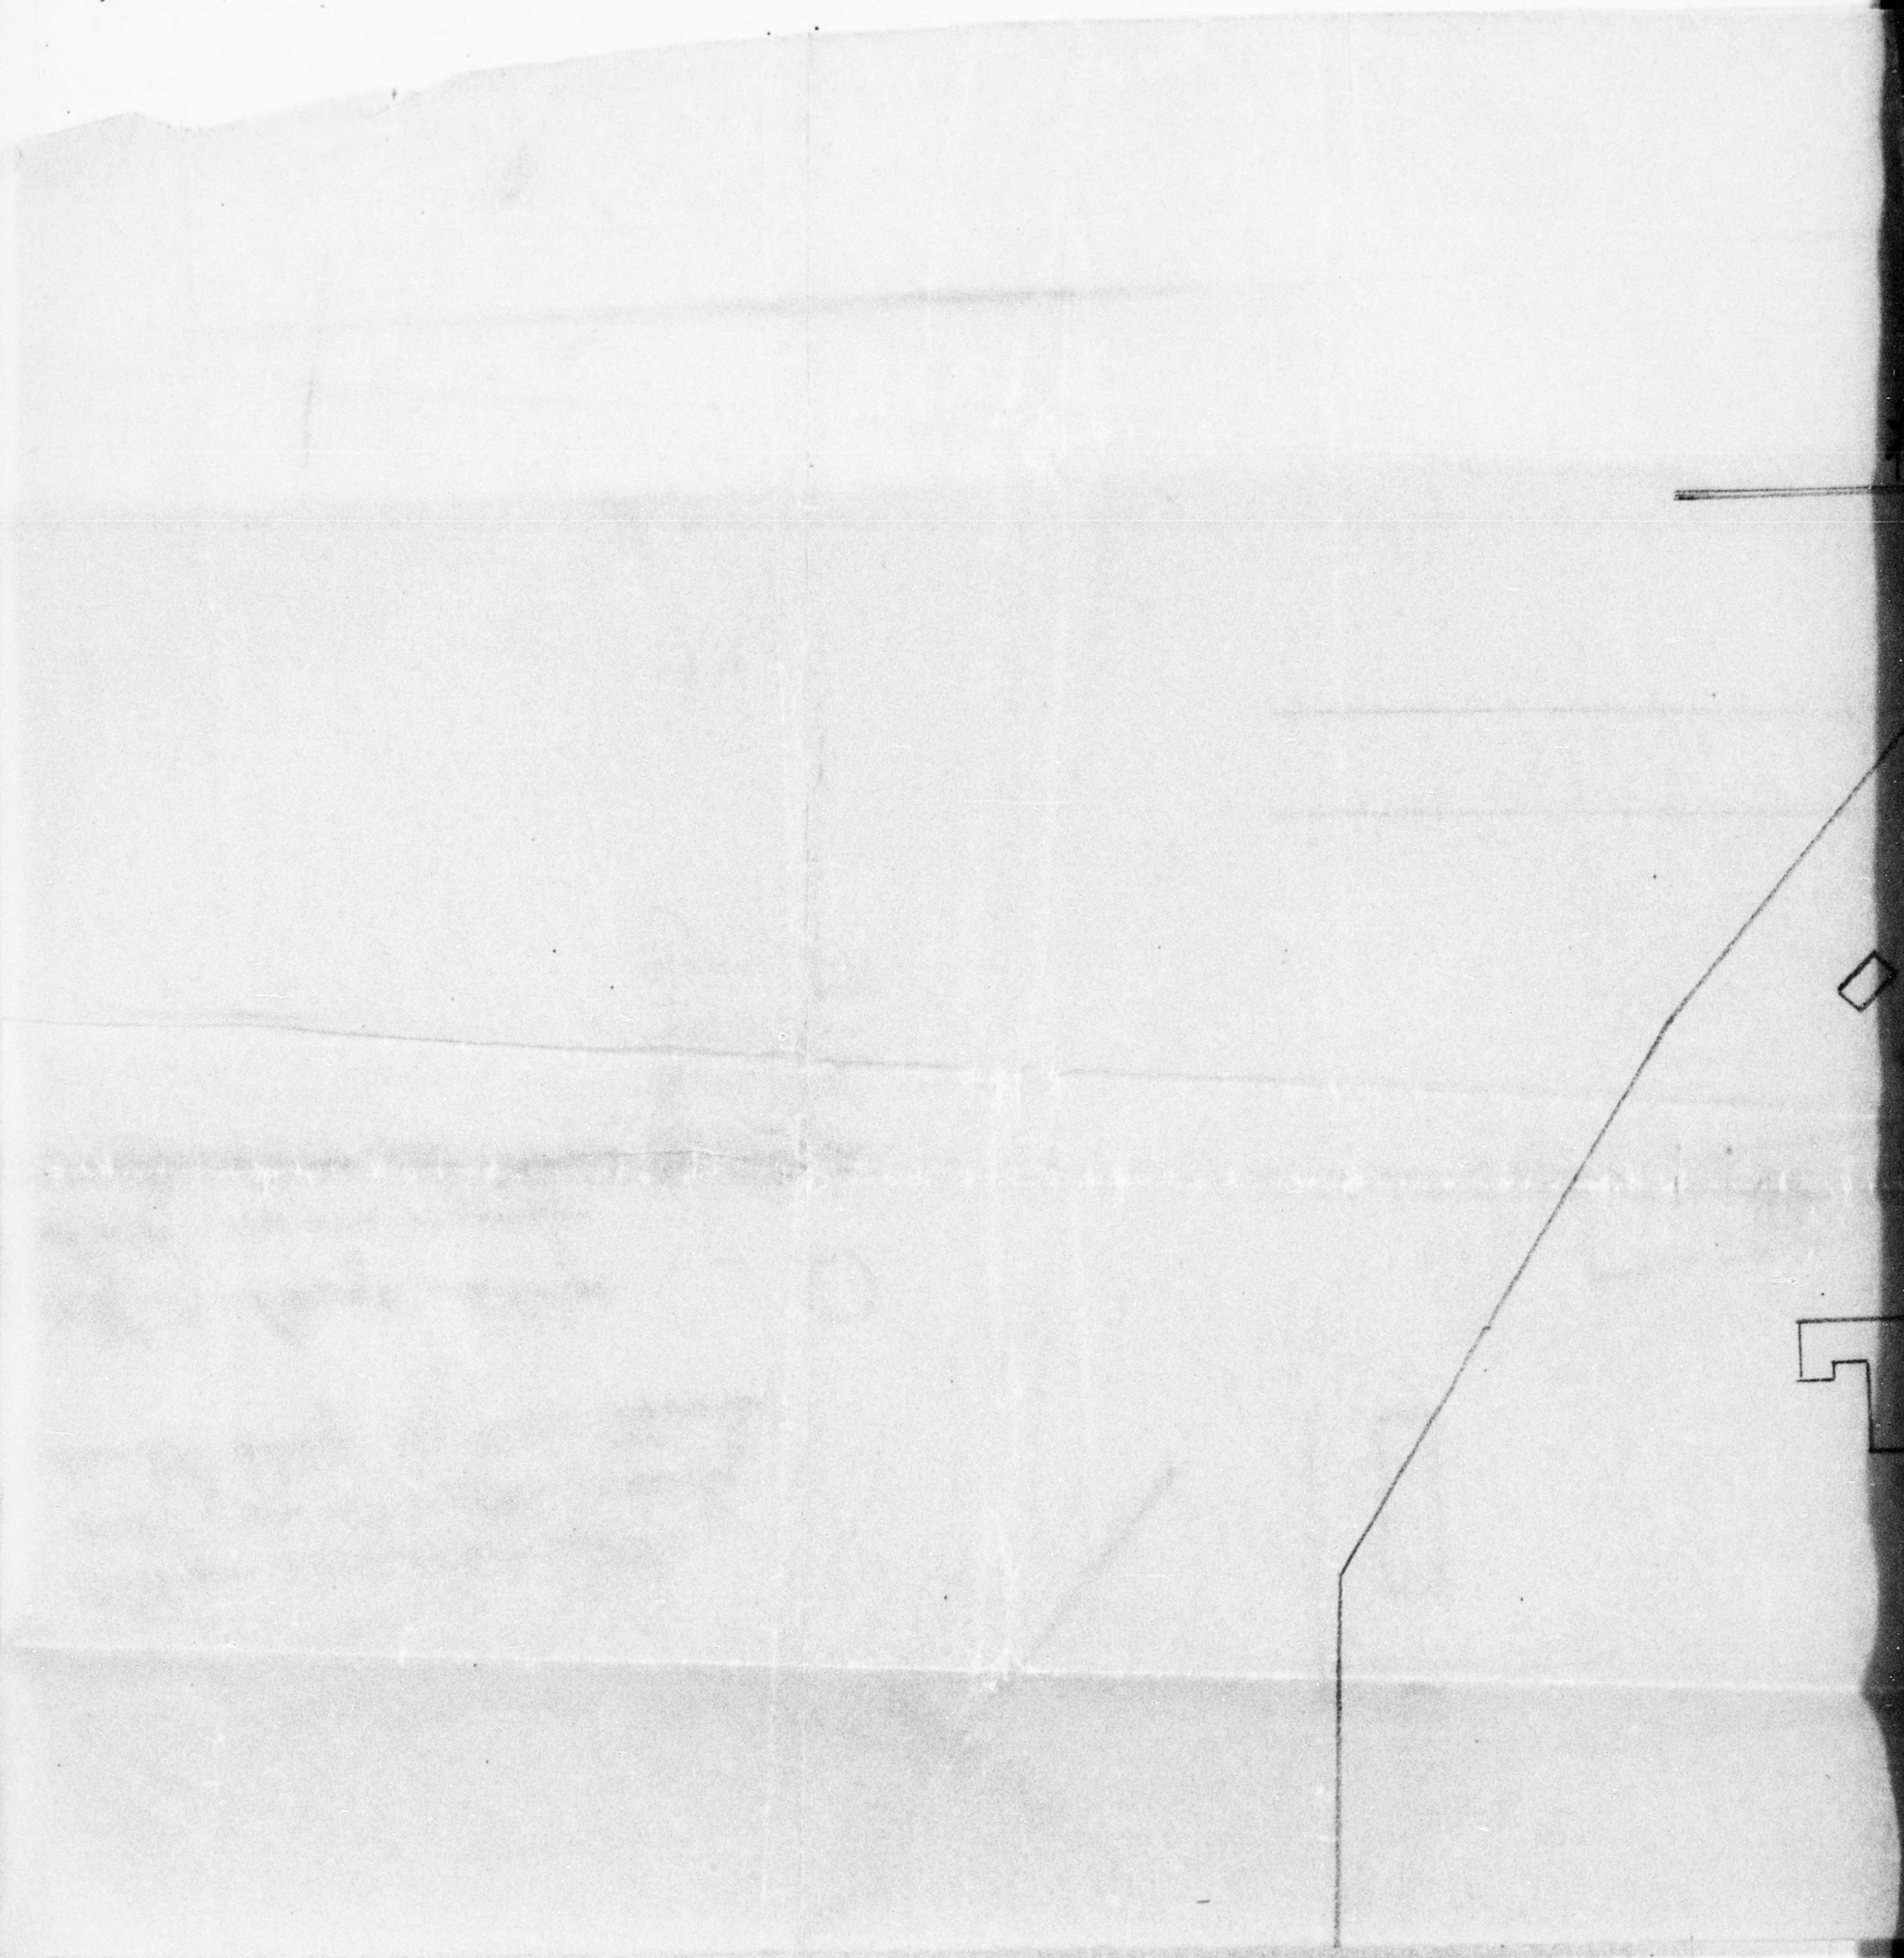

兵

病院配置圖

CE

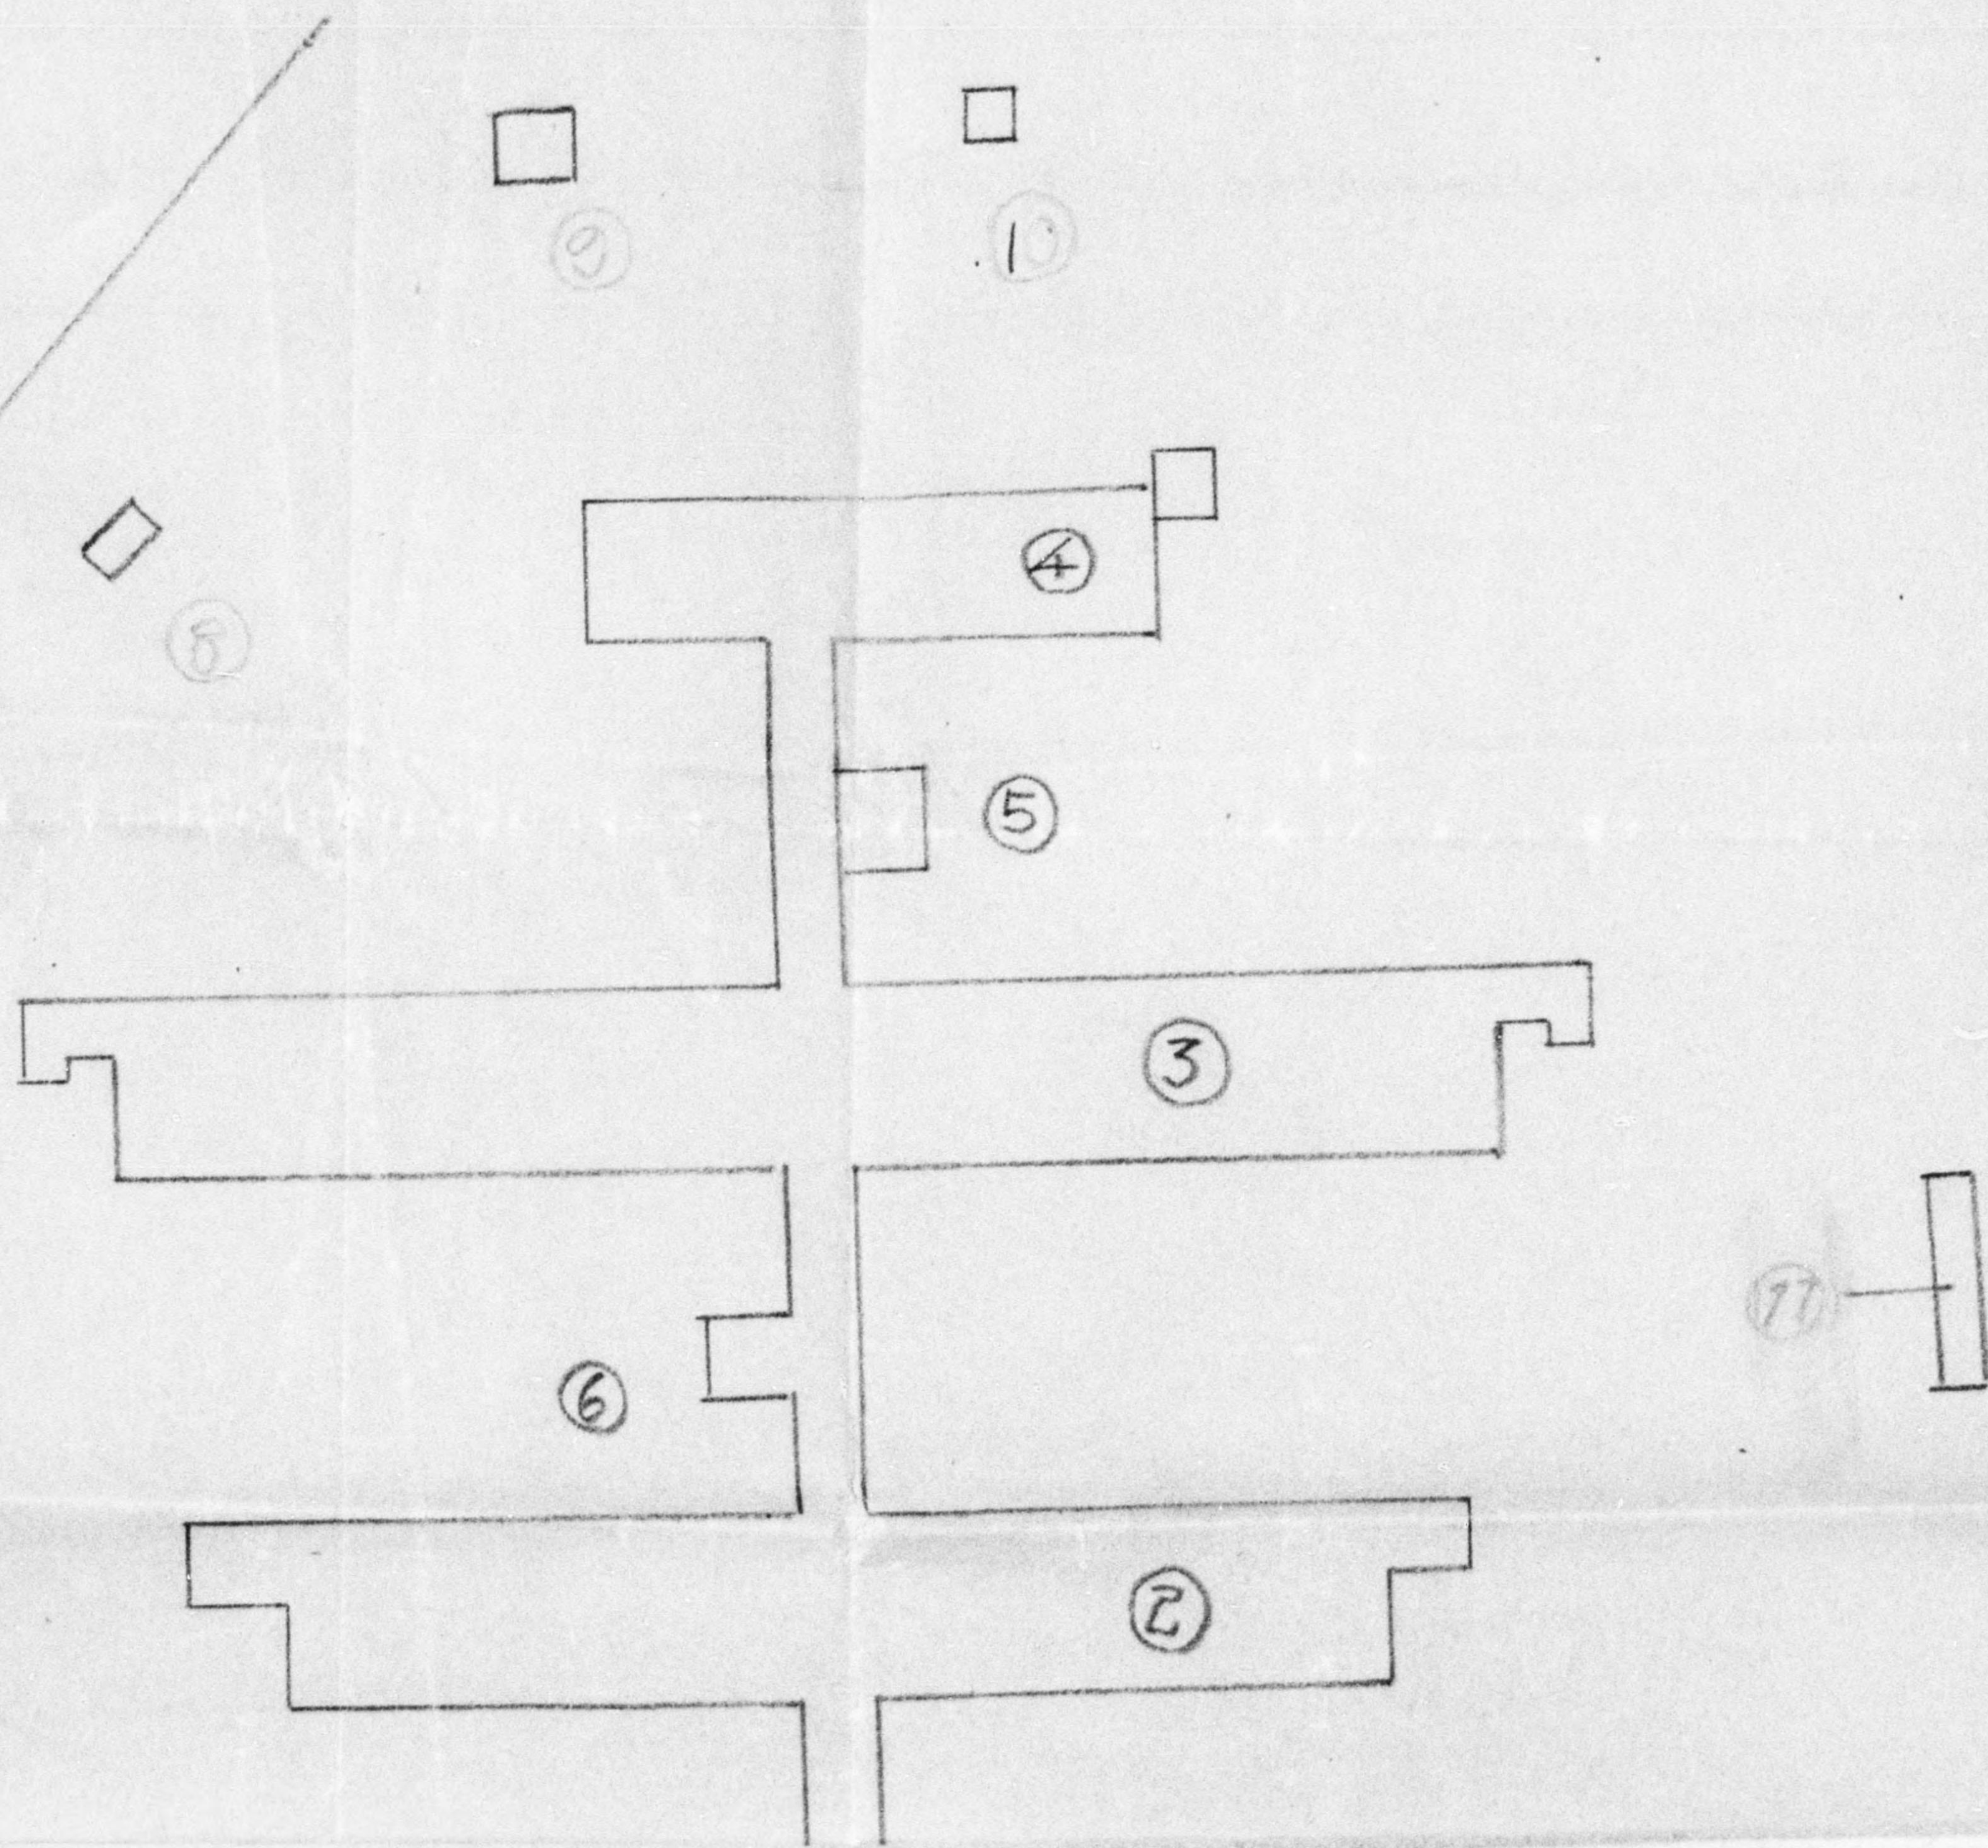


兵庫縣加古郡尾上村病院女舎

CE-31-PD-292-2-46-2

77



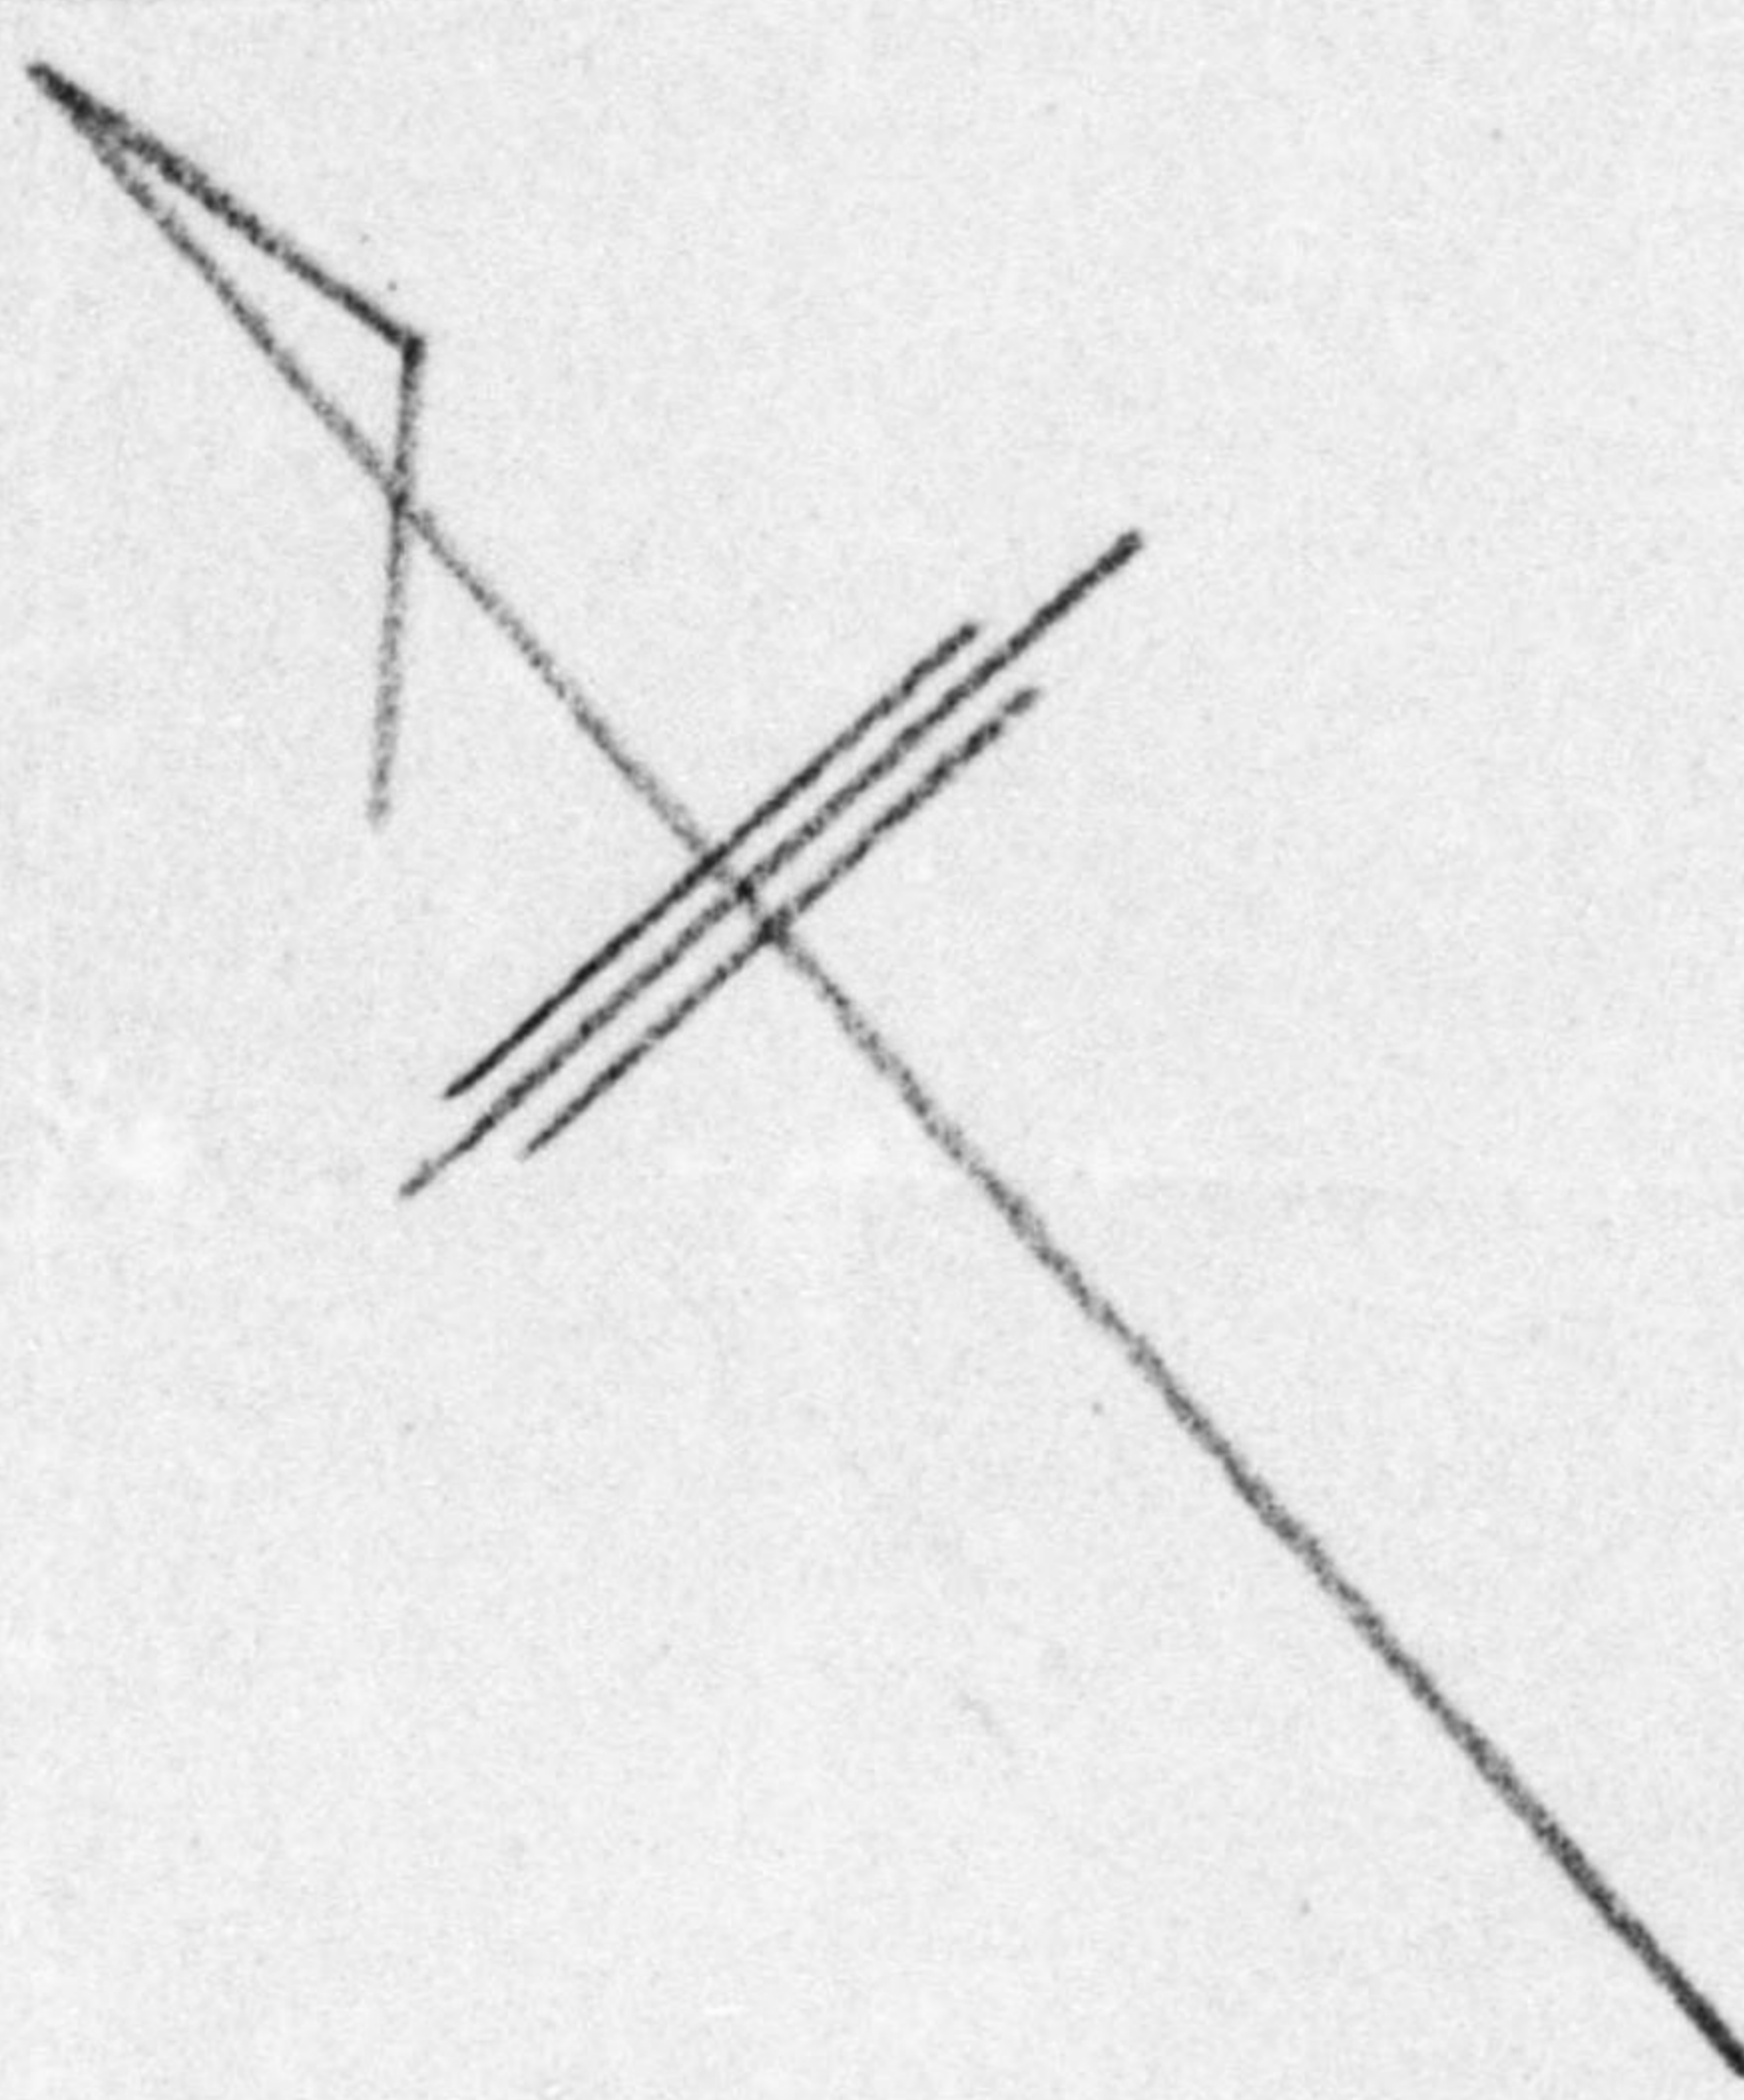

Bldgs encircled with red pencil were newly built bldgs by Occ. Forces

all 7 large bldgs had some repair work done on them

○	○
新築	修理
所	所

7

77



神戸市生田区下山手通五丁目

第三十二軍政部

商工課

中



No. 55

Ex Takoyama

昭和 年 月 日
Army Hospital

電話高砂四〇一番

高砂土建工業株式會社

兵庫縣加古郡高砂町