DECLASSIFIED E.O. 12065 SECTION 3-402 / NNBG NO: 1760-13

YOKOSIMA OIL RESERVOIR

N

noto;
Released 19 June ~~1947~~ 1946 197.510 Tsubo
Turned over to
ministory of agriculture

~~31 march~~ 1948 147.960 Tsubo
2 ~~December~~ March

WELL
12 Tsubo WARE HOUSE
HIKARI SHOKUHIN KOGYO K.K
73 Tsubo
OFFICE HOUSE
WATER RESERVOIR
WARE HOUSE
52.5 Tsubo
LODG
12 Tsubo
WATER RESERVOIR
WATER RESERVOIR
FOAM HOUSE
PUMP HOUSE
WATER RESERVOIR
HOUSE
1
2
FIRE PLUG
HIKARI SHOKUHIN KOGYO K.K.
17.5 Tsubo
79.5 Tsubo
95 Tsubo (23)
18.9 Barels 3,000 M³
18.5 Tsubo
3
4
SHRIMP HOUSE OWNED BY YAMANAKA SEIFUN
260M = 853'
15.6'

DECLASSIFIED E.O. 12065 SECTION 3-402 / NNDG NO.

ERVOIR

KURE

LODGING HOUSE

LODGING HOUSE

12 Tsubo

28 Tsubo

RI SHOKUHIN KOGYO K.K

WATER RESERVOIR

TRANSFORMER

12 Tsubo (3)

SWITCH BOARD HOUSE

16 Tsubo (4)

OIR

USE

MP HOUSE

WATER RESERVOIR

18.9 Barels 3,000 M³

SHRIMP HOUSE OWNED BY YAMANAKA SEIFUN

15.5'

6"

3"

6"

4"

DECLASSIFIED E.O. 12065 SECTION 3-402 / NNBG NO.

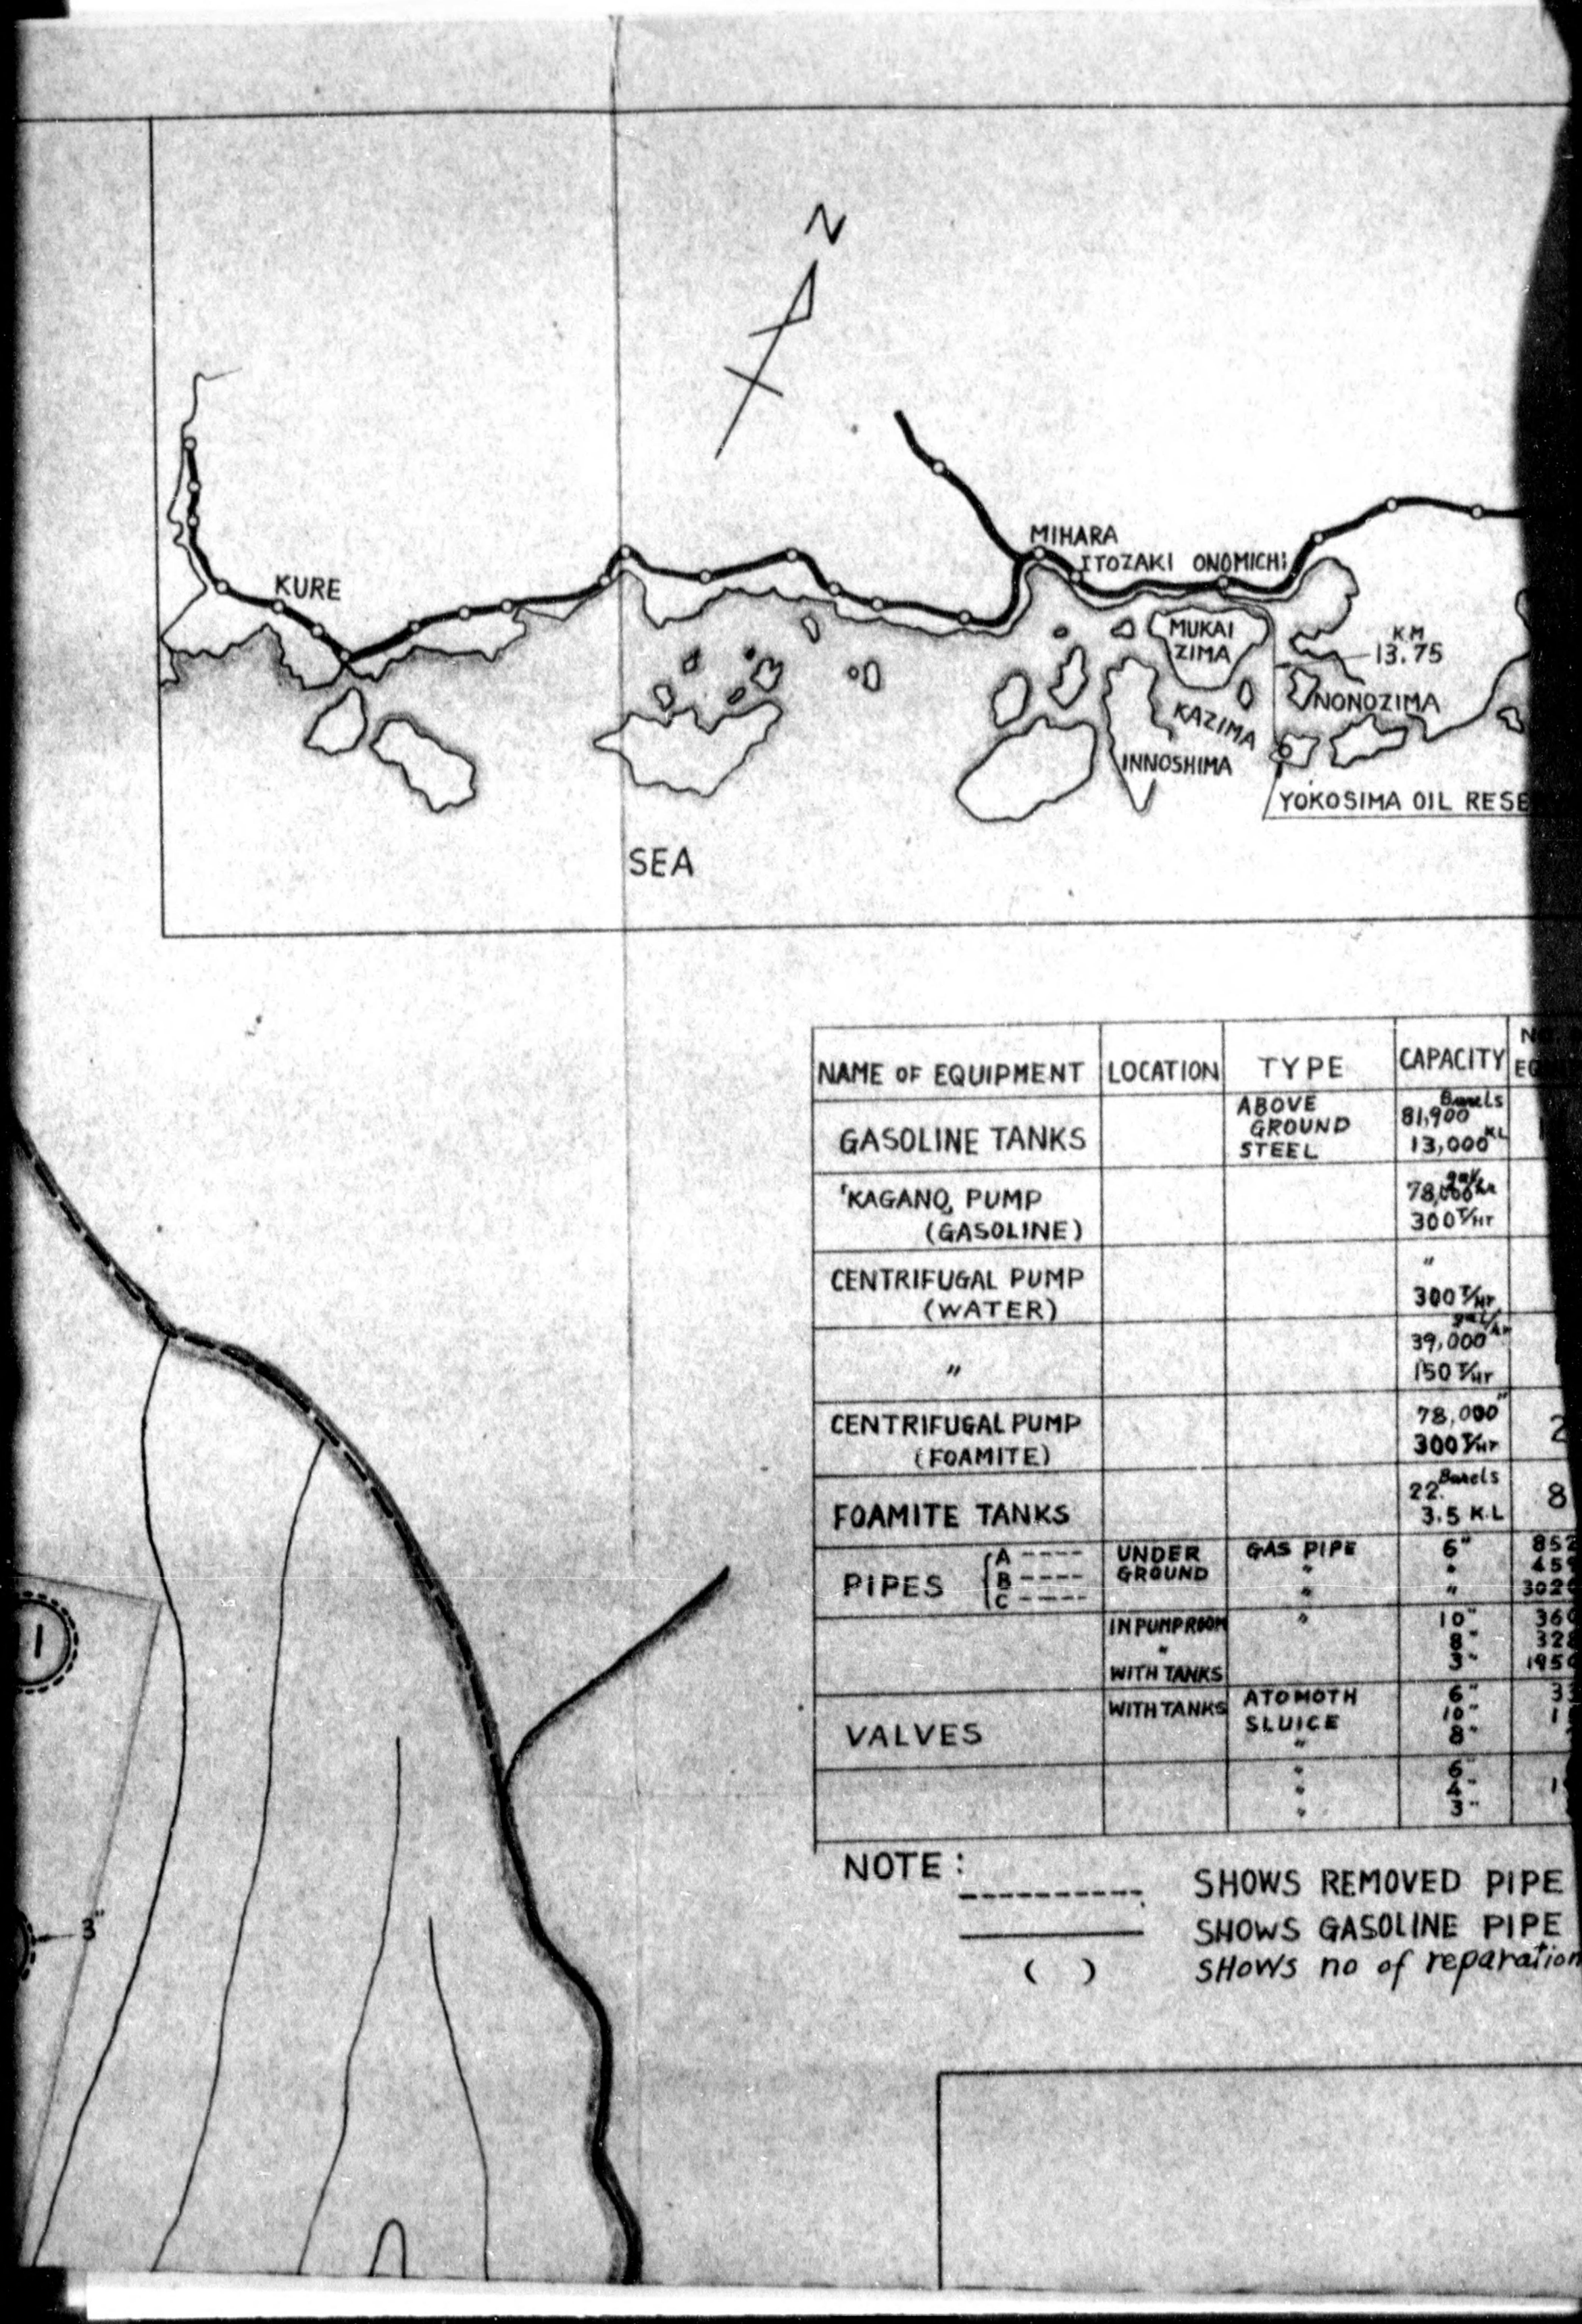

NAME OF EQUIPMENT	LOCATION	TYPE	CAPACITY	NO. OF EQ
GASOLINE TANKS		ABOVE GROUND STEEL	81,900 Barrels 13,000 KL	
'KAGANO, PUMP (GASOLINE)			78,000 29K/hr 300 T/HR	
CENTRIFUGAL PUMP (WATER)			" 300 T/HR	
"			39,000 9m³/MIN 150 T/HR	
CENTRIFUGAL PUMP (FOAMITE)			78,000" 300 T/HR	2
FOAMITE TANKS			22. Barrels 3.5 K.L	8
PIPES A ----	UNDER GROUND	GAS PIPE	6"	852
PIPES B ----	"	"	"	45
PIPES C ----	"	"	"	302
	IN PUMPROOM	"	10"	36
	"		8"	32
	WITH TANKS		3"	195
VALVES	WITH TANKS	ATOMOTH SLUICE	6"	3
	"	"	10"	1
	"	"	8"	
	"	"	6"	
	"	"	4"	1
	"	"	3"	

NOTE : ---------- SHOWS REMOVED PIPE
_____ SHOWS GASOLINE PIPE
( ) SHOWS no of reparation

DECLASSIFIED E.O. 12065 SECTION 3-402 / NNBG NO.

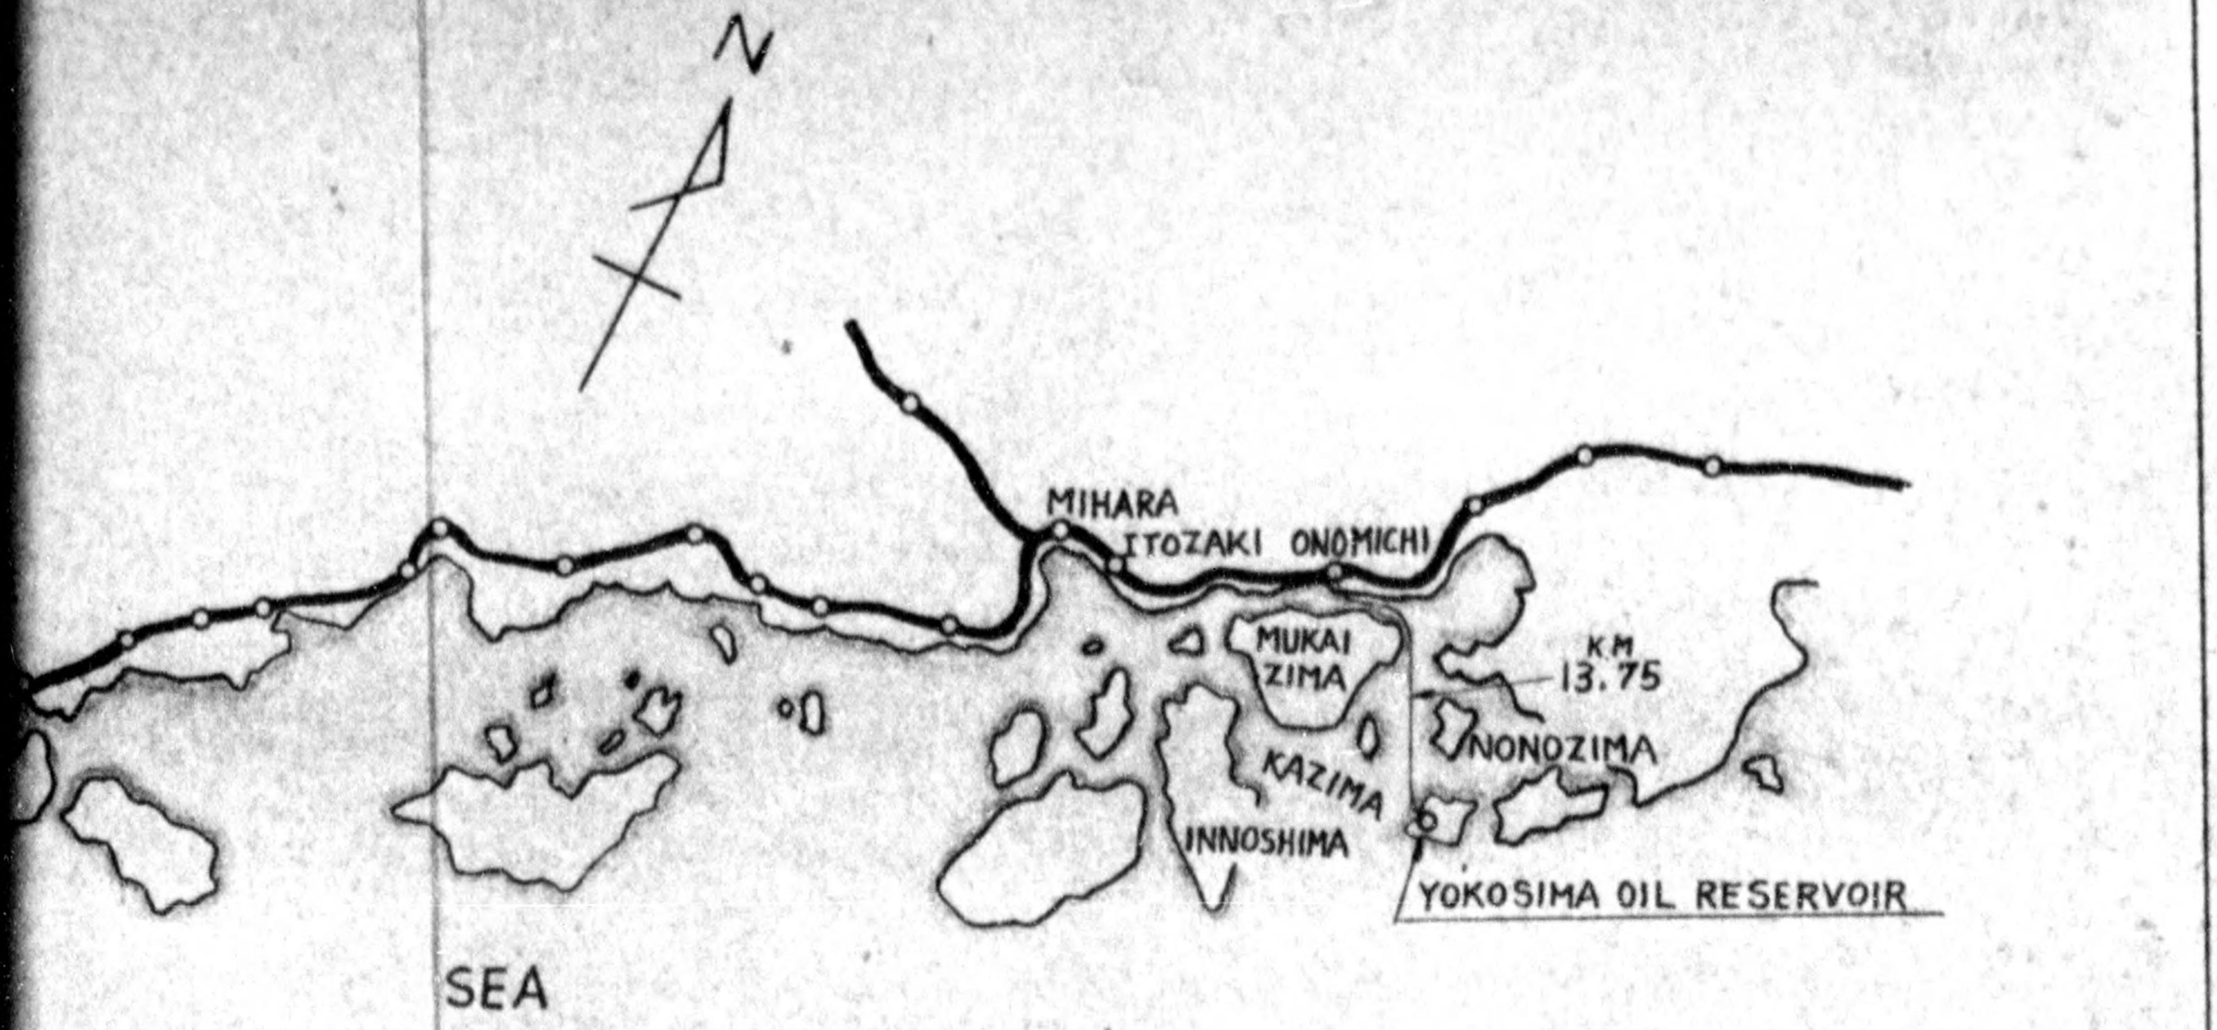

NAME OF EQUIPMENT	LOCATION	TYPE	CAPACITY	NO. OF EQUIPT	REMARKS
GASOLINE TANKS		ABOVE GROUND STEEL	81,900 Barrels 13,000 KL	11	
KAGANO, PUMP (GASOLINE)			78,000 gal/hr 300 T/HT	1	DRIVEN BY 150HP MOTOR
CENTRIFUGAL PUMP (WATER)			" 300 T/HT	1	DRIVENBY 100HP MOTOR
"			39,000 gal/hr 150 T/HT	1	DRIVENBY 80HP MOTOR
CENTRIFUGAL PUMP (FOAMITE)			78,000" 300 T/HT	2	DRIVENBY 150HP MOTOR
FOAMITE TANKS			22 Barrels 3.5 K.L	8	
PIPES A ----	UNDER GROUND	GAS PIPE	6"	852ft	
PIPES B ----	"	"	"	459ft	
PIPES C ----	"	"	"	3020ft	
	IN PUMPROOM	"	10"	360ft	
	"		8"	328ft	
	WITH TANKS		3"	1950ft	
VALVES	WITH TANKS	ATOMOTH SLUICE	6"	33	
	"	"	10"	15	
	"	"	8"	7	
	"	"	6"	6	
	"	"	4"	19	
	"	"	3"	8	

NOTE :
---------- SHOWS REMOVED PIPE
———— SHOWS GASOLINE PIPE
( ) SHOWS no of reparations machineries

328' 100 M

DECLASSIFIED E.O. 12065 SECTION 3-402 / NNDG NO: 779813

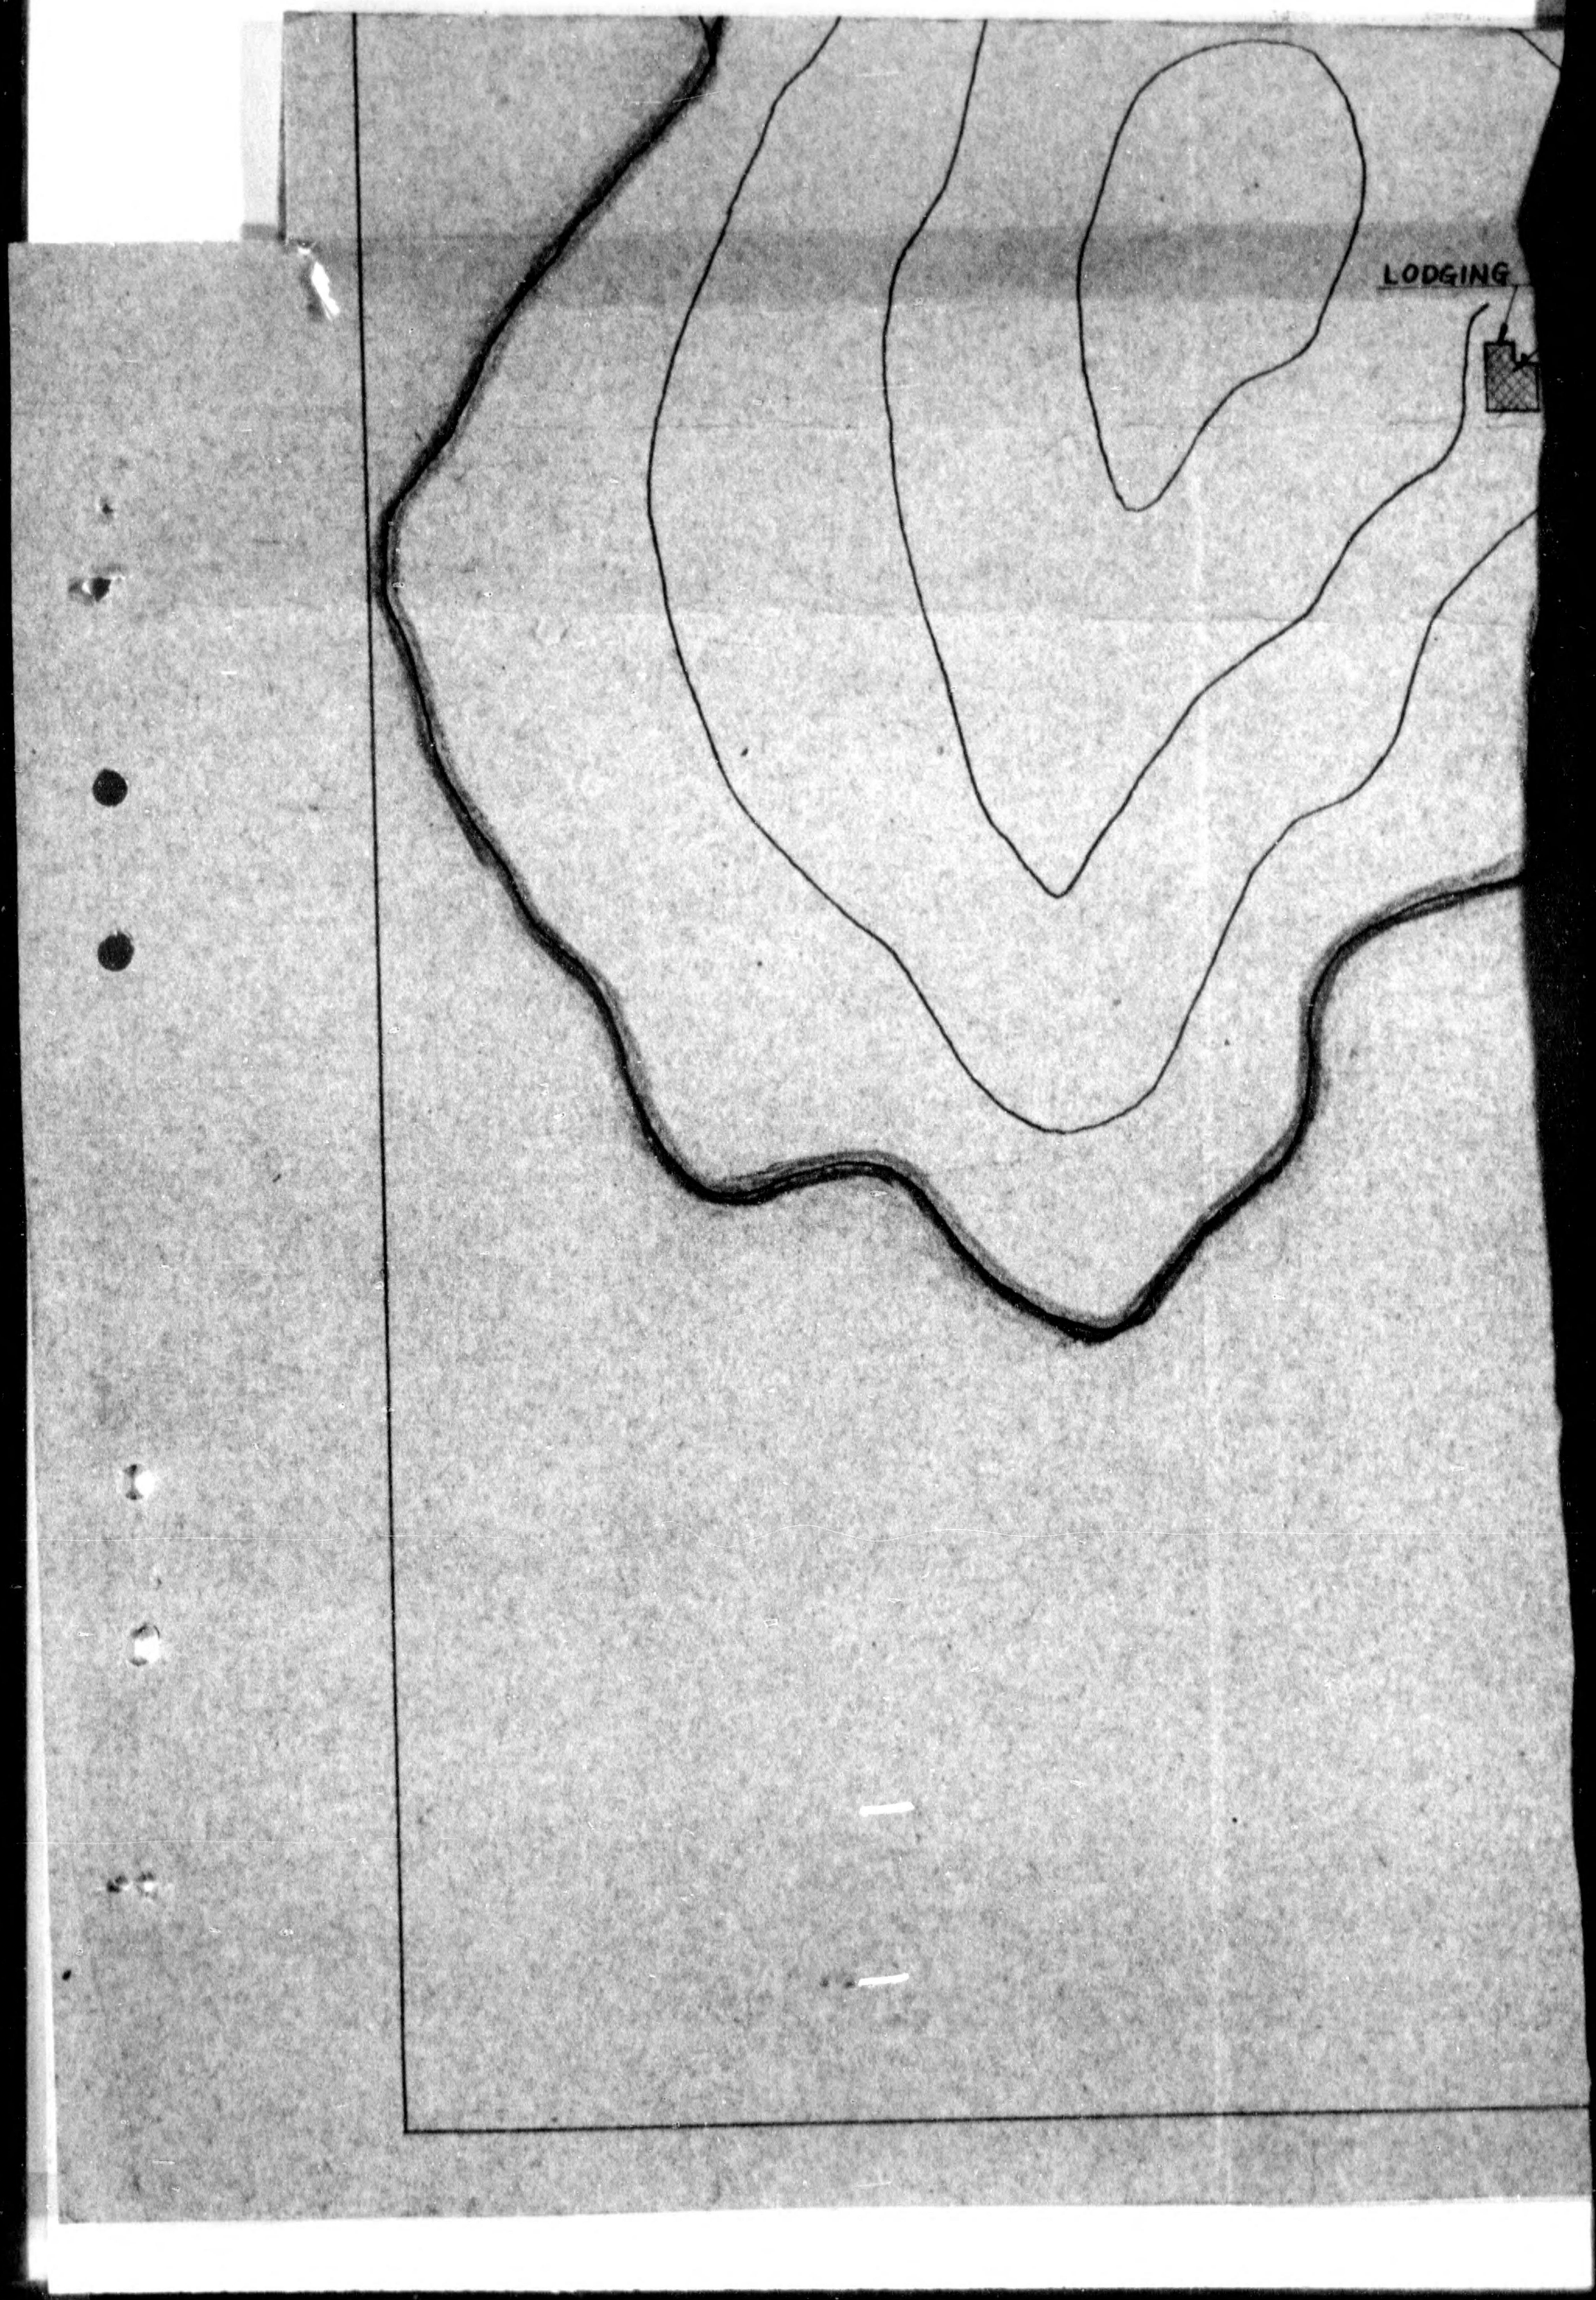

DECLASSIFIED E.O. 12065 SECTION 3-402 / NNDG NO. 119913

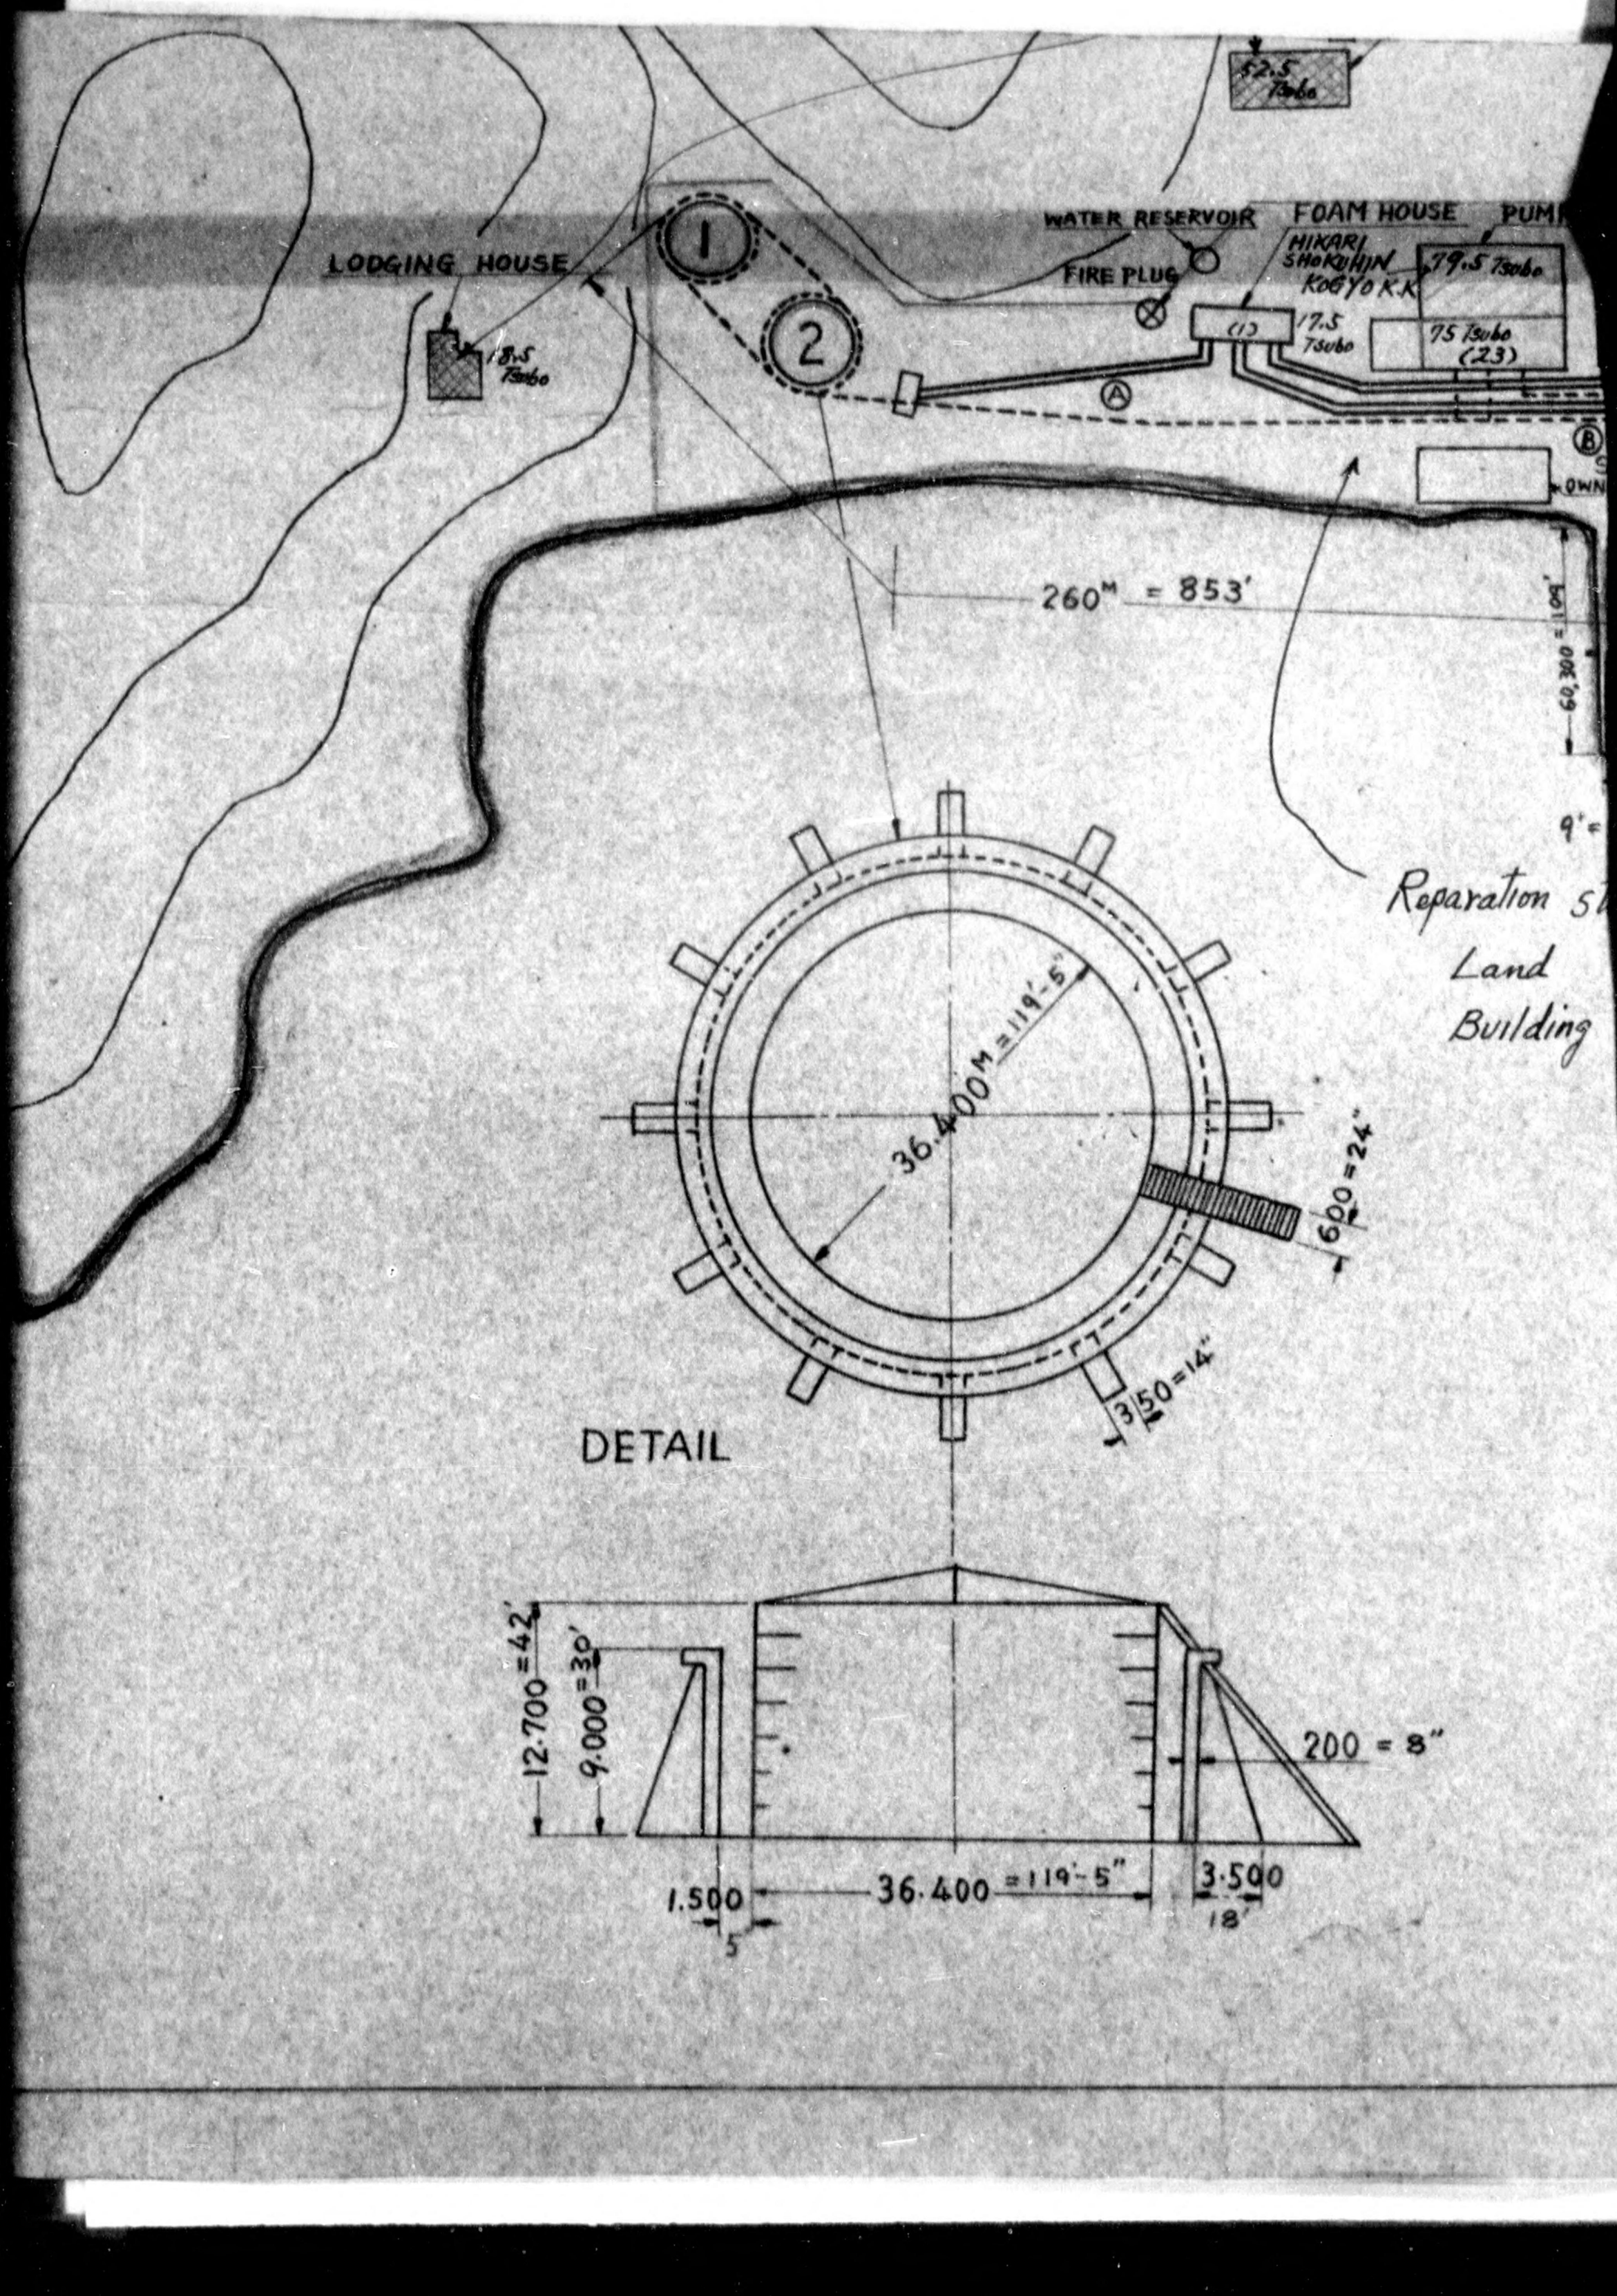

DECLASSIFIED E.O. 12065 SECTION 3-402 / NNDG NO. 119913

FOAM HOUSE
PUMP HOUSE
WATER RESERVOIR
77.5 Tsubo
18.9 Barrels
3,000 M
KARI
KOGYO K.K
17.5 Tsubo
75 Tsubo (23)
SHRIMP HOUSE
OWNED BY YAMANAKA SEIFUN
15.5'
4.750 M
4.150 = 13.5'
60.300 = 198'
5.200
8.700
28'
(B) PIER
32.500 = 107'
9' = 2.7 M AT LOW TIDE
270 M = 885'
800 M = 2624'
600 = 24"
200 = 8"
(A)
10
8
9
3"
6"
3
4
5
6
6"
8"
7
4"
10"
©

Reparation store Area
Land 29,550 Tsubo
Building 172 Tsubo

SEA

DECLASSIFIED E.O. 12065 SECTION 3-402 / NNDG NO: 119919

VALVES	WITH TANKS	ATOMOTH SLUICE

NOTE :

---------- SHOWS R

———— SHOWS G

( ) SHOWS n

10

8

9

3"

4"

10"

800M =2,624'

200M=656'

170M=558'

250'=14

2650'=4'

(A)PIER (B)

25'-3"
7.7M AT LOW TIDE

100 ft

36 1/ft

(A)

(A)

AS OF 8 SEPTE

OIL RESER

FACILITY CODE NO (11-37)

FACILITY NAME YOKOSIMA O

FACILITY ADRESS OHAMA YOKOSIMA

SCALE 1/850

KURE BRANCH HIROSIMA FINANCE BUREAU	DRAWING COMPL 8 SEPTENBER

Y. OKAMOT

DECLASSIFIED E.O. 12065 SECTION 3-402 / NNDG NO: 119815

VALVES	WITH TANKS	ATOMOTH SLUICE "	8" 10" 8"	5 15 7	
		" " "	6" 4" 3"	6 19 8	

NOTE:
---------- SHOWS REMOVED PIPE
———— SHOWS GASOLINE PIPE
( ) SHOWS no of reparations machineries

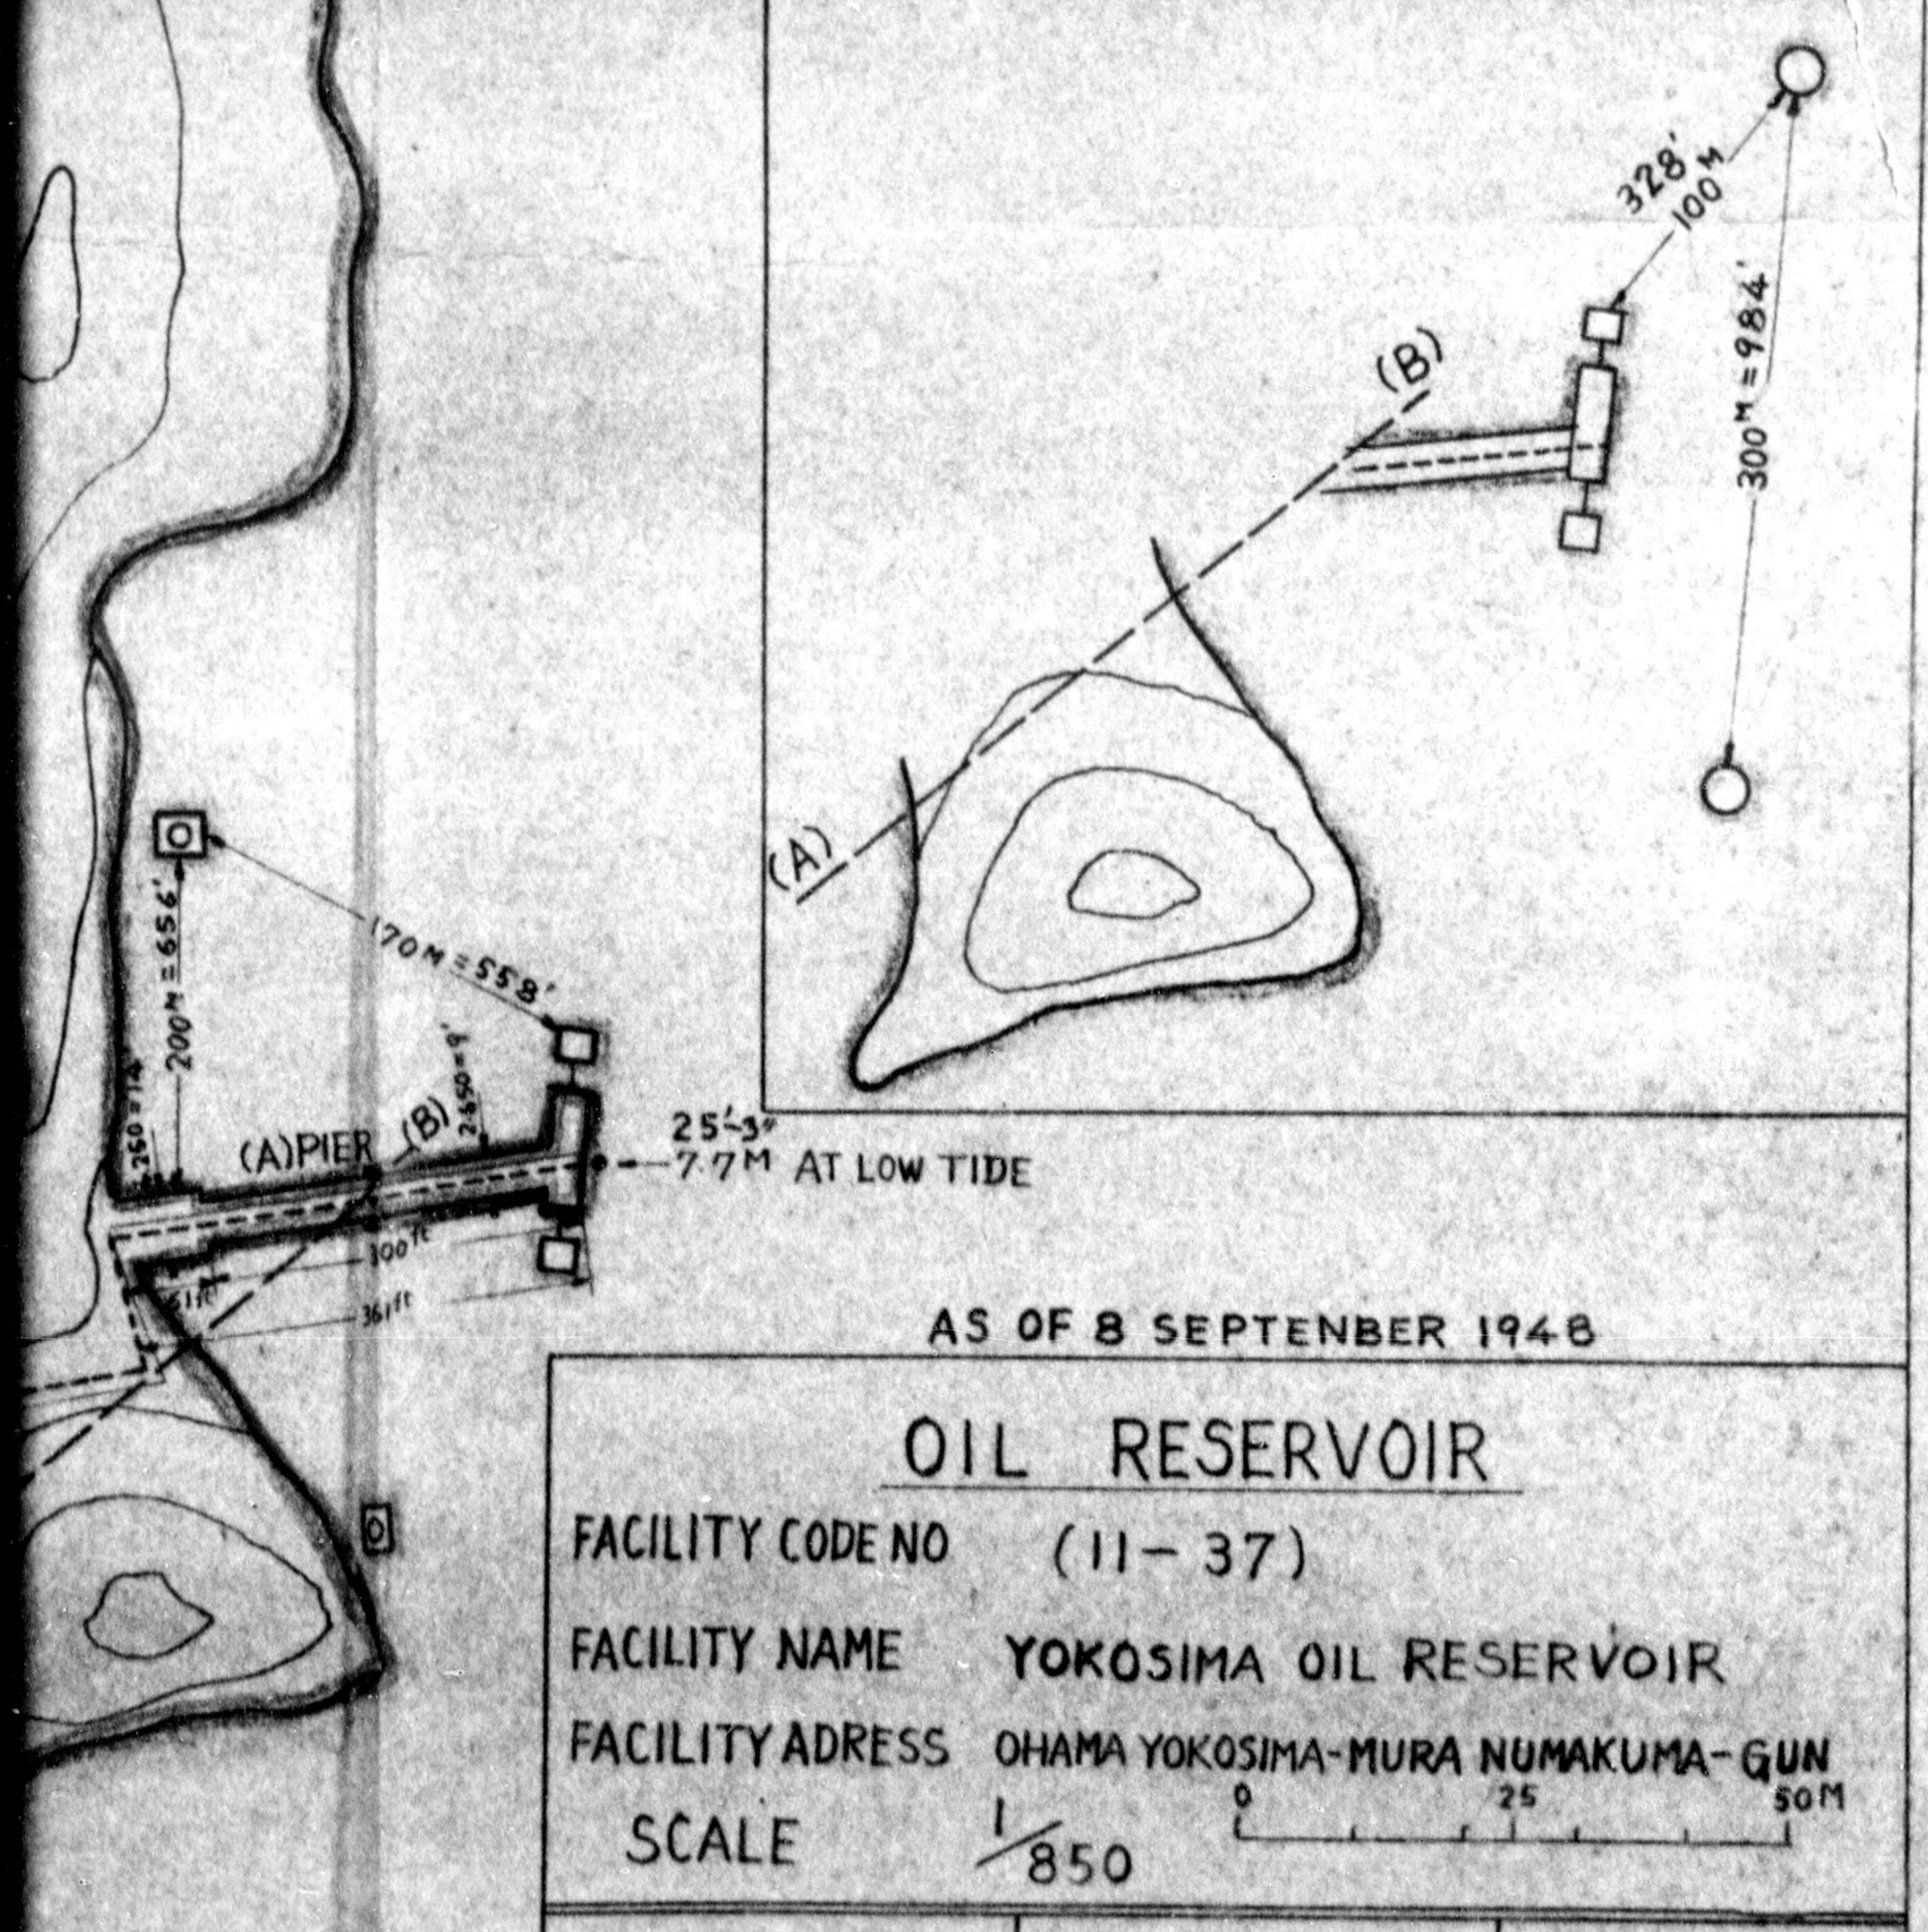

AS OF 8 SEPTENBER 1948

OIL RESERVOIR

FACILITY CODE NO (11-37)

FACILITY NAME YOKOSIMA OIL RESERVOIR

FACILITY ADRESS OHAMA YOKOSIMA-MURA NUMAKUMA-GUN

SCALE 1/850 0 25 50M

KURE BRANCH HIROSIMA FINANCE BUREAU	DRAWING COMPLETION 8 SEPTENBER 1948	DRAWING NO 96

Y. OKAMOTO

DECLASSIFIED E.O. 12065 SECTION 3-402 / NNDG NO. 779975

N O T E S

1. _____ Boundary-line at the time custody transferred from Army.

2. ☐ Released area.

3. ▒ Existing released bldg.

4. ☐ Area required for reparation dead storage. (177,716.3 tsubo)

5. ▒ Bldg. required for reparation dead storage.

6. ☐ Area & bldg. in use by converted plant. (3,092 tsubo)

7. ▨ Area AU applied for by Nippo Kagaku (Chemical Industry) Co. (121,200 tsubo)
(All bldgs. in the same area on application for AU by the same Co.)

8. ▨ Area AU applied for by Nippon Kogyo Co. (71,200 tsubo)
(All bldgs. in the same area on application for AU by the same Co.)

9. ▩ Area or bldg. disposed of.

10. ☰ Released area leased to National Ry.

11. ▨ Leased teritory belonging to the Kos Oil Co.

12. Neither area nor bldg. in use by occupation forces.

13. Total acreage at the time custody transferred:-- 279,863.6 tsubo including leased area--5,104.6 tsubo.

14. Released area:--96,540 tsubo.

15. Area on application for release:--5,607.3 tsubo.

16. Released date & others of released bldg. are same as those for released area where bldg. exists.

DECLASSIFIED E.O. 12065 SECTION 3-402 / NNDG NO. 719015

N O T E S

1. _____ Boundary-line at the time custody transferred from Army.

2. [ ] Released area.

3. [ ] Existing released bldg.

4. [ ] Area required for reparation dead storage. (177,716.3 tsubo)

5. [ ] Bldg. required for reparation dead storage.

6. [ ] Area & bldg. in use by converted plant. (3,092 tsubo)

7. [ ] Area AU applied for by Nippo Kagaku (Chemical Industry) Co. (121,200 tsubo)
(All bldgs. in the same area on application for AU by the same Co.)

8. [ ] Area AU applied for by Nippon Kogyo Co. (71,200 tsubo)
(All bldgs. in the same area on application for AU by the same Co.)

9. [ ] Area or bldg. disposed of.

10. [ ] Released area leased to National Ry.

11. [ ] Leased teritory belonging to the Kos Oil Co.

12. Neither area nor bldg. in use by occupation forces.

13. Total acreage at the time custody transferred:-- 279,863.6 tsubo including leased area--5,104.6 tsubo.

14. Released area:--96,540 tsubo.

15. Area on application for relerse:--5,607.3 tsubo.

16. Released date & others of released bldg. are same as those for released area where bldg. exists.

DECLASSIFIED E.O. 12065 SECTION 3-402 / NNDG NO. 77-0-19

PLAN OF FOR

INVEN-TORY NO.	PLANT NO.	NAME OF PLANT
F1	/	LUBURICATING OIL PLANT
F1	5	VACUUM DISTILLATION PLANT (VADGERS)
F1	8	CONTACT RERUN PLANT
F1	10	ACID WASHING PLANT
F1	146	DRUM FILLING PLANT
F1	499	DRUM CLEANING PLANT
F2	/	CRUDE OIL DISTILLATION PLANT
F2	21	NNO TYPE (2 UNITS)
F3	34	HYDRO CRACKING PLANT
F4	25	WATER ELECTROLYSIS PLANT
F4	26	OXYGEN FILLING PLANT
F5	/	HYDROGEN PRODUCTION PLANT
F5	27	WATER GAS PLANT (P.G.C)
F5	28	METHANE CRACKING PLANT (KOPPERS)
F5	29	CO CONVERTER
F5	30	CO_2 REMOVING PLANT
F5	31	CO REMOVING PLANT
F5	32	NITROGEN GAS SEPARATION PLANT
F5	33	HYDROGEN PURIFICATION PLANT
F5	277	LIQUID AIR SEPARATION PLANT
F6	43	ALCOHOL PLANT
F7	499	DRUM MANUFACTURING PLANT ~~CRACKING PLANT~~
F8	4	CLAY TREATING PLANT FOR CRACKED GASOLINE
F8	48	CLAY DRYING FURNACE
F9	/	ISO-OCTANE PLANT
F9	39 40	BUTANOL DEHYDRO POLYMERIZATION PLANT

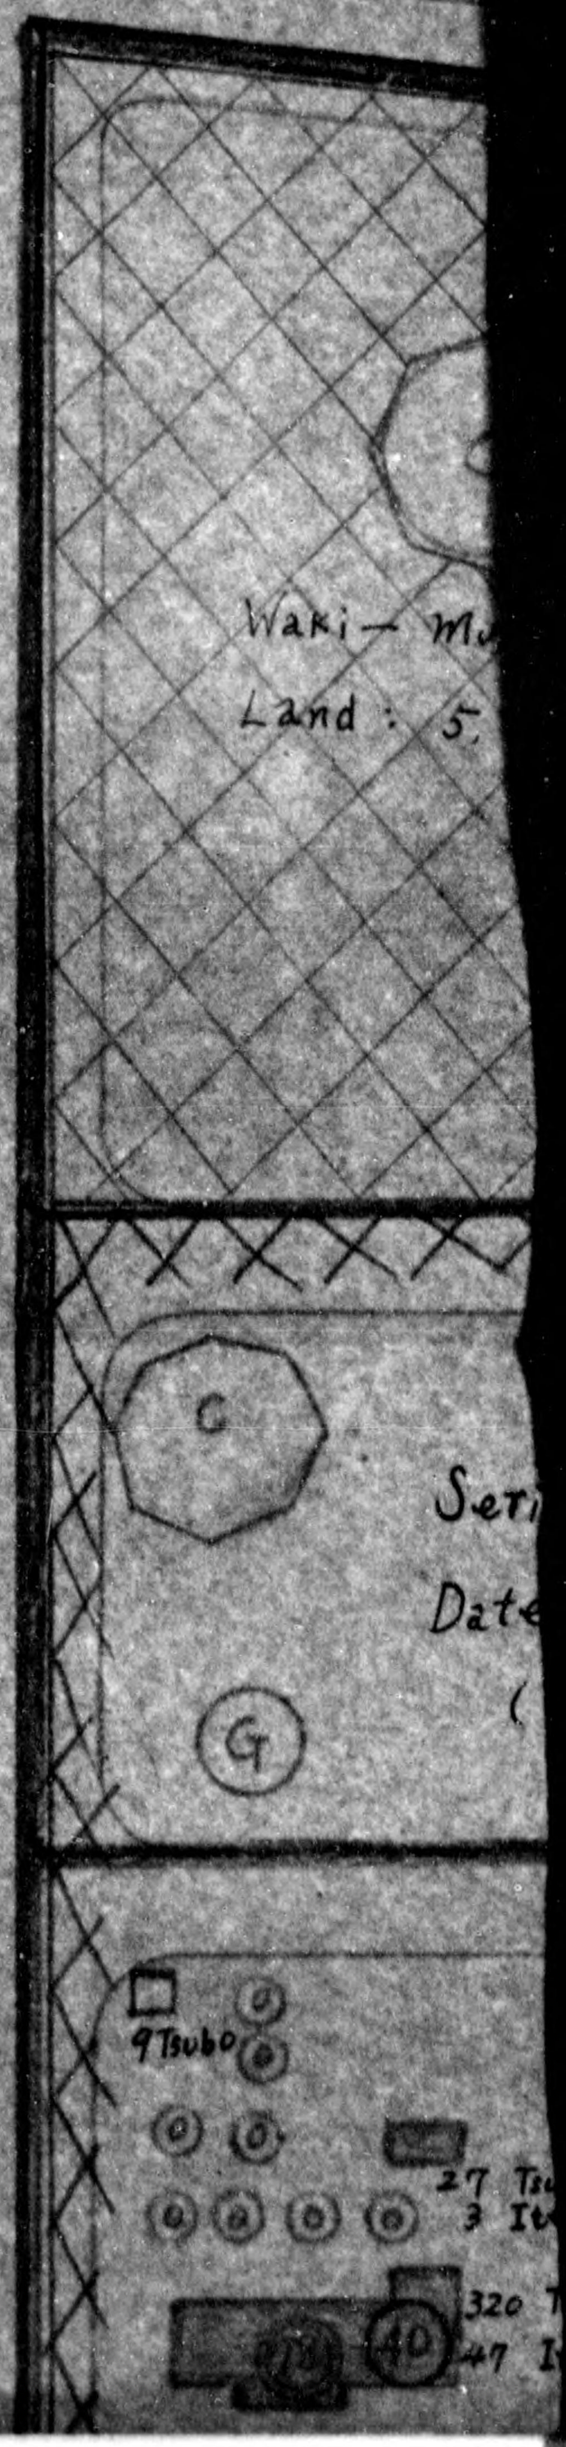

DECLASSIFIED E.O. 12065 SECTION 3-402 / NNDB NO.

...N OF FORMER IWAKUNI ARMY FU...

INDICATING INVENTRY NO. OF PLANTS

Shuto Kagaku
Co.
Land: 1360
Tsubo

Nichibei Hollow Tile Co.
Land: 2,312 Tsubo

Waki-Mura
Land: 5,760 Tsubo

Serial No. Unknown
Date Released 10 Feb, 1
(35,398 Tsubo)

720 Tsubo
[redacted]
(P)
(45)
C
Serial No. Unknown
XXI
Date Released 9. Aug 1948
(9,438 Tsubo)
G

(44)
[redacted] 47 Tsubo
[redacted] 18 Tsubo
(45)
XXII

9 Tsubo
242 Tsubo
24 Items
368 Tsubo
216 Items
(39)
(30)
27 Tsubo
3 Items
(42)
(43)
320 Tsubo
47 Items
(40)
XVII

(46) 234 Tsubo 48 Items
(47) 216 Tsubo 9 Items
(48) 216 Tsubo 72 Items
(49) 402 Tsubo 48 Items
(44)
(P)

DECLASSIFIED E.O. 12065 SECTION 3-402 / NNBG NO. 178015

FUEL DEPOT

NTS

SCALE 1/2000

b, 1948

XXIII

36

420 Tsubo
17 Items

98

47 Tsubo
(Burend)
24 Items

93.5 Tsubo
(Burend)
40 Items

97

1205 Tsubo
120 Items

34

XXII

XX

226 Tsubo
18 Items

228 Tsubo
9 Items

89

4 Tsubo

106

24 Tsubo

90

98 Tsubo

91

128 Tsubo
1 Items

DECLASSIFIED E.O. 12065 SECTION 3-402 / NNBG NO.

F9	41	NO.2 ISO-OCTANE PLANT
F10	/	SYNTHETIC LUB OIL PLANT
F10	42	PLANT FOR DESTRUCTIVE DISTILLATION OF RUBBER
F11	38	PRODUCER GAS PLANT
F12	37	HIGH PRESSURE EXPERIMENTAL PLANT
F13	46	STEAM BOILER PLANT (TAKUMA)
F14	45	HIGH PRESSURE STEAM BOILER PLANT (TAKUMA)
F15	55	WATER FEEDING PUMP PLANT
F16	50	SEA WATER PUMPING PLANT
F17	52	CRUDE OIL TREATING PLANT
F18	144	WASTE ACID TREATING PLANT
F19	57	5GALS. CAN MANUFACTORING PLANT
F20	246	5GALS CAN FILLING PLANT
F21	44	POWER STATION
1	1	ETHYL FLUID BLENDING PLANT
2	2	OIL BLENDING PLANT
3	3	CONTINUOUS GASOLINE TREATING PLANT
9	9	OIL TRANSMISSION INTERMEDIATE TANKS PLANT
11	11	CATALYTIC CRACKING PLANT (ARMY)
12	12	RERUN TOPPING PLANT
13	13	PARAFFINE CRACKING
14	14	OLEFFINE POLYMERIZATION PLANT
15	15	CONTACT RERUN PLANT FOR POLY PLANT
16	16	TANK AND PUMP FOR ABOVE PLANT
17	17	NO.1 ISO-OCTANE PLANT
18	18	GAS SEPARATION PLANT
19	19	SPECIAL EMULSION PLANT
20	20	PROPANE REFINING PLANT
22	22	THERMAL CRACKING PLANT, NNC ~~NNC THERMAL TYPE~~ (2 UNITS)
23	23	CATALYTIC CRACKING PLANT (NNK)
24	24	PITCH COKE PLANT
35	35	HIGH PRESSURE HYDROGENATION PLANT
36	36	SOLVENT EXTRACTION PLANT (EDELEANU)
47	47	ELECTRIC SUBSTATION PLANT
49	49	CATALYSER MANUFACTURING PLANT
53	53	PUMPING AND DRAINING PLANT
6	6	SOLVENT EXTRCTION PLANT (DUO-SOL)

(49) PLANT NO

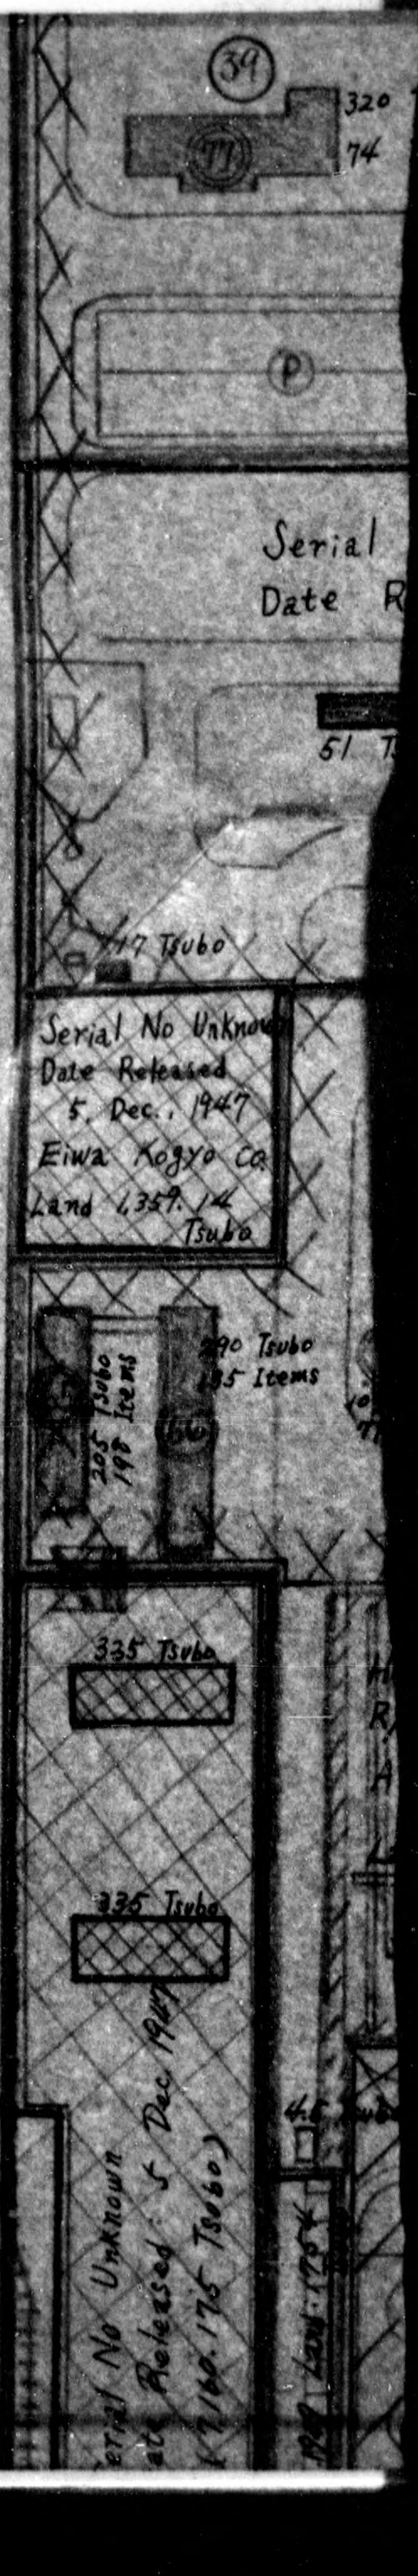

DECLASSIFIED E.O. 12065 SECTION 3-402 / NNBG NO:

39 320 Tsubo 74 Items 77
41 91 Tsubo 31
38 32 201 Tsubo 7 Items
XVIII
P 107 15 Tsubo 5 Items
55 220 Tsubo 2 Items
3 219 Tsubo 39 Items 17
19 22 Tsubo 7 Items
27 20 538 Tsubo 143 Items
21
28 35 Tsubo
22
152 Tsubo 20 Items
V
24 28 Tsubo 1 Items
23 250 Tsubo
G
Serial No Unknown
Date Released 10 Feb. 1948
(10,157.95 Tsubo)
51 Tsubo
P
90 Tsubo 2 Items 18
65.5 Tsubo 262 Items
17 25
26
12 Items
9 33 Tsubo
25 80 Tsubo 13 Items
G
7 Tsubo
No Unknown
eleased
ec., 1947
Kogyo Co.
357.14 Tsubo
P
19 tsubo
24 Tsubo 12 Items
472 Tsubo 618 Items
6
10
4
57
II
5
271
7
154 Tsubo 49 Items
109 Tsubo 77 Items
8
3 Tsubo
P
290 Tsubo 195 Items
66
10.5 Tsubo
13
Hiroshima Ry. Division AU
Land 1,000 Tsubo
III
49
11
1,536 Tsubo 221 Items
12
31 Tsubo 1 Items
4.6 Tsubo
Tsubo
Tsubo
Released 5 Dec 1947
(1,160.175 Tsubo)
Land 1,254
26 63 Tsubo
74 Tsubo 12 Items
28
6 Items
238 Tsubo 68 Items
55
845 Tsubo 9 Items
36
16.5 Tsubo
37
VI
34
9 Tsubo 3 Items
33
21 Tsubo 3 Items
32
22
23
91.5 Tsubo 6 Items
31
88 Tsubo 11 Items
29
3 Items
30
3 Items
73 Tsubo 41 Items
56
6
38
50.5 Tsubo 7 Items
39
221 Tsubo 45 Items
C
40
7
1,326 Tsubo 77 Items
9
VII
41
66 Tsubo 16 Items
58
148 Tsubo 23 Items
45
5
P
44
30 Tsubo 26 Items
43
10
54 Tsubo 11 Items
42
8
70 Tsubo 18 Items
4
3
46
70 Tsubo

DECLASSIFIED E.O. 12065 SECTION 3-402 / NNSG NO. 7

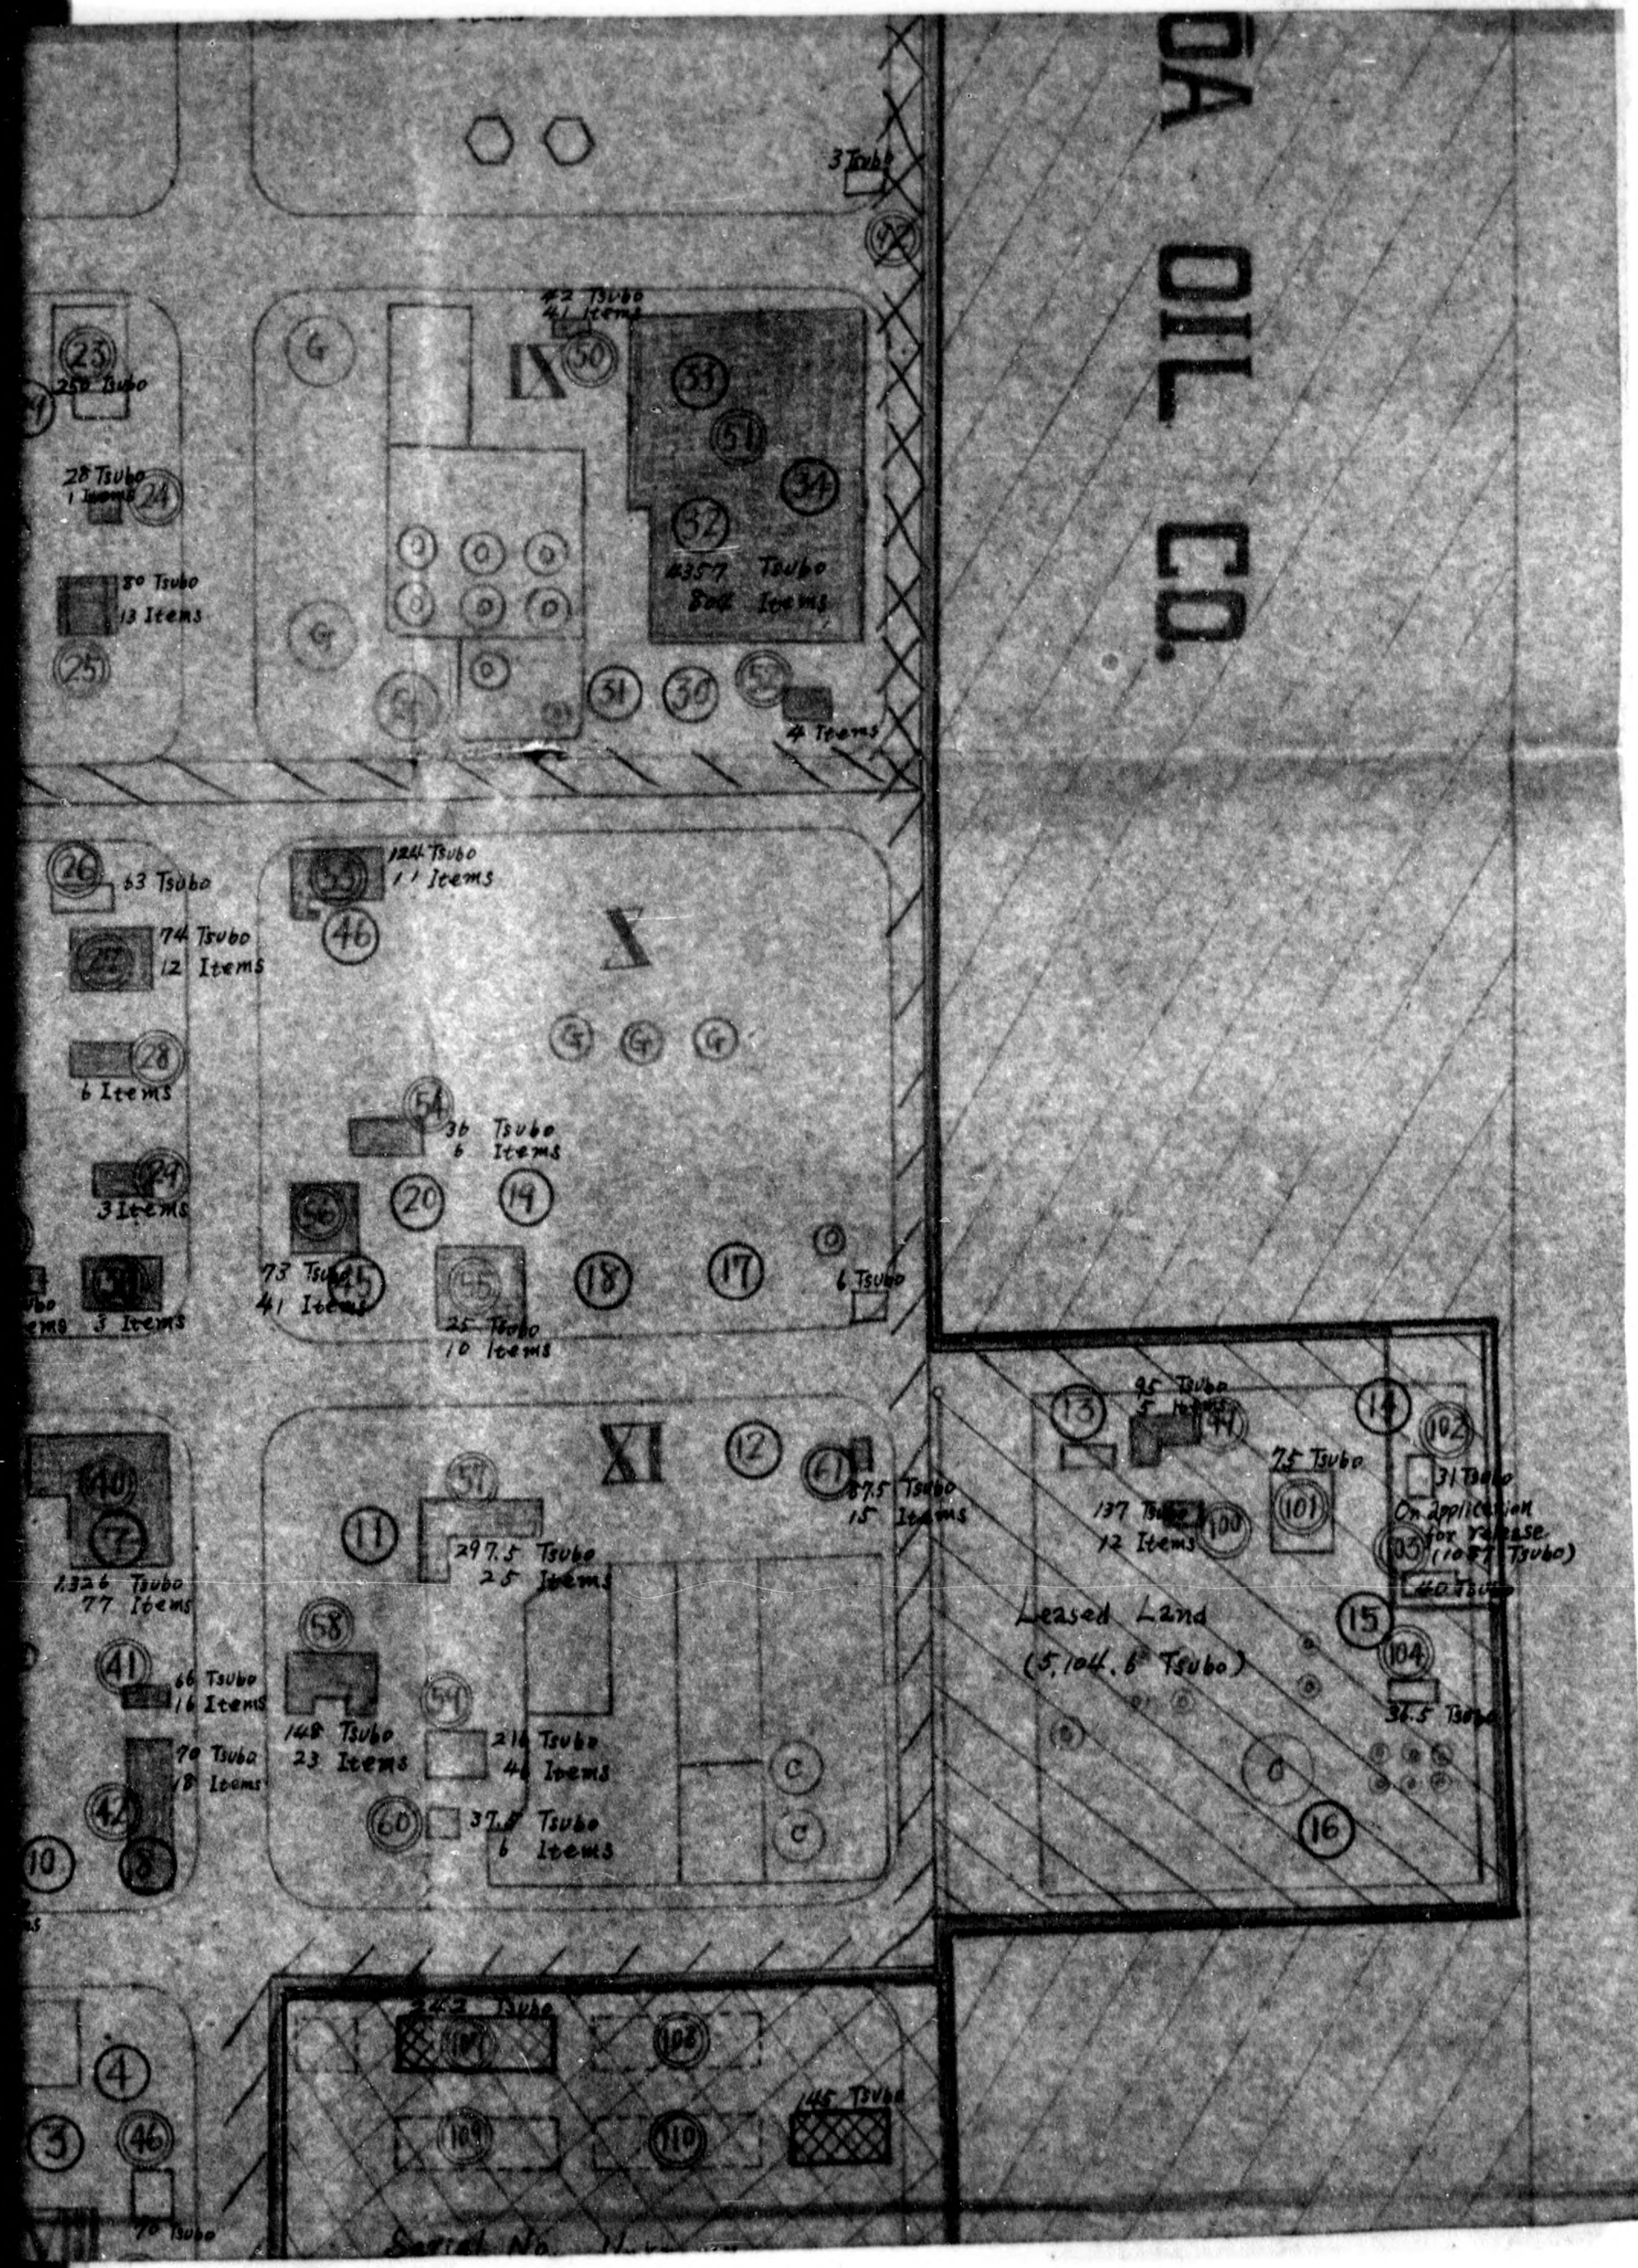

DECLASSIFIED E.O. 12065 SECTION 3 402 / NNSG NO. 1

35	35	HIGH PRESSURE HYDROGENATION PLANT
36	36	SOLVENT EXTRACTION PLANT (EDELEANU)
47	47	ELECTRIC SUBSTATION PLANT
49	49	CATALYSER MANUFACTURING PLANT
53	53	PUMPING AND DRAINING PLANT.
6	6	SOLVENT EXTRCTION PLANT (DUO - SOL)
7	7	DEWAXING PLANT (BARI - SOL)

(12) : PLANT NO

(5) : BUILDING NO.

(P) : POOL

(C) : CPC TANK
(O) : OIL TANK
(G) : GAS TANK

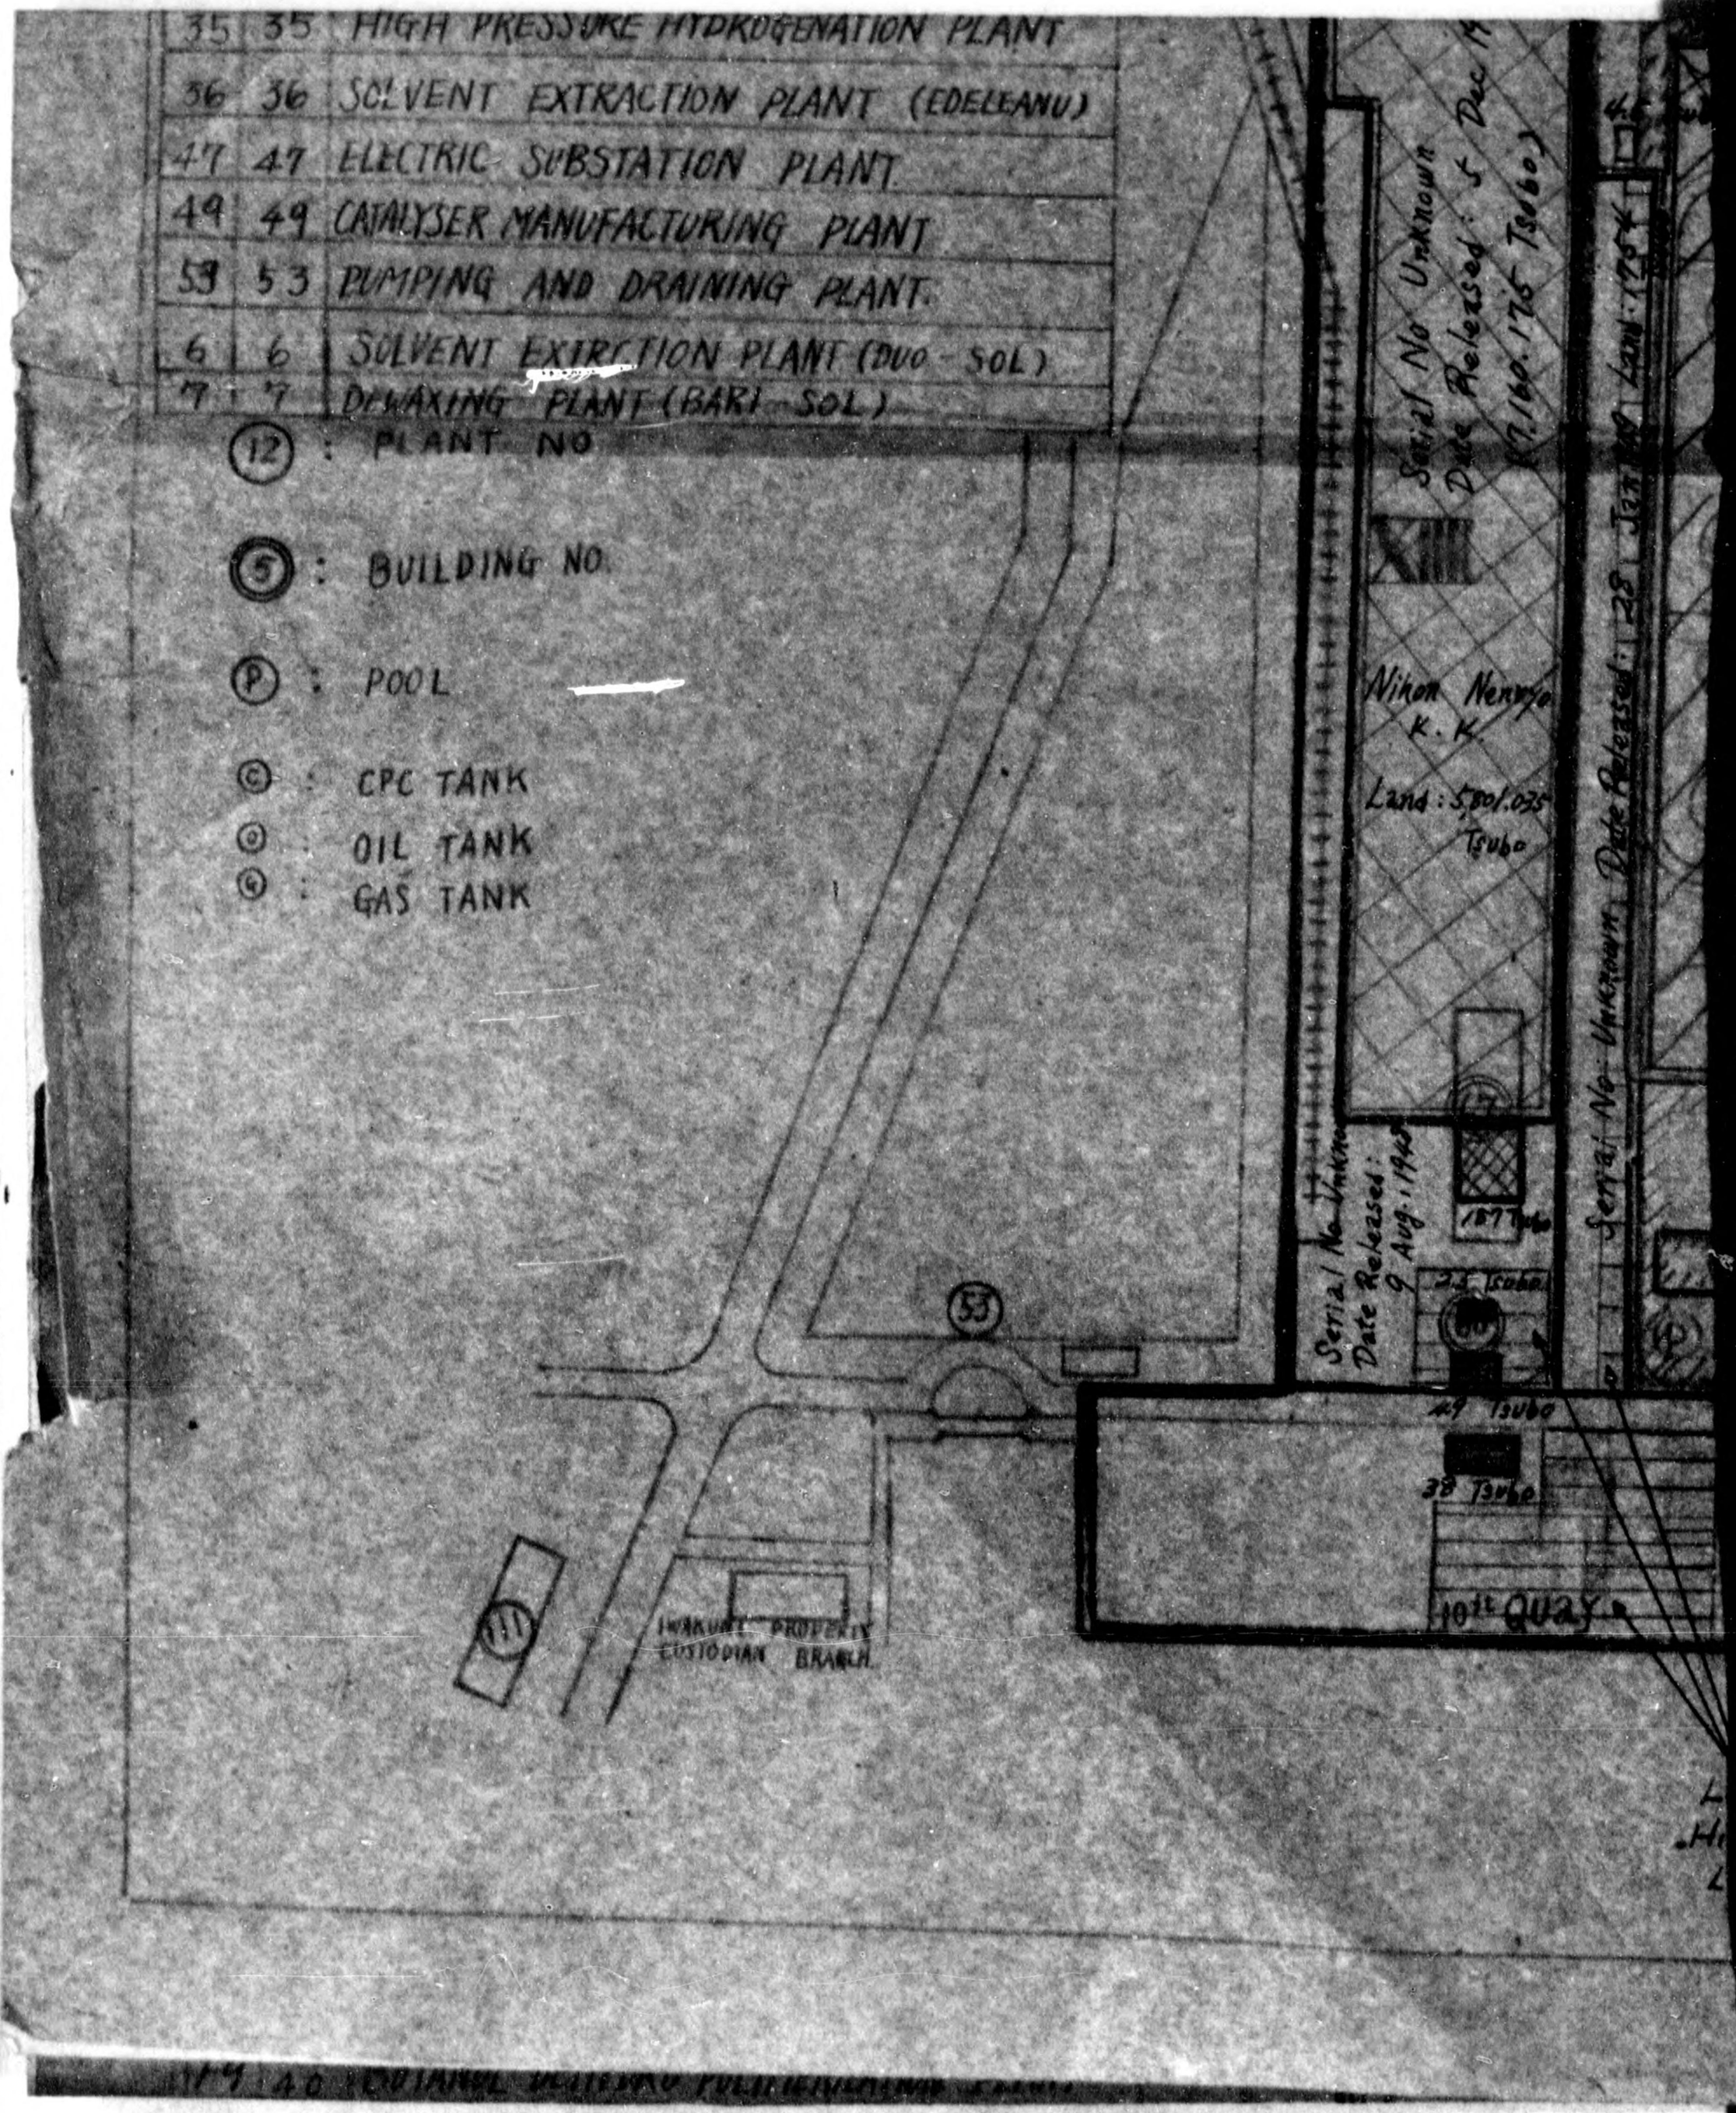

DECLASSIFIED E.O. 12065 SECTION 3 402 7 NARS DATE

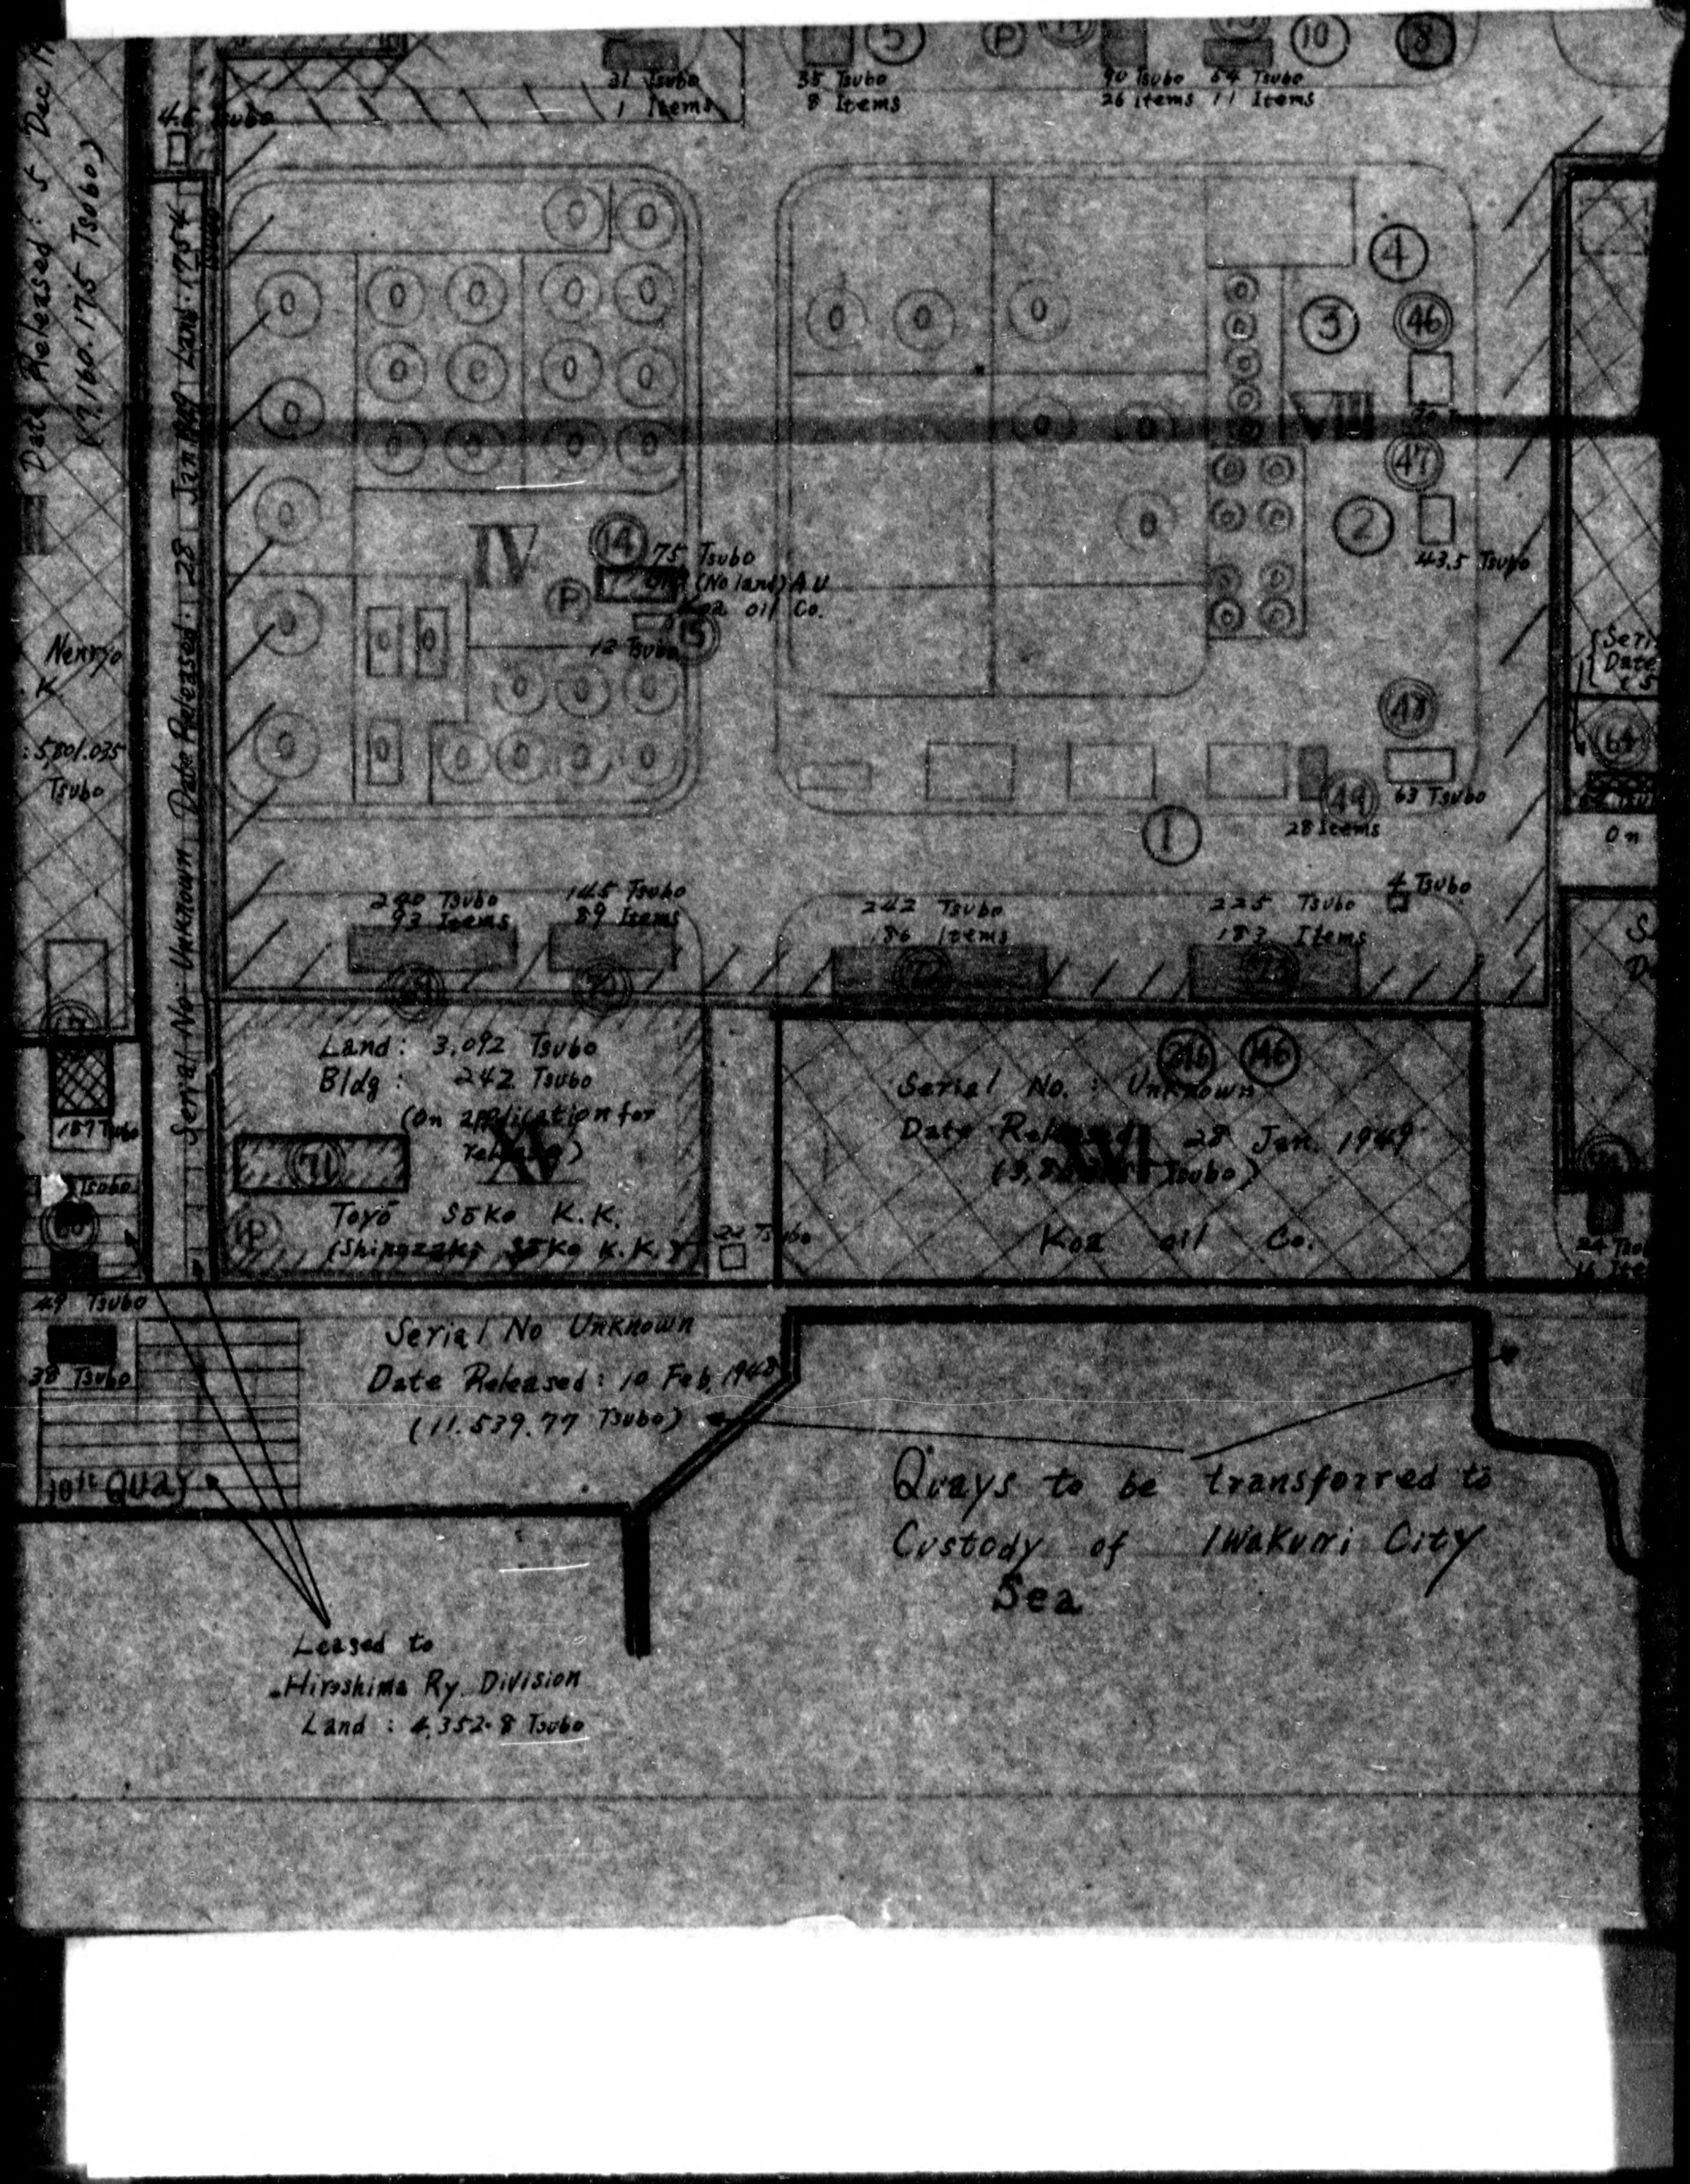

DECLASSIFIED E.O. 12065 SECTION 3 NSC 7 NARS DATE 7/10/80

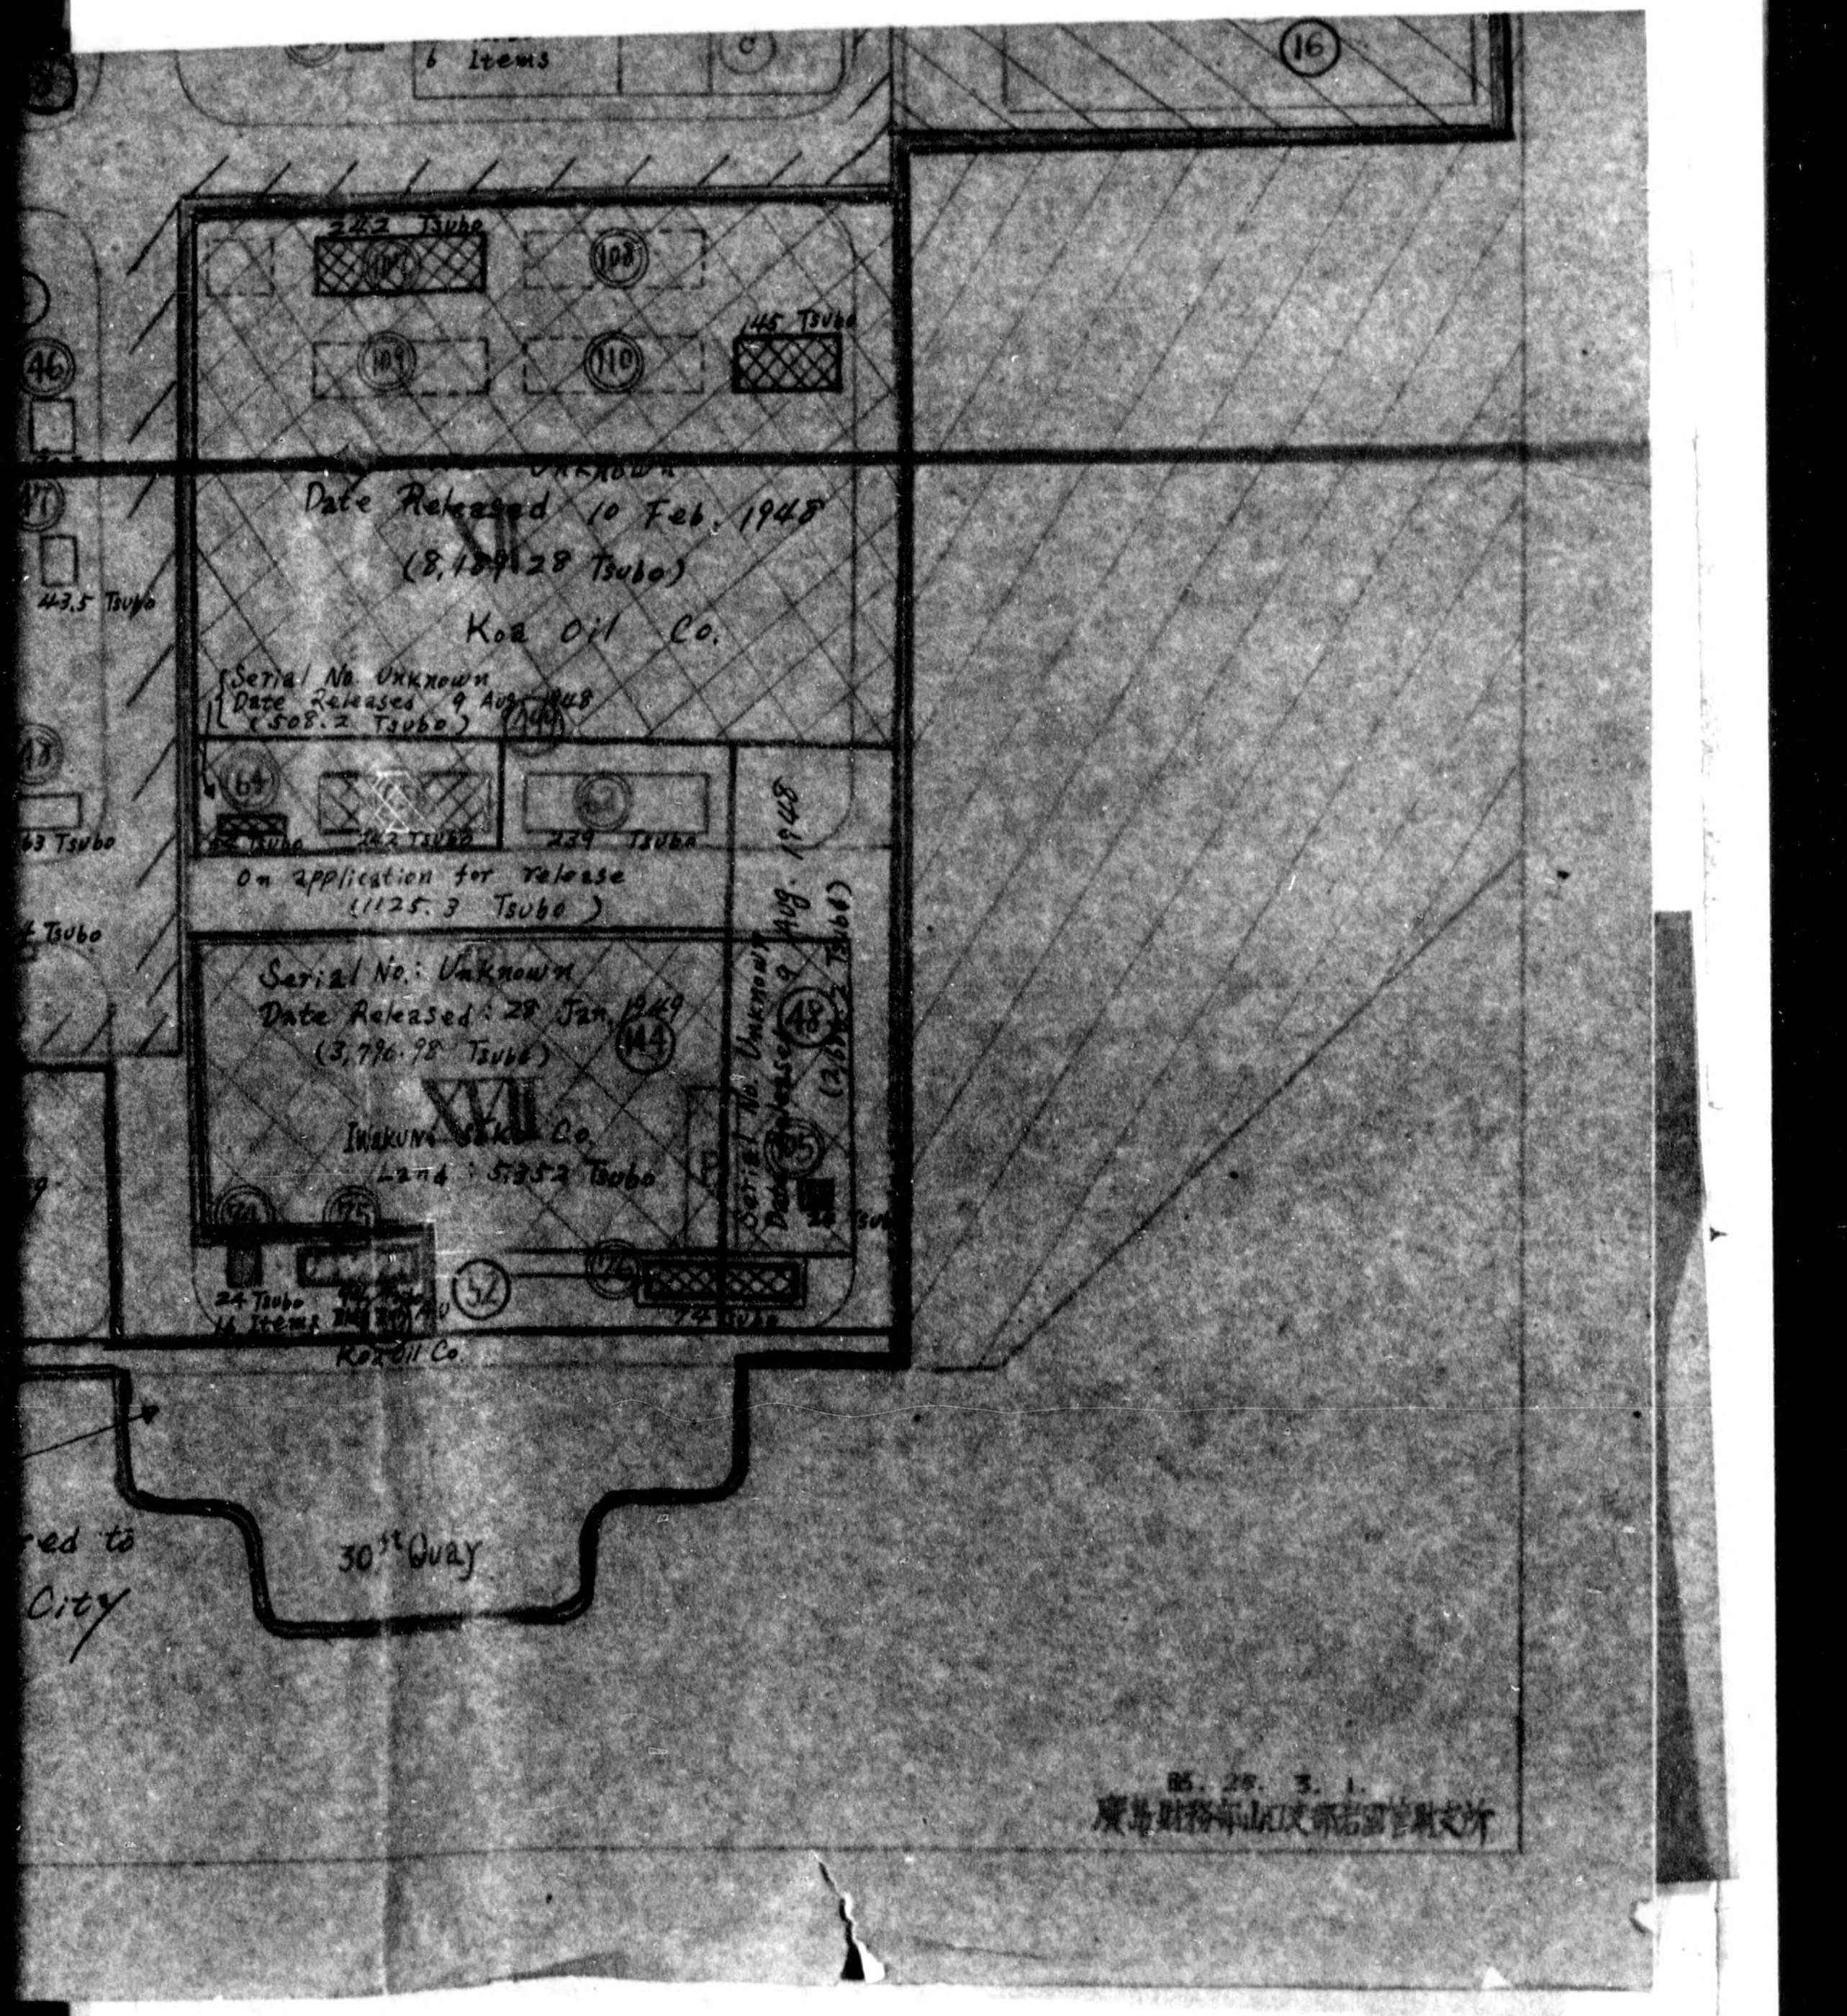

85. 28. 3. 1.

DECLASSIFIED E.O. 12065 SECTION 3 Vol 7 NARS Date 11-20-80

Map of Reparation Arsenal

1. Total acerage which was transferred from Ex-Navy (inside of black line):

214,490 tsubo

2. Areas not released:

113,618 tsubo

3. Buildings not released:

Attached paper No. 1

4. Areas released (land, inside of blue line):

100,872 tsubo
(attached paper No. 2)

5. Buildings which were released and remain (blue colour):

Attached paper No.3

6. Areas required for reparation dead storage:

97,818 tsubo

7. Buildings required for reparation dead storage:

Attached paper No. 4

8. Areas in Use by Occupation Forces:

None

9. Buildings in Use by Occupation Forces:

None

10. Areas in Use by Japanese Private Companies:

None

11. Areas on application for Use by Japanese Private Companies: (insid of red coloured oblique line):

Attached paper No. 5

12. Areas sold to Private Companies: (inside of blue coloured oblique line):

Attached paper No. 5

DECLASSIFIED E.O. 12065 SECTION 3 NSC 7 MAR 80

Attached paper: No. 1

8 Buildings not released

Bldg. No.	Acreage (tsubo)	Bldg. No.	Acreage (tsubo)
1	1st floor: 1 2nd floor: 1	61	1st floor: 22 2nd floor: 13
2	40	62	1
3	[illegible]	63	1st floor: 64 2nd floor: 37
4	2	64	20
5	40	65	1st floor: 69 2nd floor: 69
6	1st floor: 49 2nd floor: 49	68	21
7	2	69	25
8	1st floor: 10 2nd floor: 3	70	18
13	1st floor: 70 2nd floor: 69	72	2
15	1st floor: 87 2nd floor: 67	73	1st floor: 91 2nd floor: 91
16	1	74	4
17	1	75	3
18	32	76	6
19	7	78	1st floor: 34 2nd floor: 34
47	1st floor: 3 2nd floor: 1	80	1st floor: 47 2nd floor: 42
53	1st floor: 91 2nd floor: 90	81	308
55	1st floor: 31 2nd floor: 28	84A	2
56	2	85	96
57	5	87	1st floor: 2 2nd floor: 2
59	12	88	3

DECLASSIFIED E.O. 12065 SECTION 3 NARS NO.

Attached paper: No.1 (Continued)

Bldg. No.	Acreage (tsubo)	Bldg. No.	Acreage (tsubo)
89	19	139	71
90	1st floor: 91 2nd floor: 26	141	5
		149	18
91	60	150	1
92	2	151	16
97	6	152	3
100	51	155	2
107	7	169	116
110	140	170	178
113	2	171	26
114	15	172	1st floor: 189 2nd floor: 189 3rd floor: 187
115	2		
116	3	173	183
117	132	175	67
118	80	20	2
119	279	25	16
120	2	26	58
121	2	29	22
125	116	30	2
126	41	32	2
127	35	34	48
129	12	37	1st floor: 95 2nd floor: 97
132	2	38	1st floor: 71 2nd floor: 71 3rd floor: 18
135	41		
136	15		
137	2	39	121
138	2		

DECLASSIFIED E.O. 12065 SECTION 3 NSC MEMO

Attached paper: No. 1 (continued)

Bldg. No.	Acreage (tsubo)	Bldg. No.	Acreage (tsubo)
40	1st floor: 84 2nd floor: 85	43	3
41	4	45	1st floor: 20 2nd floor: 15

(End)

Attached paper: No. 2

4. Areas released (land, inside of blue line)

Area	Acreage (tsubo)	Date released	Officer concerned
A	5004	Jan. 21. 1948.	Major Alfred P. Robertson
B	10374	Nov. 29. 1947.	Major Francis T. Justis
C	3105	Jan. 12. 1948.	Capt. Richard P. Bhdwich
D	3379	"	"
E	6755	May 12. 1948.	Major Fredric C. Wiggins
F	28080	Feb. 9. 1948. Aug. 9. 1948.	"
G	21004	Feb. 9. 1948. Aug. 9. 1948.	"
H	6508	Nov. 29. 1947.	Major Francis T. Justis
I	5299	Aug. 13. 1947.	"
J	11364	Feb. 9. 1948.	Major Alfred P. Robertson

Attached paper: No. 3

5. Buildings which were released and remain (blue colour)

Bldg. No.	Acreage (tsubo)	Bldg. No.	Acreage (tsubo)
1	23	26	57
2	493	27	30
3	1st floor: 45 2nd floor: 45	28	60
4	7	29	130
5	114	30	4
6	120	31	23
7	120	32	34
8	320	33	2
9	91	34	7
10	80	35	60
11	130	36	37
12	70	37	22
13	267	38	8
14	121	39	1st floor: 28 2nd floor: 28
15	181	40	182
16	217	41	198
18	109	42	82
19	205	43	43
20	30	44	12
21	12	45	2
22	2	46	1st floor: 52 2nd floor: 41
23	1st floor: 209 2nd floor: 85	47	7
24	1st floor: 204 2nd floor: 62	48	90
25	83	49	105
		50	98

Attached paper: No. 3 (continued)

Bldg. No.	Acreage (tsubo)	Bldg. No.	Acreage (tsubo)
51	98	56	143
52	126	57	72
53	48	58	1.5
54	48	59	272
55	890		

Attached paper : No. 3
(continued)

Date released	Officer concerned	Bldg. No.
Jan. 21. 1948.	Major Alfred P. Robertson	1, 2, 3.
Nov. 29. 1947.	Major Francis T.Justis	4,5,6,7,8.
Jan. 12. 1948.	Capt. Richard P. Bradwich	9,10,11,12.
May 12. 1948.	Major Fredric C. Wiggins	13,14,15,16.17,18,19,20.
Feb. 9. 1948. Aug. 9. 1948.	"	21,22,23,24,25,26,27,28, 29,30,31,32,33,34,35,36,37,38, 39,40,41.
Nov. 29. 1947.	Major Francis T. Justis	42,43,44,45,46,47,48,49,50,51 52,53,54.
Aug. 13. 1947.	"	55,56,57,58,59

Attached paper: No. 4

7. Buildings required for reparations dead storage

Bldg. No.	Number of machines stored	Acreage (tsubo)	Bldg. No.	Number of machines stored	Acreage (tsubo)
9	78	298	33	12	1st floor: 293 2nd floor: 153
10	9	101	35	26	1st floor: 92 2nd floor: 69 3rd floor: 30
11	17	135			
12	24	144	36	3	10
14	28	44	42	20	32
21	7	52	44	13	36
22	101	1st floor: 326 2nd floor: 133	46	11	45
23	6	24	48	19	174
24	12	30	49	8	188
27	269	1st floor: 174 2nd floor: 174 3rd floor: 174 4th floor: 85	50	11	45
			51	74	1st floor: 533 2nd floor: 321
28	8	76	52	10	32
31	16	101	54	4	31

Attached paper : No. 4 (continued)

Bldg. No.	Number of machines stored	Acreage (tsubo)	Bldg. No.	Number of machines stored	Acreage (tsubo)
58	9	50	93	71	98
60	14	200	94	2	21
66	2	1st floor: 113 2nd floor: 49	95	48	1st floor: 125 2nd floor: 41
67	1	1st floor: 268 2nd floor: 70	96	3	6
71	69	1st floor: 192 2nd floor: 95	98	5	15
77	48	1st floor: 278 2nd floor: 193	101	1	3
79	2	1st floor: 145 2nd floor: 76	102	10	25
82	13	112	103	28	128
83	1	30	104	7	59
84	6	46	105	6	50
86	2	1st floor: 47 2nd floor: 47 3rd floor: 47	106	10	59
			108	11	32
			109	3	140
			111	9	63

Attached paper: No. 4 (continued)

Bldg. No.	Number of machines stored	Acreage (tsubo)	Bldg. No.	Number of machines stored	Acreage (tsubo)
112	25	172	146	31	111
122	25	154	147	89	1st floor: 160 2nd floor: 49
123	127	304	148	5	102
124	34	255	153	228	906
128	3	15	154	49	892
130	16	50	156	14	222
131	6	118	157	15	396
133	6	402	159	40	105
134	2	12	167	10	176
140	15	1st floor: 92 2nd floor: 50	168	3	10
142	20	144	174	7	80
143	1	36	99	5	1st floor: 113 2nd floor: 35
144	12	29			
145	46	1st floor: 171 2nd floor: 86	Total	75 bldgs.	

Attached paper: No. 5

11. Areas on application for Use by Japanese Private Companies (inside of red coloured oblique line):

Area	Company made an application	Acreage of land (tsubo)	Bldg.
23	Tokuyama Teppan K.K.	4,300	5 bldg. 1,819 tsubo
15	Osaka Cork Industry Co. Ltd.	4,791	8 bldg. 512 tsubo

12. Areas sold to Private Companies (inside of blue coloured oblique line): (land & buildings)

Area	Acreage (tsubo)	Acreage of bldg. (tsubo)	Date released	Company to which sale was made
A	5,004	1,276	Jan. 21. 1948.	Tokuyama Girl's High School
B	10,374	1,109	Nov. 29. 1947.	Tokuyama Agricultural Association
C	3,105	0	Jan. 12. 1948.	Monopoly Public Corporation
D	3,379	493	"	Bofu Oils and Fats Industry Co. Ltd.
E	6,755	1,514	May 12. 1948.	Idemitsu Kosan K.K.

Attached paper: No.5
(Continued)

Area	Acreage (tsubo)	Acreage of bldg. (tsubo)	Date released	Company to which sale was made
G	21,004	299	Feb. 9. 1948. Aug. 9. 1948.	Tokuyama City Office

End

Map of Reparation Arsenal

1. Total acerage which was transferred from Ex-Navy (inside of black line):

214,490 tsubo

2. Areas not released:

113,618 tsubo

3. Buildings not released:

Attached paper No. 1

4. Areas released (land, inside of blue line):

100,872 tsubo
(attached paper No. 2)

5. Buildings which were released and remain (blue colour):

Attached paper No.3

6. Areas required for reparation dead storage:

97,818 tsubo

7. Buildings required for reparation dead storage:

Attached paper No. 4

8. Areas in Use by Occupation Forces:

None

9. Buildings in Use by Occupation Forces:

None

10. Areas in Use by Japanese Private Companies:

None

11. Areas on application for Use by Japanese Private Companies: (insid of red coloured oblique line):

Attached paper No. 5

12. Areas sold to Private Companies: (inside of blue coloured oblique line):

Attached paper No. 5

CODE NUMBER 45 - 7

NAME OF PLANT THIRD NAVAL FUEL DEPOT

LOCATION TOKUYAMA-SHI YAMAGUCHI-KE

SCALE 1 : 2000

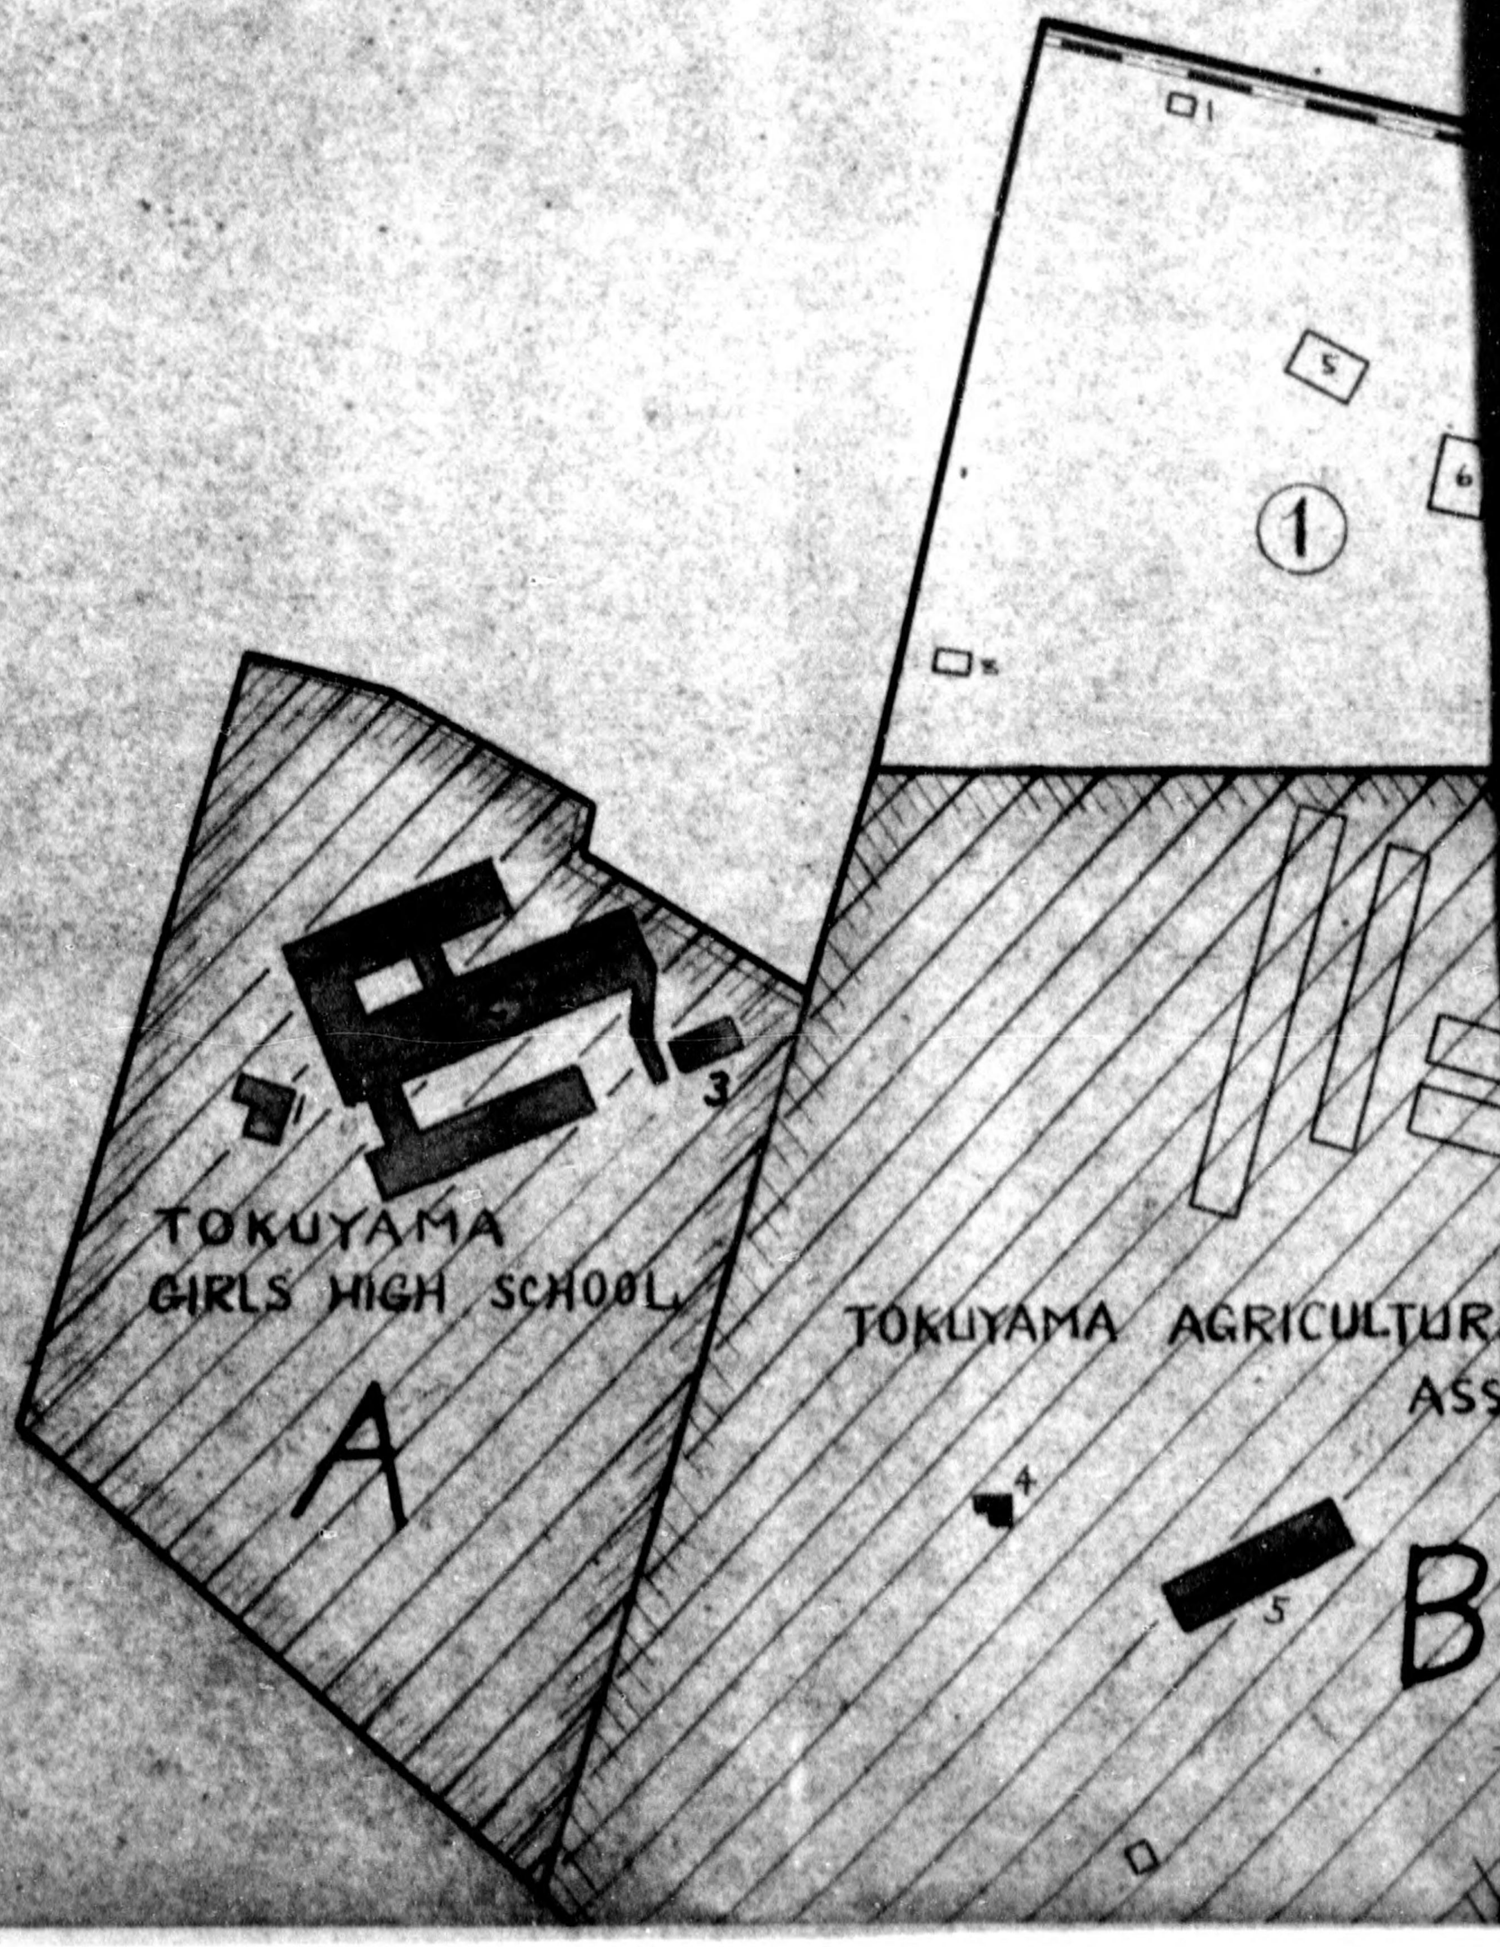

FUEL DEPOT

YAMAGUCHI-KEN

TOKUYAMA 3RD

BLDG. NO. 67

ALL MACHINES IN THIS BUILDING ARE EXEMPTED MACHINES
(THAT IS THEY BELONG TO NIPPON FERTILIZER C.O.)
THEREFORE ARE EXCLUDED FROM EVALUTION.

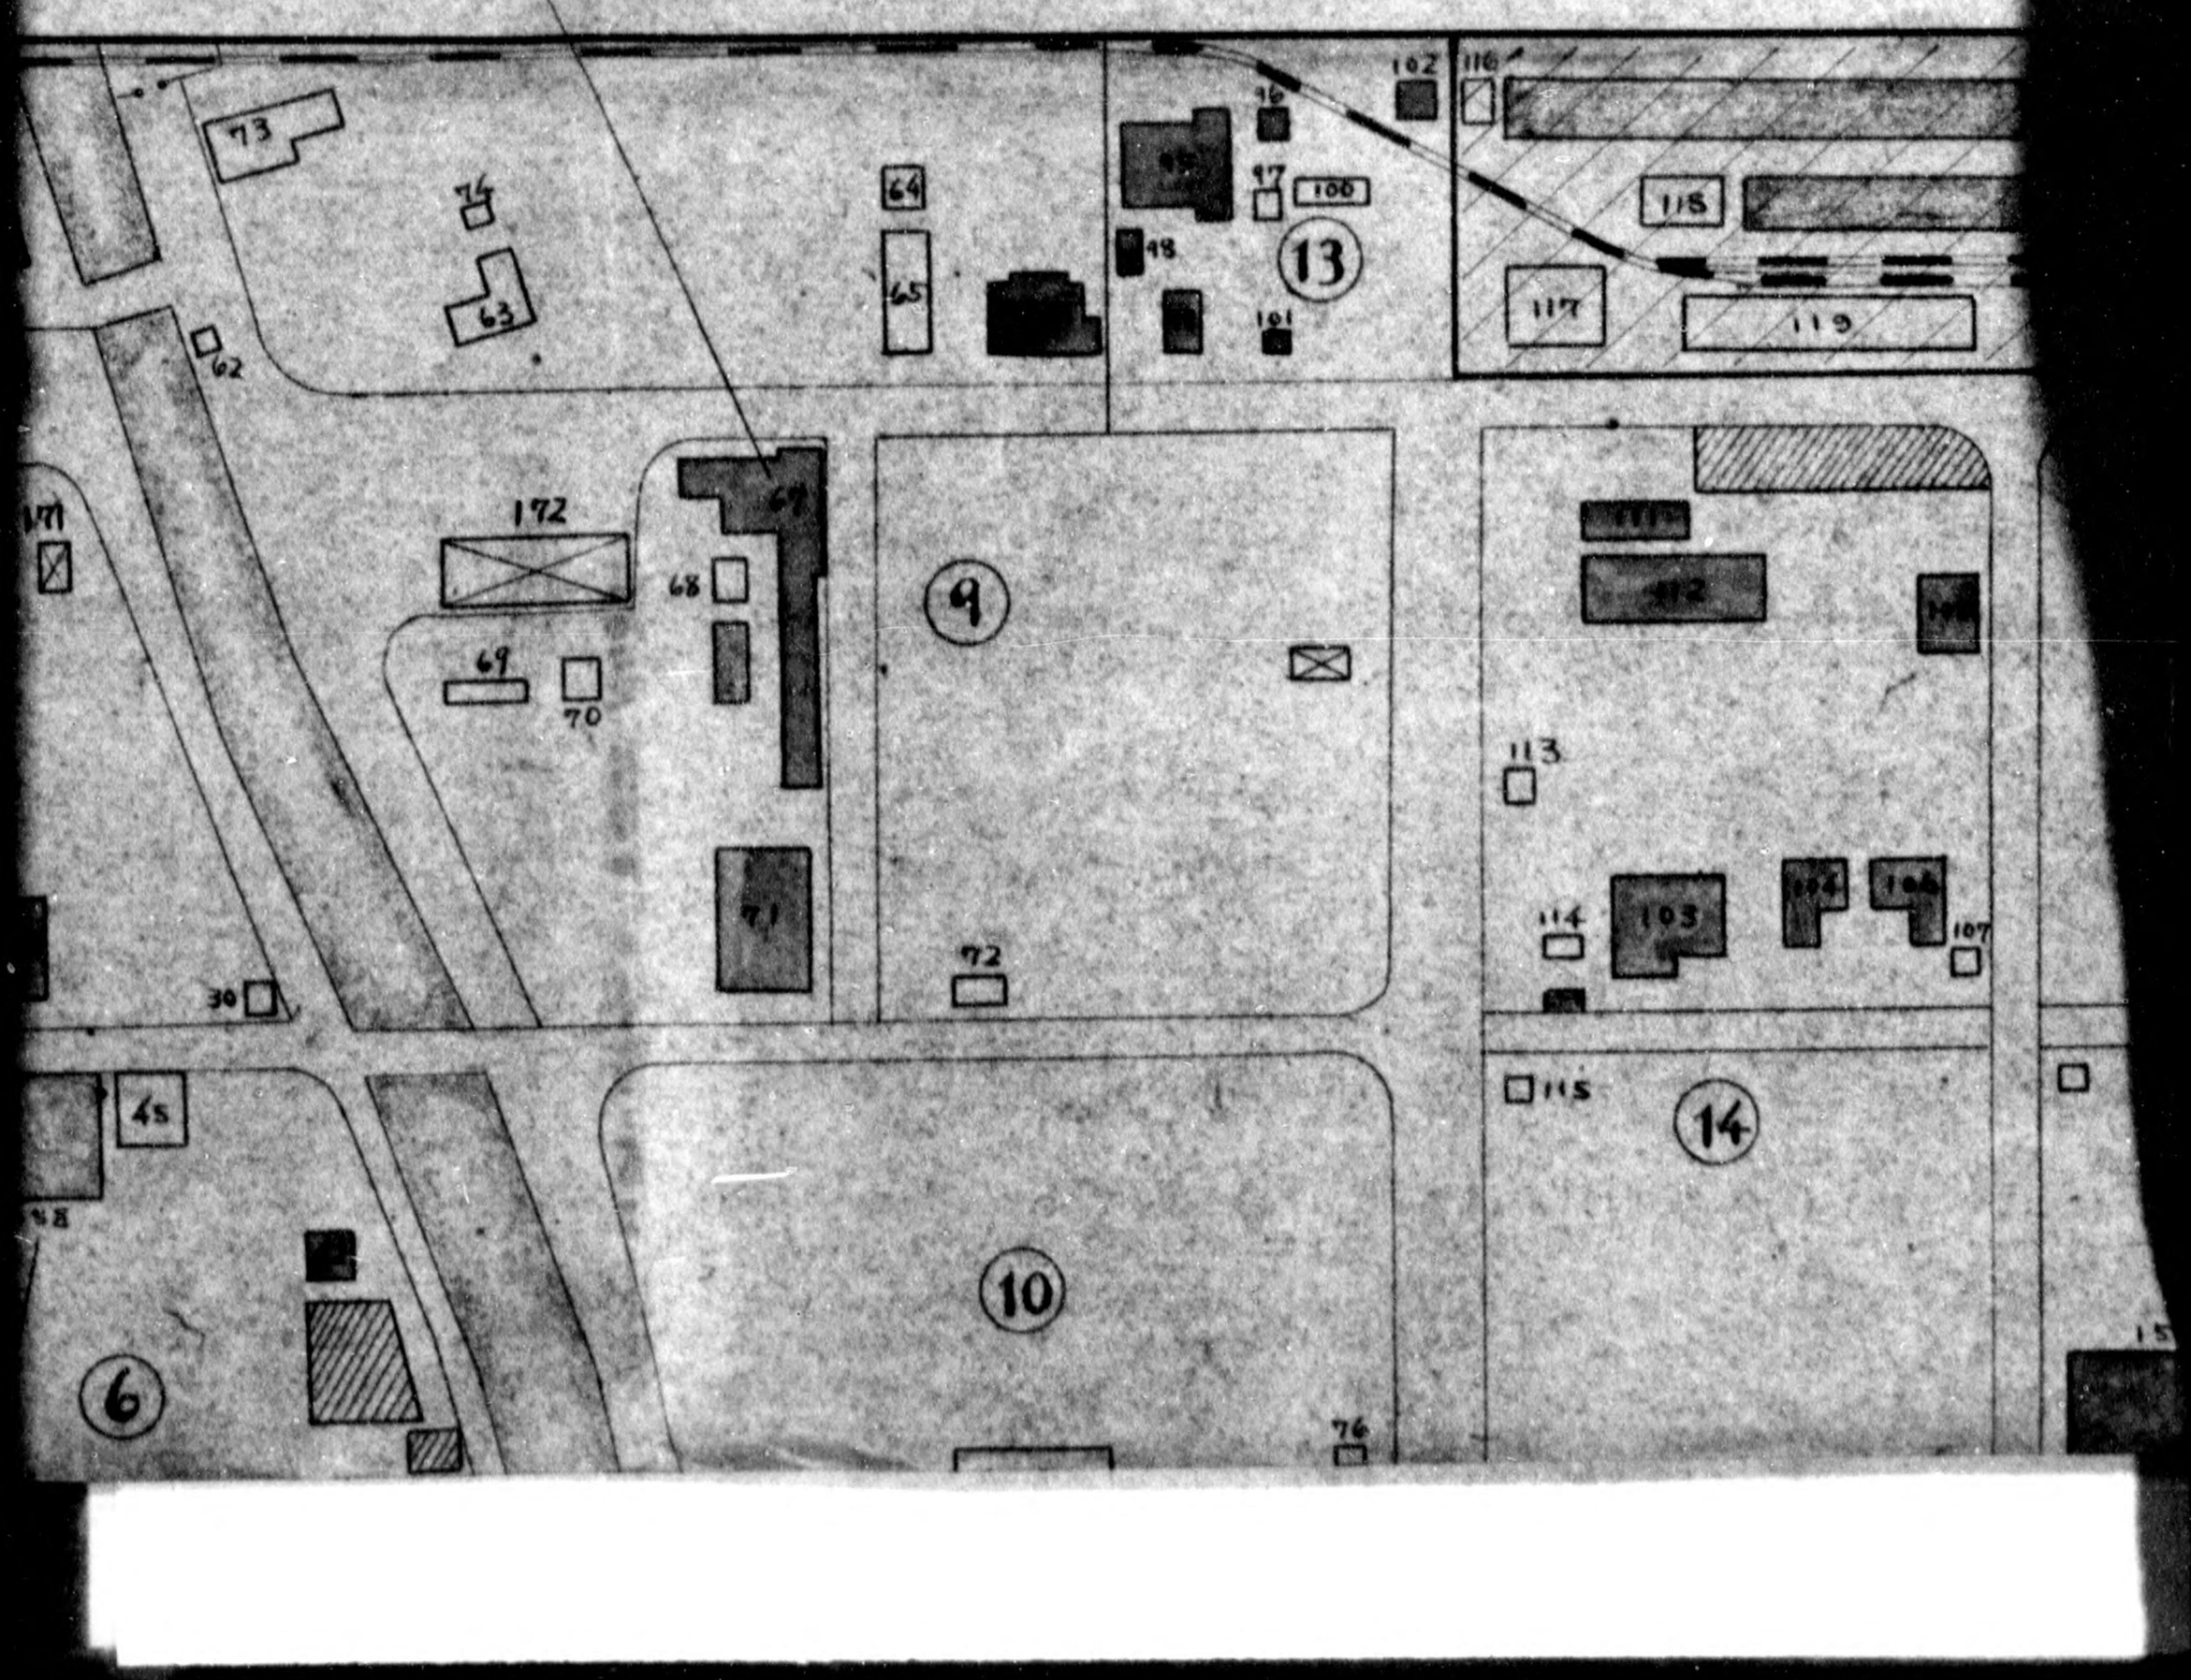

3RD NAVAL FUEL

ACHINES
R C.O.)
N.

BLDG. NO. 156.
THIS BUILDING WHICH HOUSES REPARATION MACHINES
IS RELEASED AND EXCLUDED FROM EVALUATION

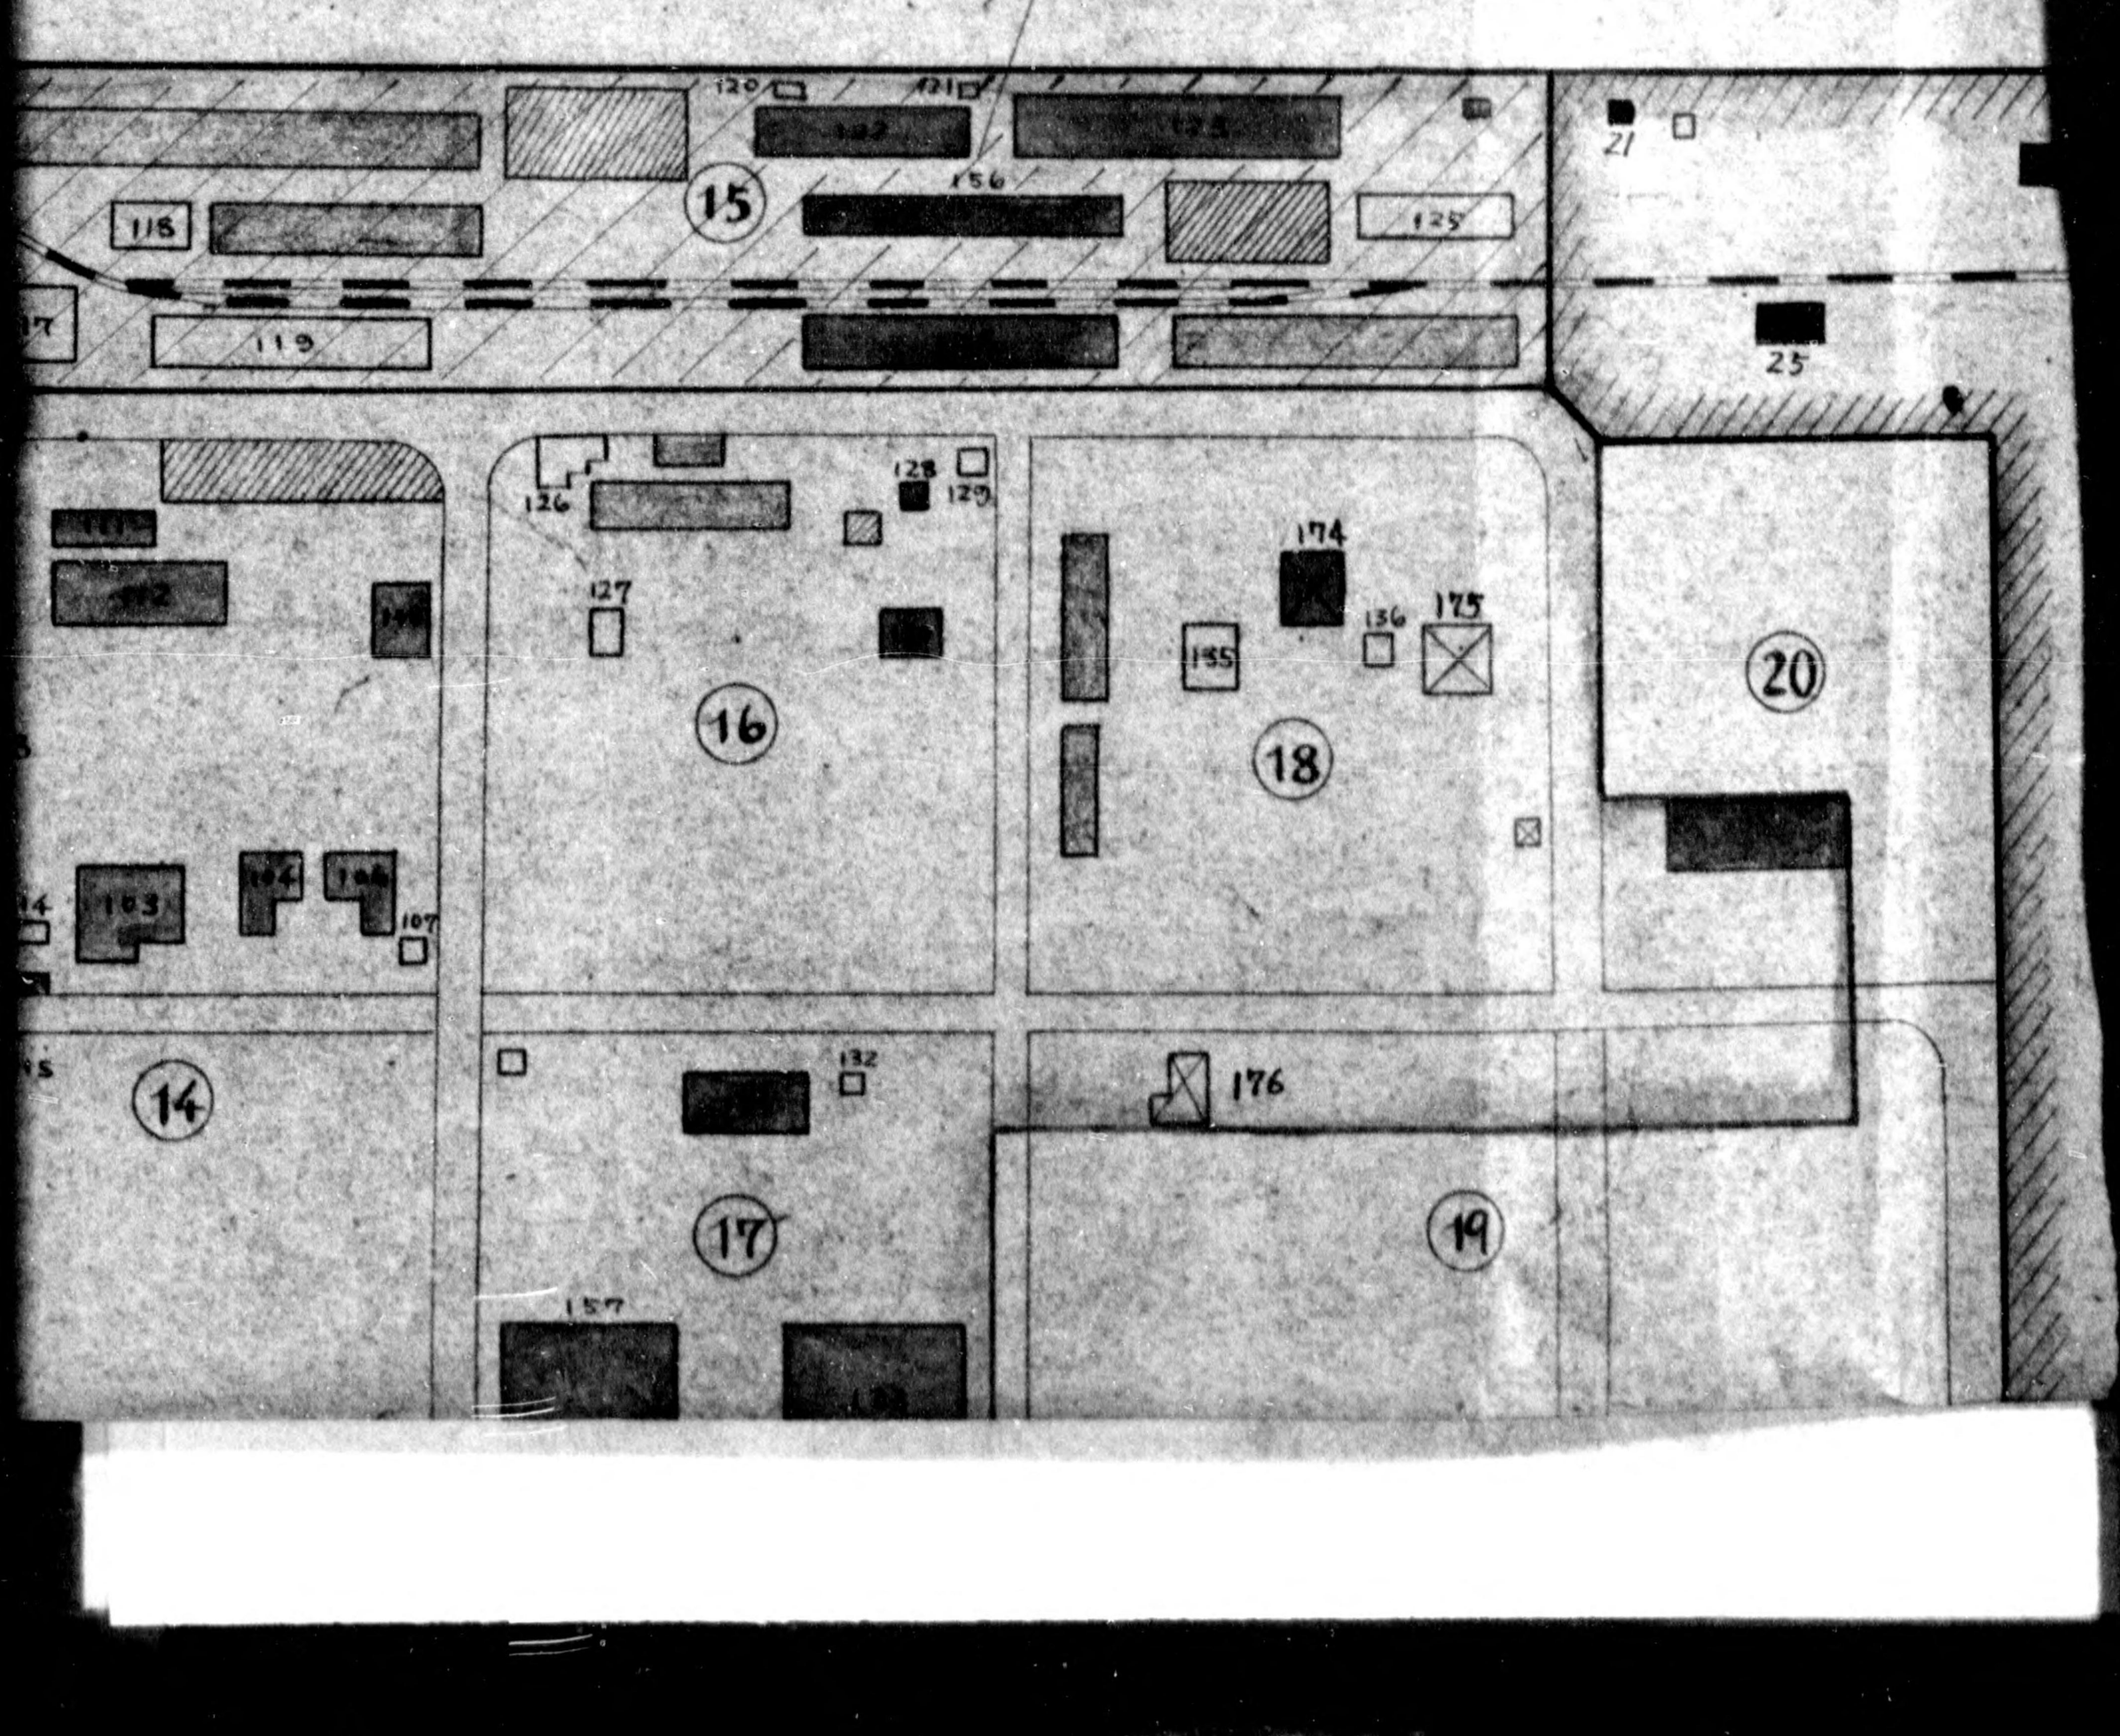

UEL DEPOT.

EPARATION MACHINES
ROM EVALUATION.

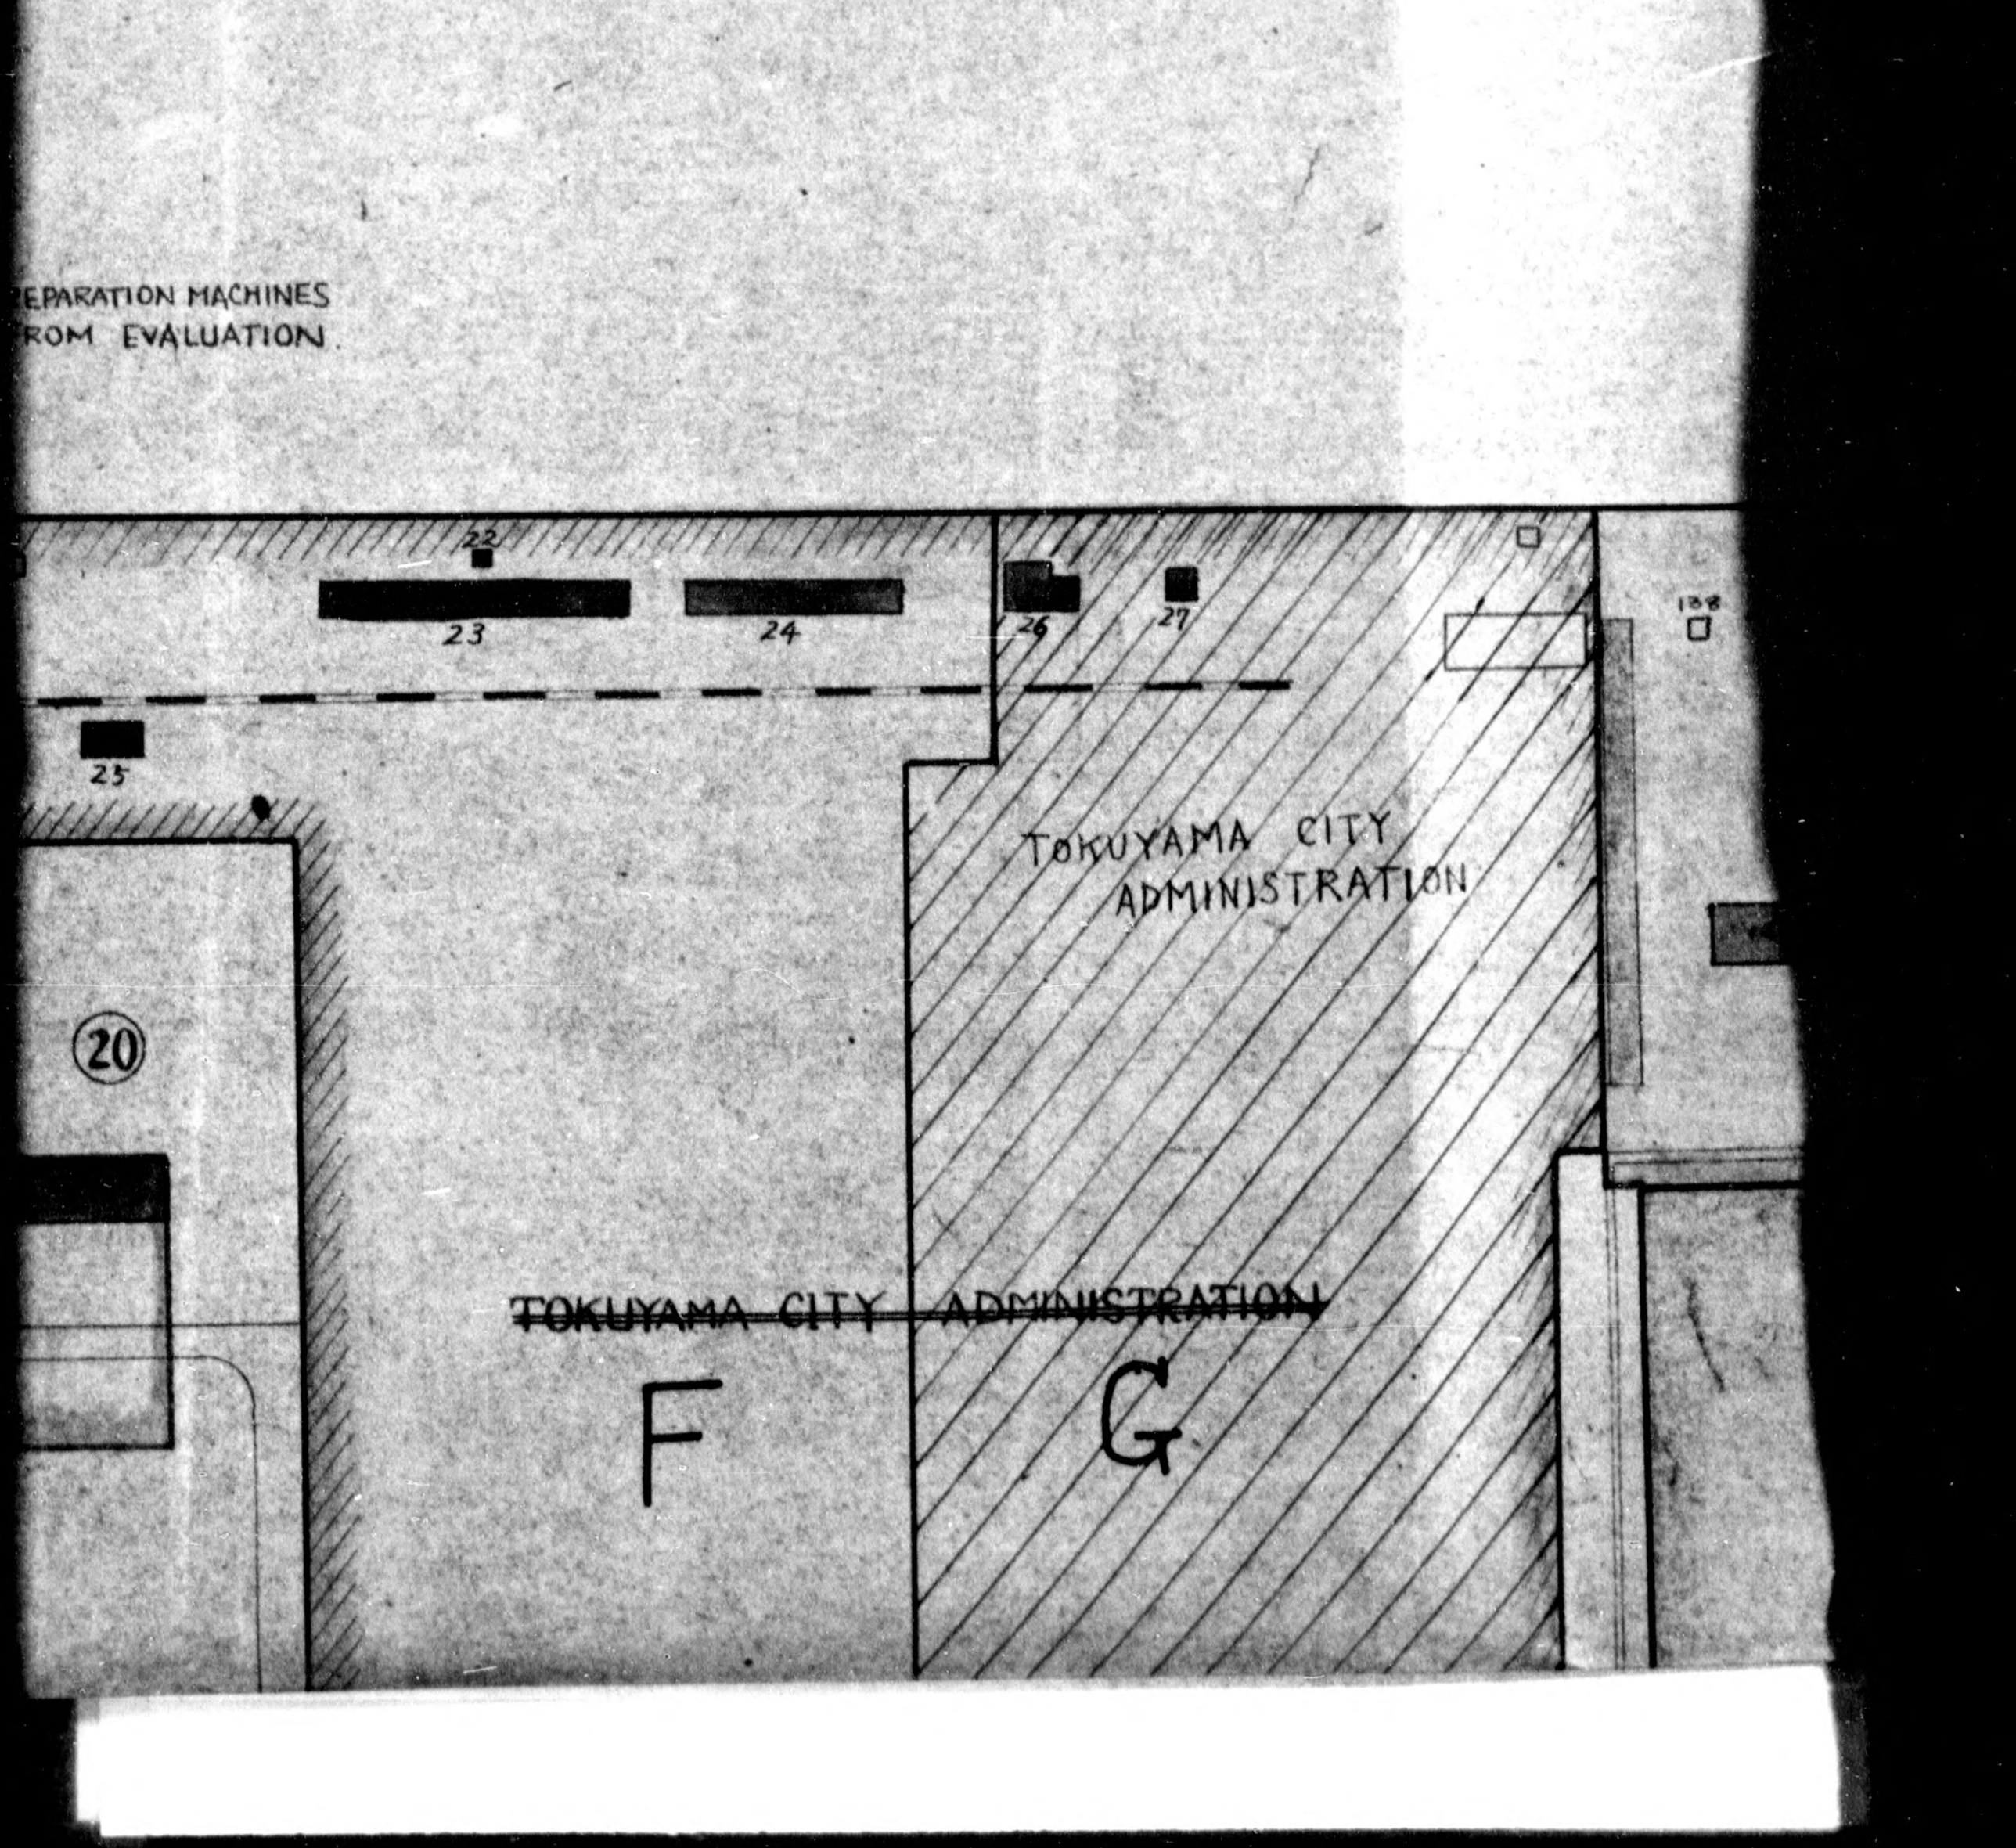

NOTE :

N

S

TOKUYAMA SHINKO K.K.

NIPPON

TOKUYAMA WAN

NOTE: MK D.

① ② ③ AREA NO.

1 2 3 BUILDING NO.

RESERVOIR

BUILDINGS NOT EVALUATED DUE TO HEAVY DAMAGE

RELEASED BUILDING

RELEASED AREA AND BUILDING

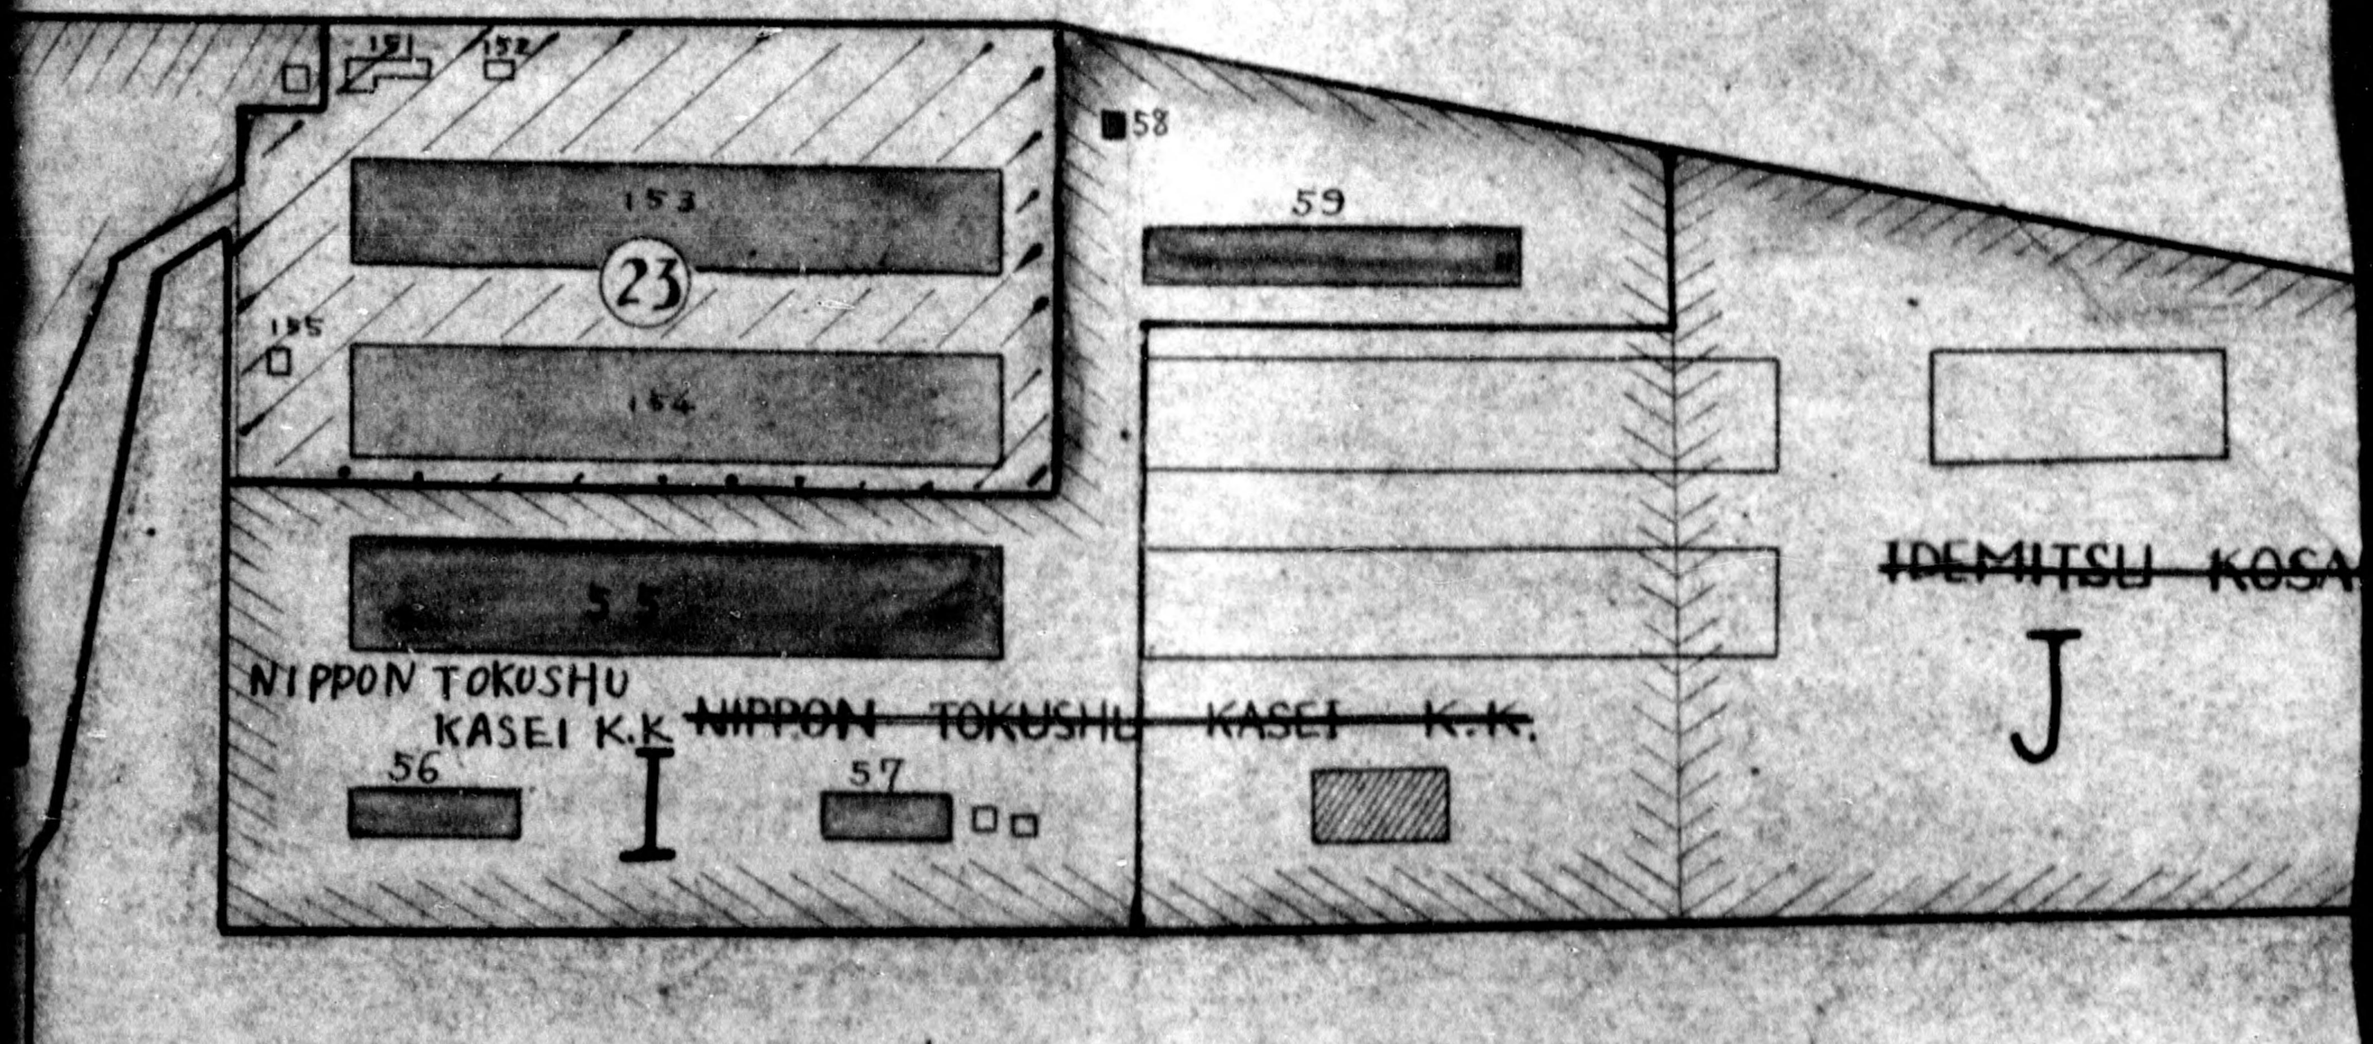

D.

T EVALUATED DUE TO HEAVY DAMAGE

BUILDING

REA AND BUILDING

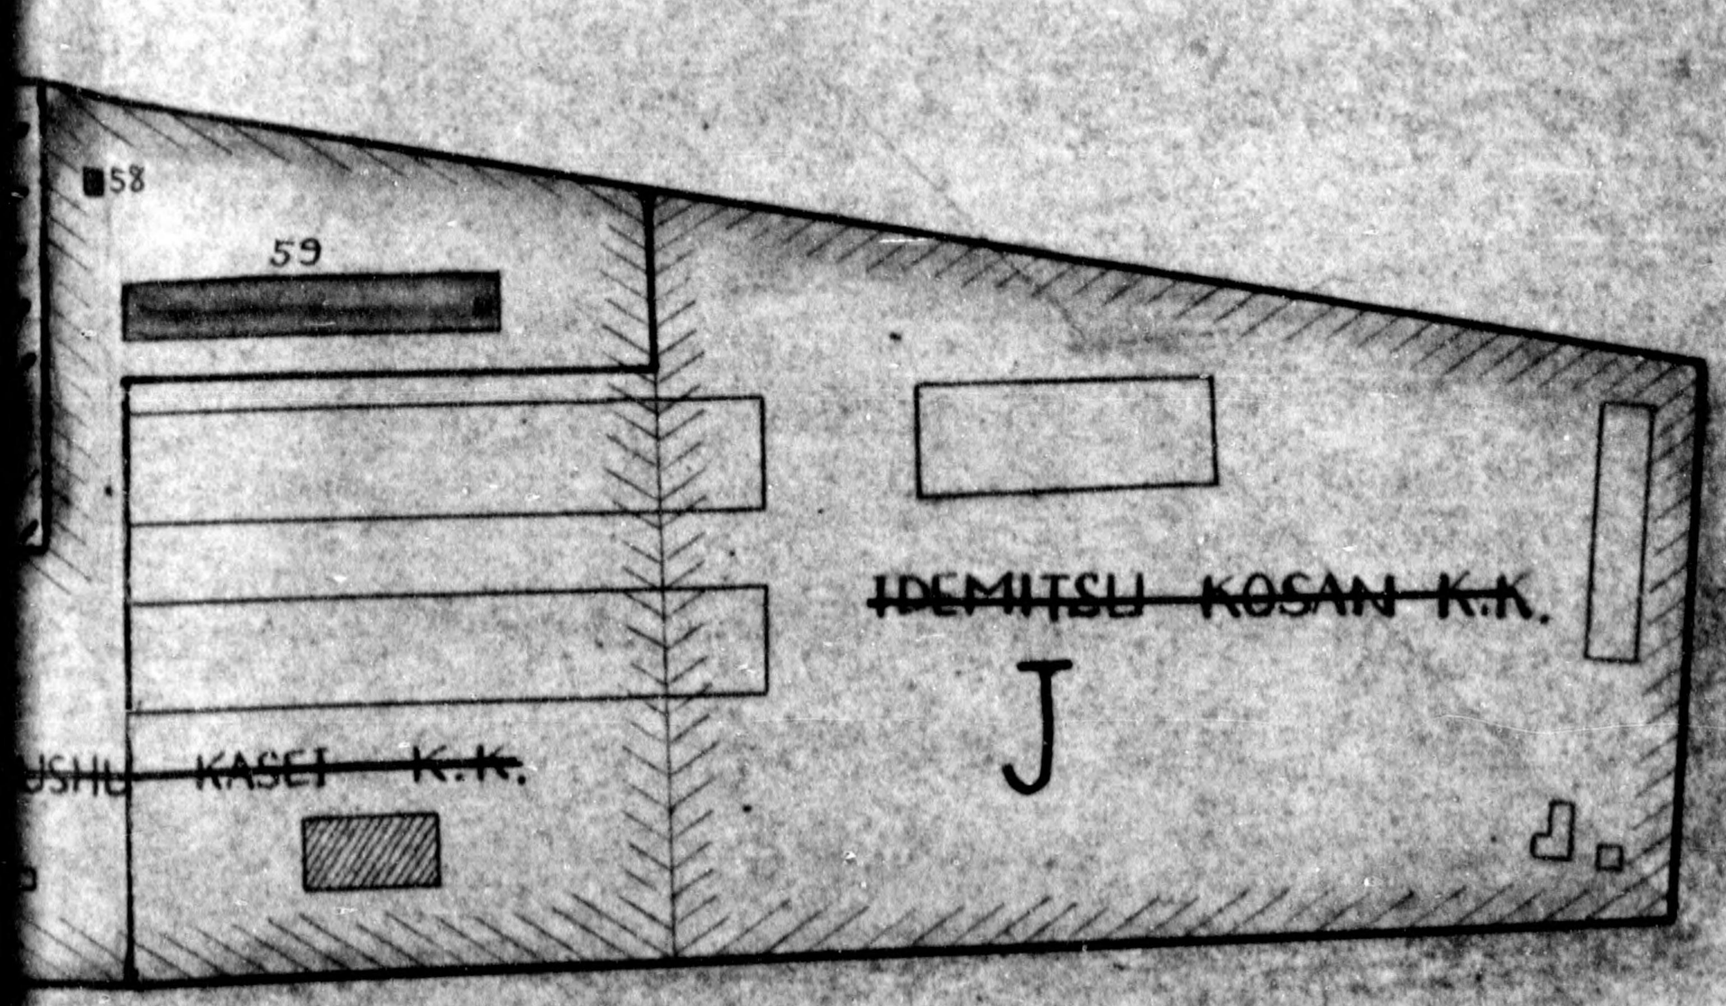

DECLASSIFIED E.O. 12065 SECTION 3 VOL 7 PAGE NO 1-P-0-10

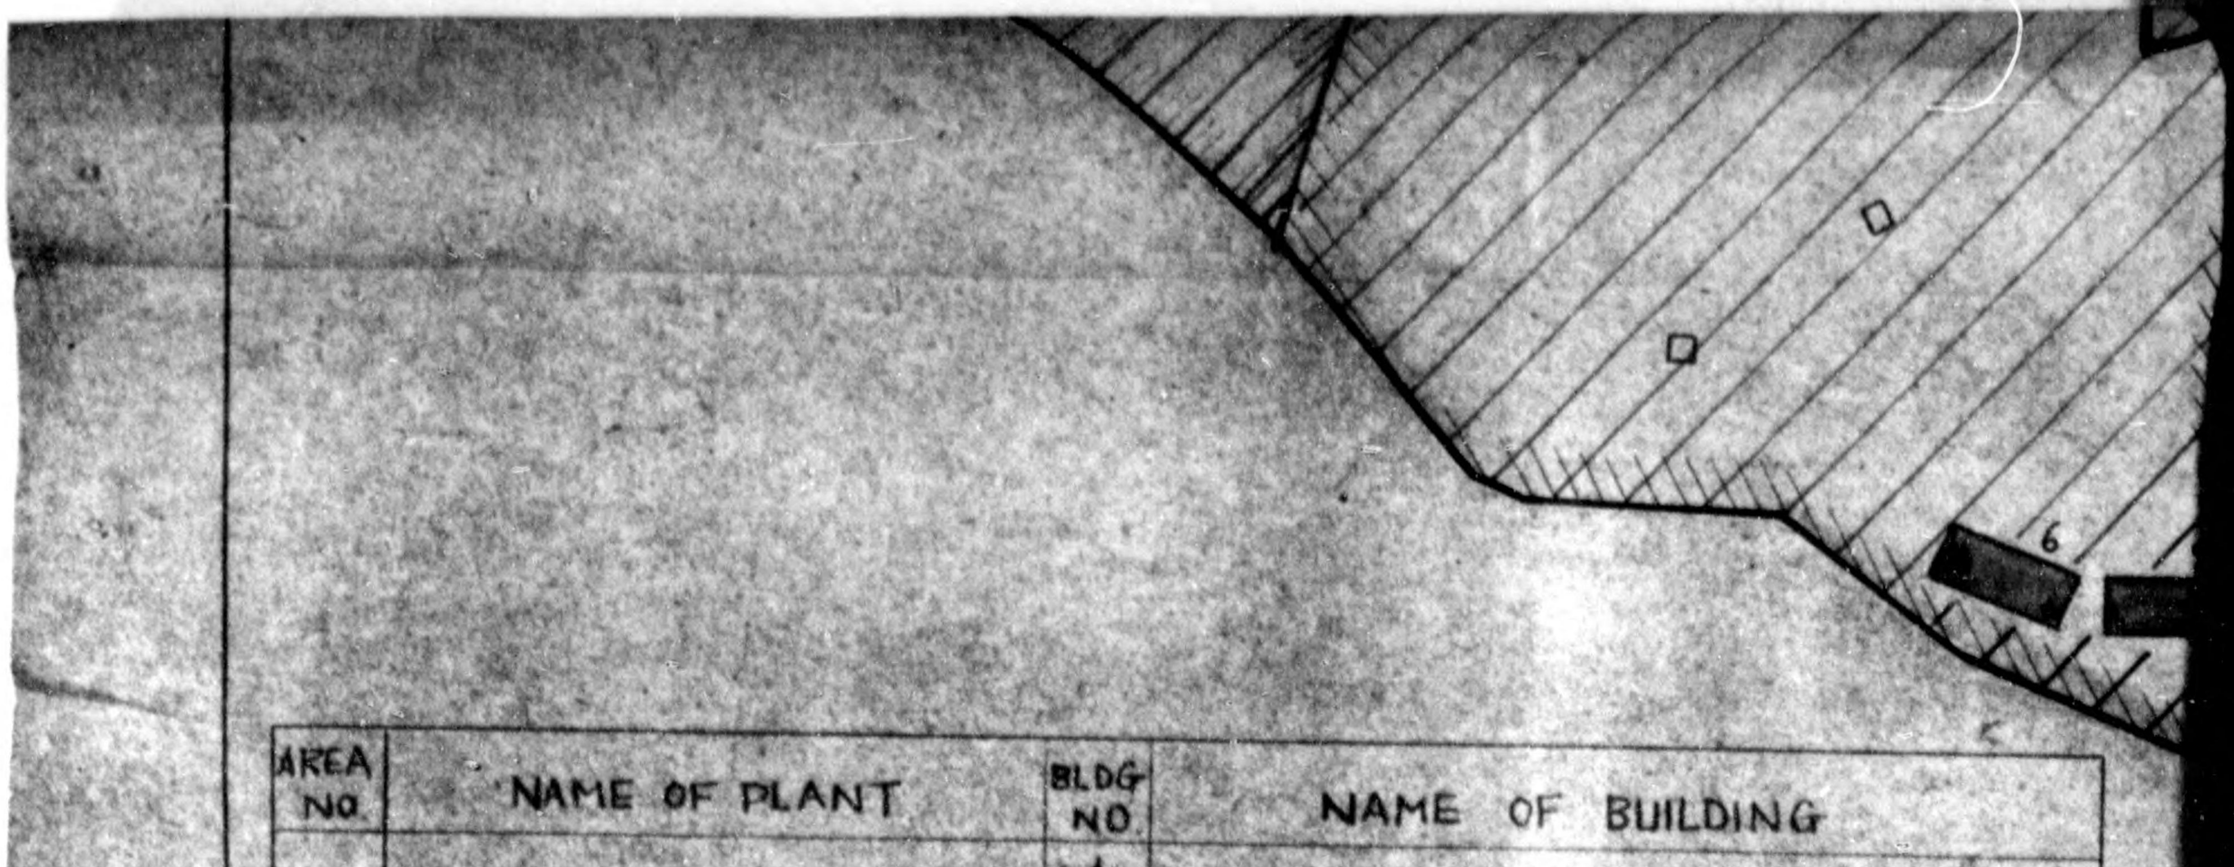

AREA NO.	NAME OF PLANT	BLDG NO.	NAME OF BUILDING
①	MISCELLANEOUS EQUIPMENT	1	WATCHMAN STATION
		2	CARBIDE WAREHOUSE
		3	DRUGS WAREHOUSE
		4	TOILET
		5	MATERIALS WAREHOUSE
		6	DRUGS WAREHOUSE
		7	ACETYLENE GAS PRODUCING ROOM
		8	WATCHMAN STATION
②	MACHINE SHOP PLANT.	9	MACHINE SHOP
		10	MACHINE SHOP
		11	MACHINE SHOP
		12	MACHINE SHOP
		13	MATERIALS WAREHOUSE
		14	MATERIALS WAREHOUSE
		15	ELECTRIC WAREHOUSE
		16	TOILET
		17	TOILET
③	2ND SOLVENT EXTRACTION AND DEWAXING PLANT.	18	MATERIALS WAREHOUSE
		19	MATERIALS WAREHOUSE
		20	TOILET
		21	FURNACES ROOM.
		22	2ND SOLVENT EXTRACTION HOUSE
		23	COAL WAREHOUSE
		24	BARISOL TREATMENT HOUSE
		25	WATCHMAN STATION
		26	LUBRICATING OIL SHOP
④	2ND VACUUM DISTILLATION PLANT 1ST SOLVENT EXTRACTION AND DEWAXING PLANT. 3RD BOILER PLANT FOAMITE FIRE FIRTHING EQUIPMENT	27	MATERIALS WAREHOUSE
		28	3RD BOILER HOUSE
		29	FOAMIT PUMP HOUSE
		30	SWITCH STATION
⑤	ACID CLAY REGENFRATION PLANT. TETRA ETHYL LEAD PLANT	31	MATERIALS WAREHOUSE
		32	TOILET.
		33	TETRA ETHYL LEAD SHOP
		34	CHLORINE PRODUCING HOUSE
		35	WASTE CLAY TREATING HOUSE.
		36	FURNACES ROOM.
		37	LABORATORY OF TETRA ETHYL LEAD PLANT
		38	TETRA ETHYL LEAD REACTOR AND MANUFACTURED GOODS WAREHOUSE

DECLASSIFIED E.O. 12065 SECTION 3 NND 7 MAR 82

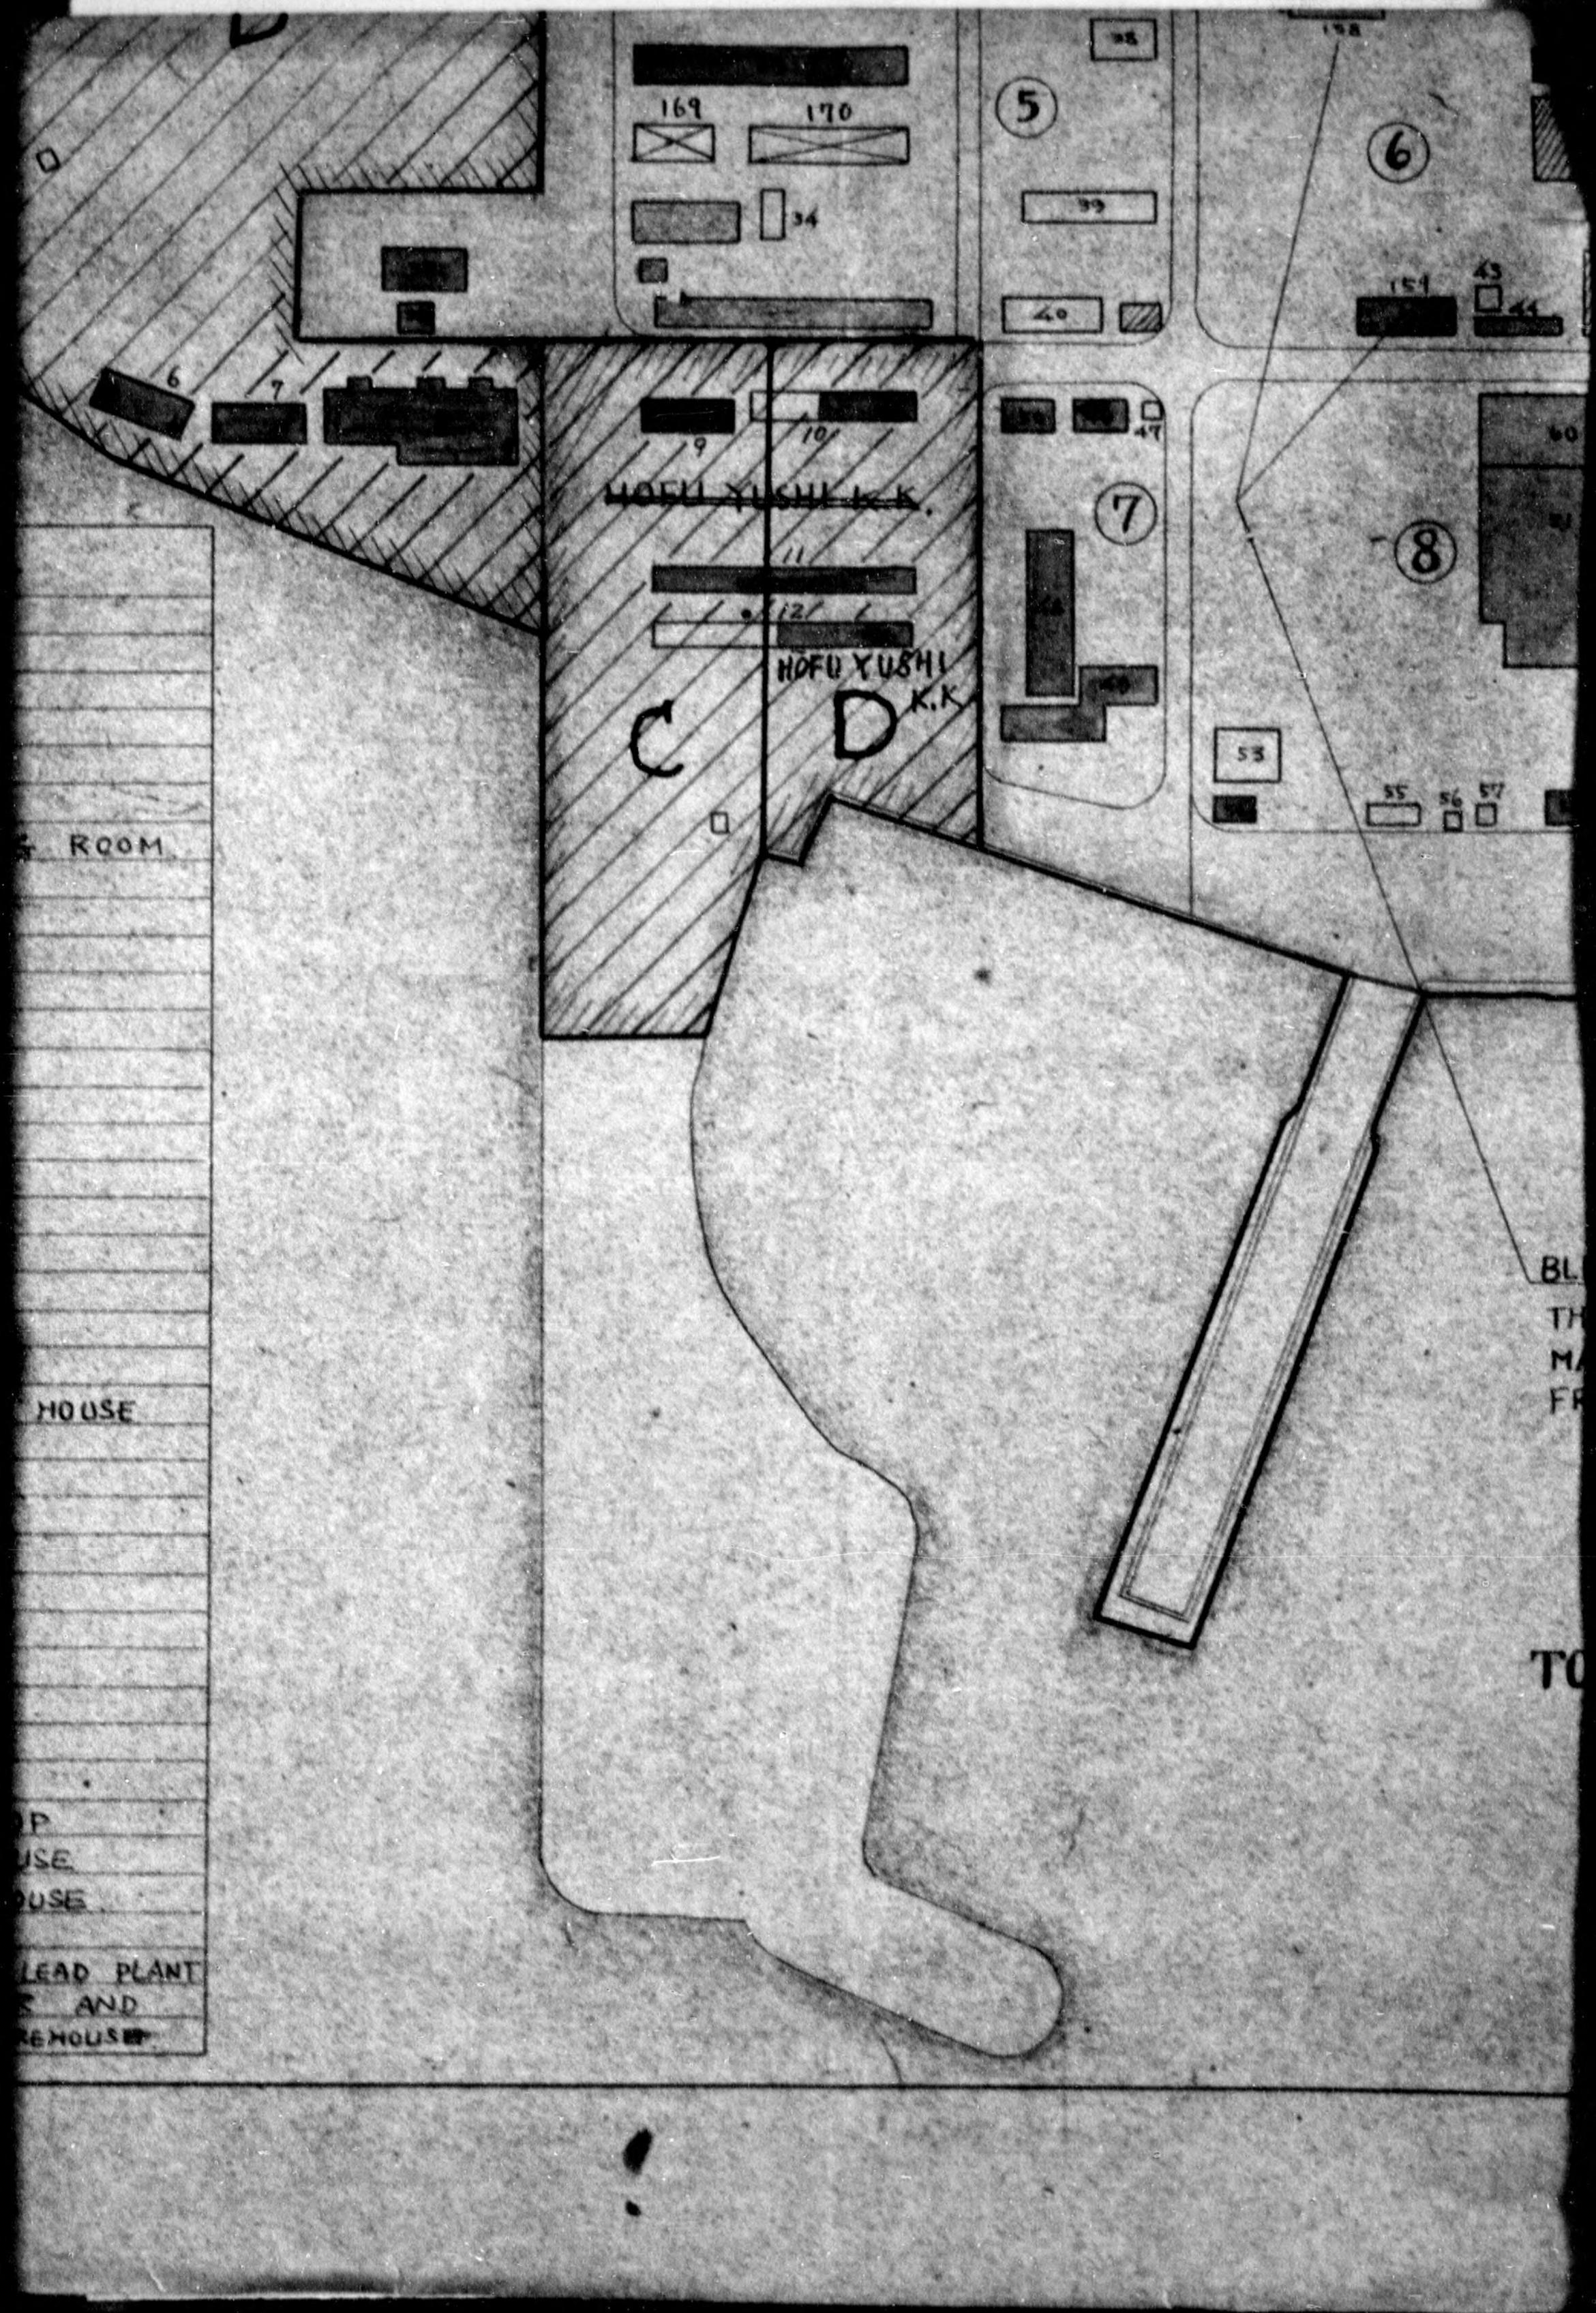

DECLASSIFIED E.O. 12065 SECTION 3-402 / NNBB NO.

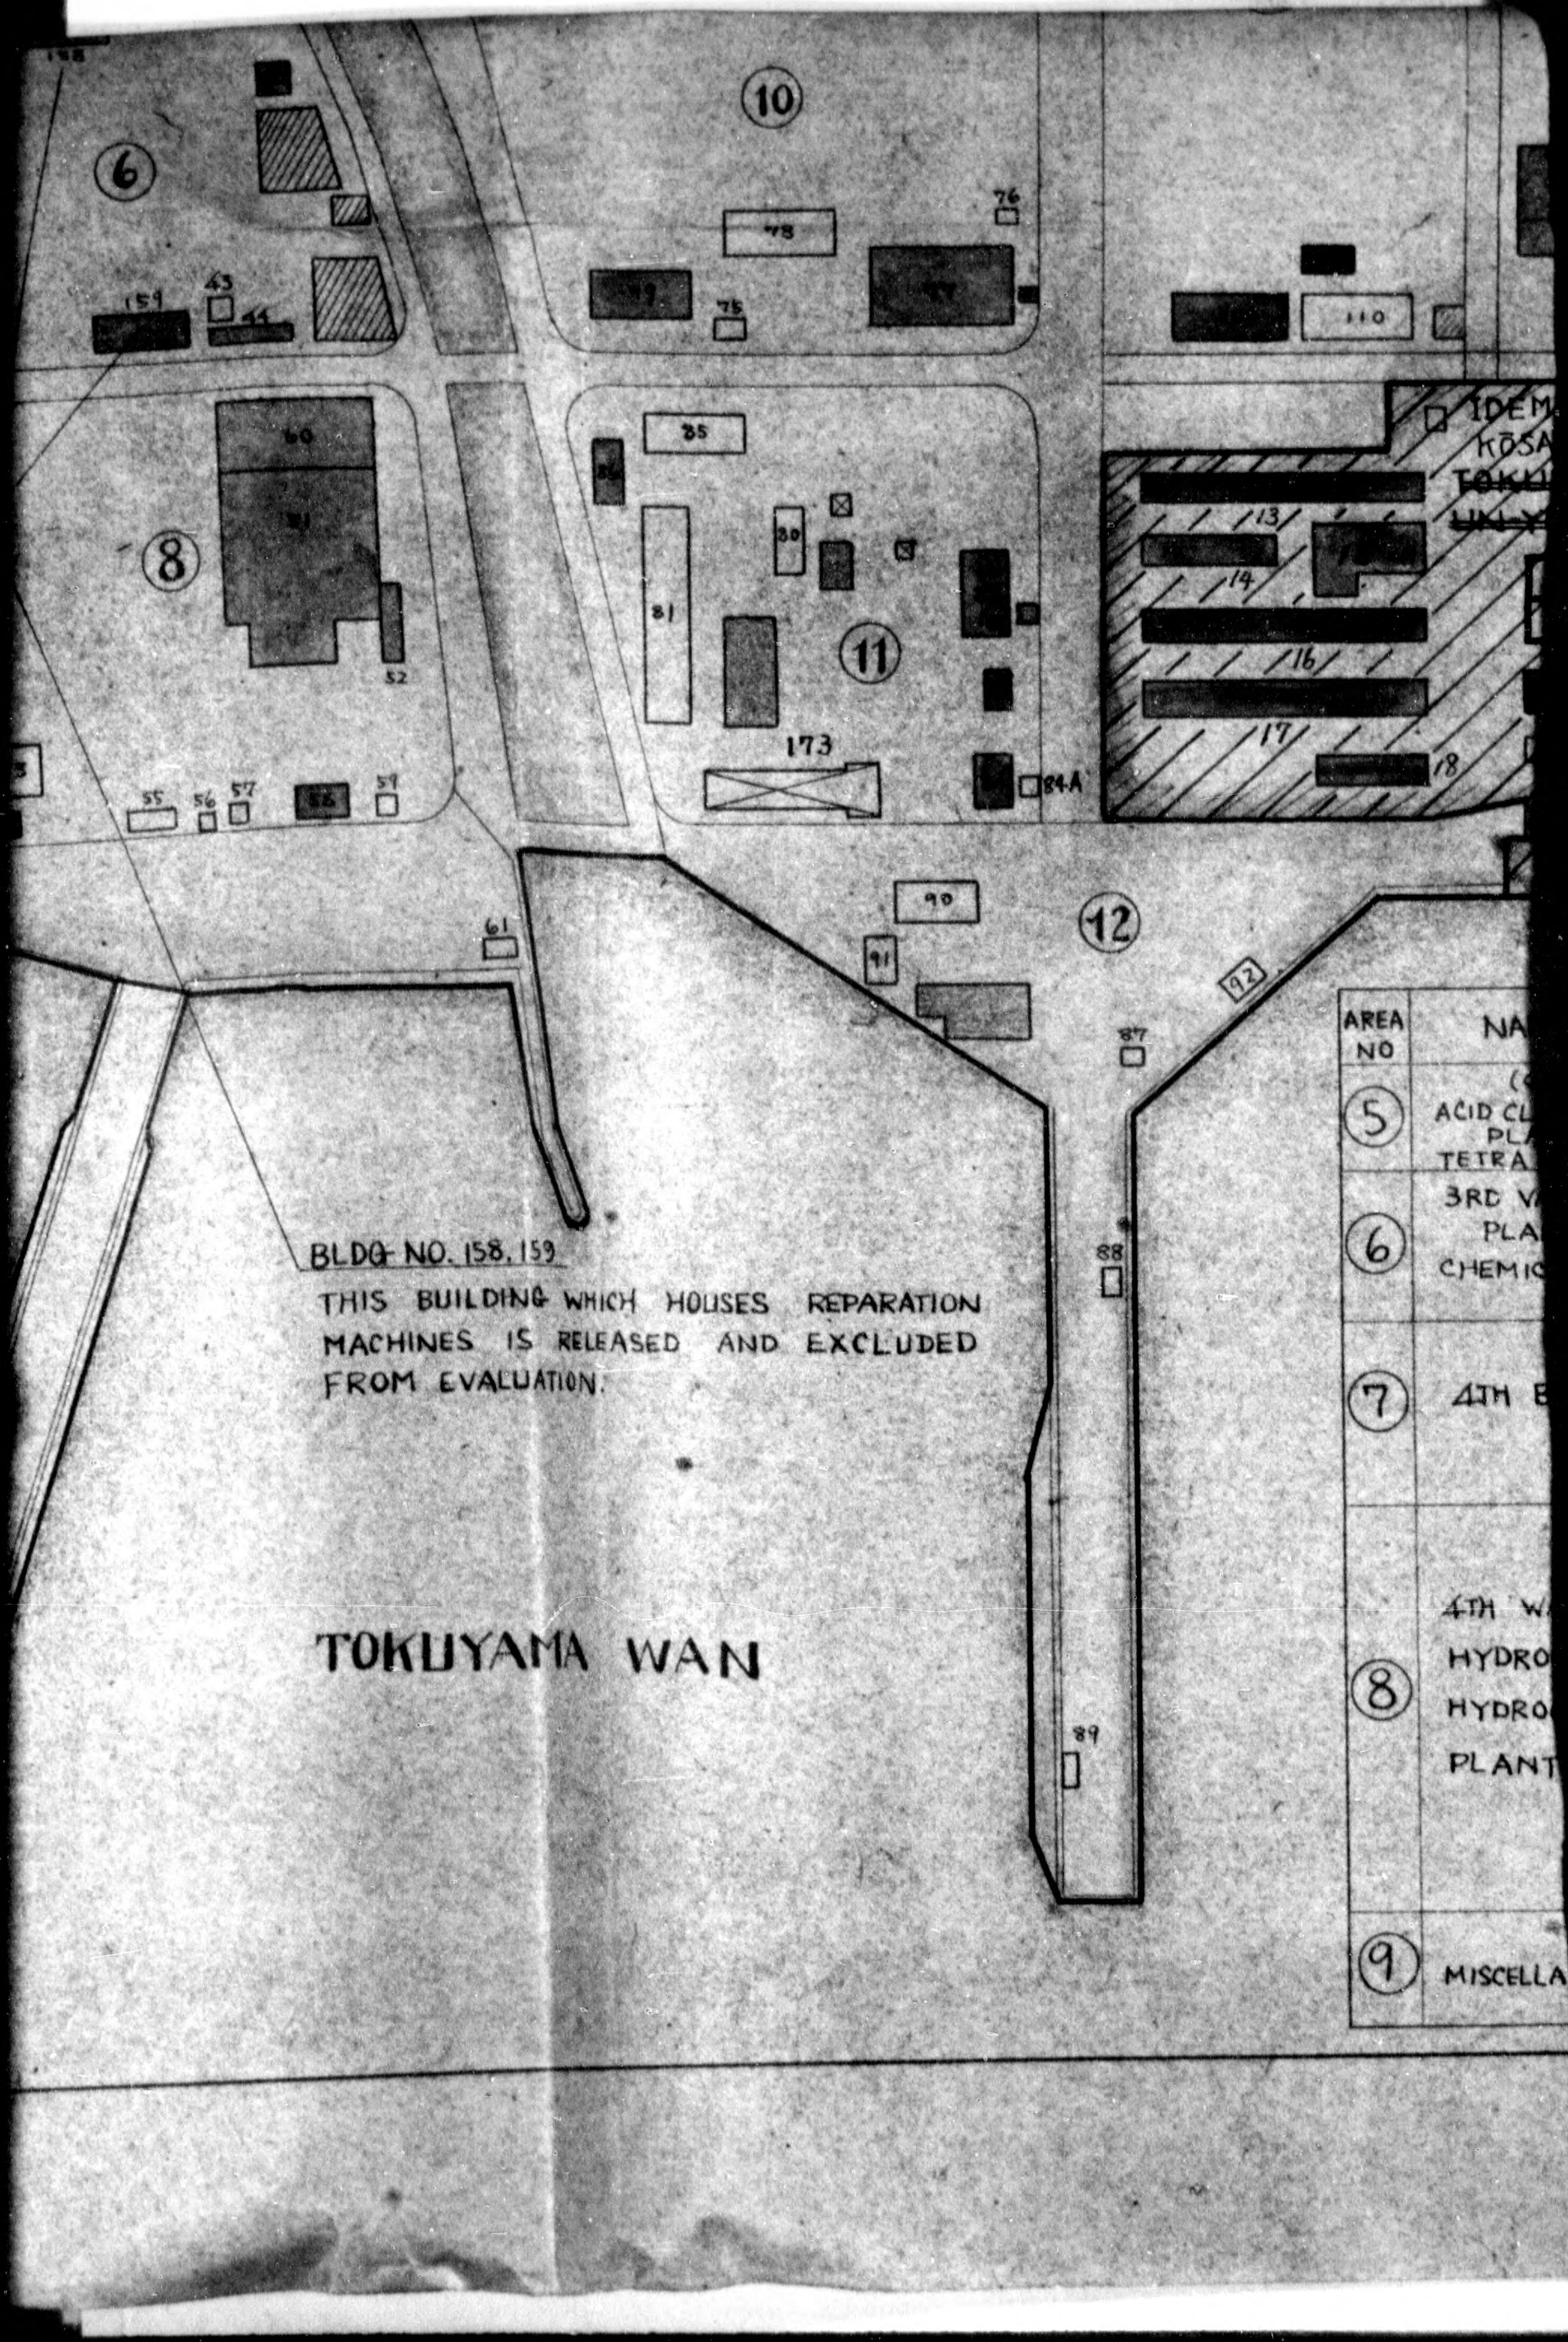

DECLASSIFIED E.O. 12065 SECTION 3-402 / NNDG NO: 77-83

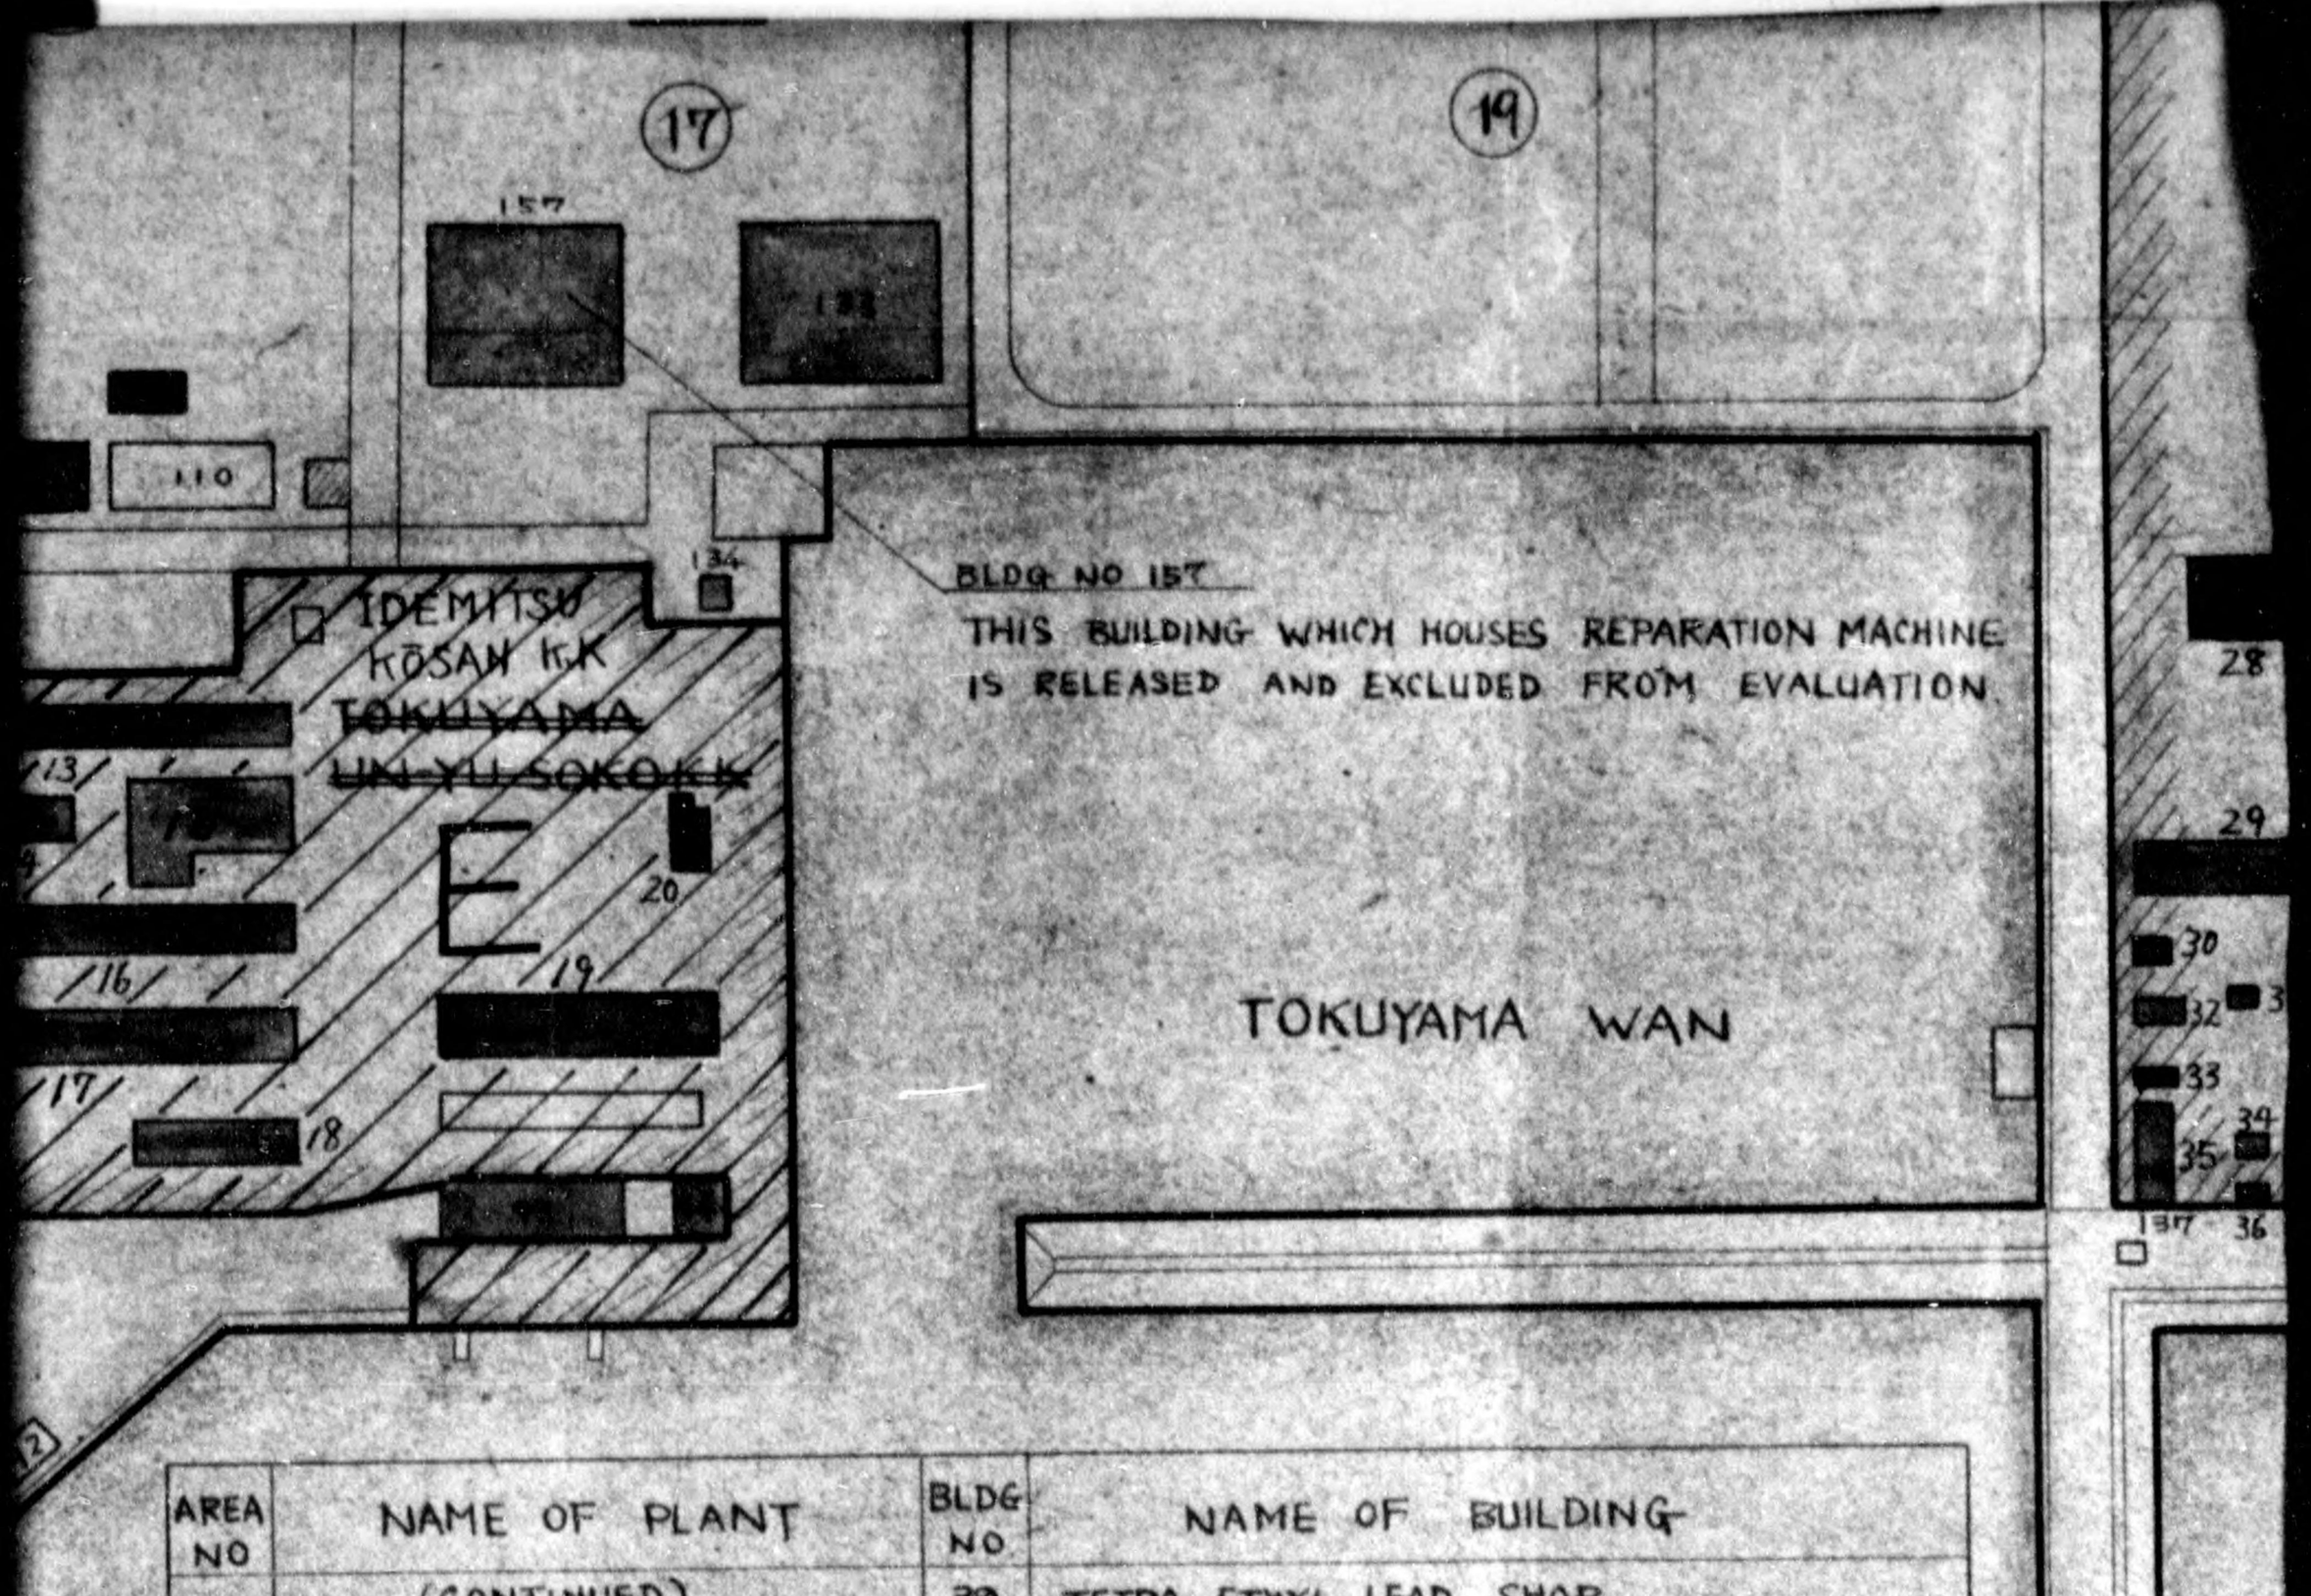

AREA NO	NAME OF PLANT	BLDG NO	NAME OF BUILDING
⑤	(CONTINUED) ACID CLAY REGENERATION PLANT TETRA ETHYL LEAD PLANT	39	TETRA ETHYL LEAD SHOP
		40	MATERIALS WAREHOUSE
		41	TOILET
⑥	3RD VACUUM DISTILLATION PLANT CHEMICAL TREATMENT PLANT	42	PUMP HOUSE
		43	TOILET
		44	MATERIALS WAREHOUSE
		45	CLAY WAREHOUSE
⑦	4TH BOILER PLANT	46	MATERIALS WAREHOUSE
		47	TOILET
		48	4TH BOILER HOUSE
		49	COAL WAREHOUSE
		50	MATERIALS WAREHOUSE
⑧	4TH WATER PUMP PLANT HYDROCRACKING PLANT HYDROGEN REFINING PLANT	51	NAVY 98 TYPE HYDROCRACKING EQUIPMENT HOUSE
		52	NAVY 98 TYPE HYDROCRACKING PLANT PUMP HOUSE
		53	TESTING ROOM
		54	WATER PUMP HOUSE
		55	GAS ANALYSIS SHOP
		56	SWITCH STATION
		57	TOILET
		58	CAUSTIC SODA RECOVERING SHOP
		59	WAREHOUSE
		60	NAVY 98 TYPE HYDROCRACKING PLANT PUMP HOUSE
		61	LOCKER HOUSE
⑨	MISCELLANEOUS EQUIPMENT	62	WAREHOUSE
		63	LOCKER HOUSE
		64	MATERIALS WAREHOUSE

DECLASSIFIED E.O. 12065 SECTION 3-402 / NNDG NO. 776813

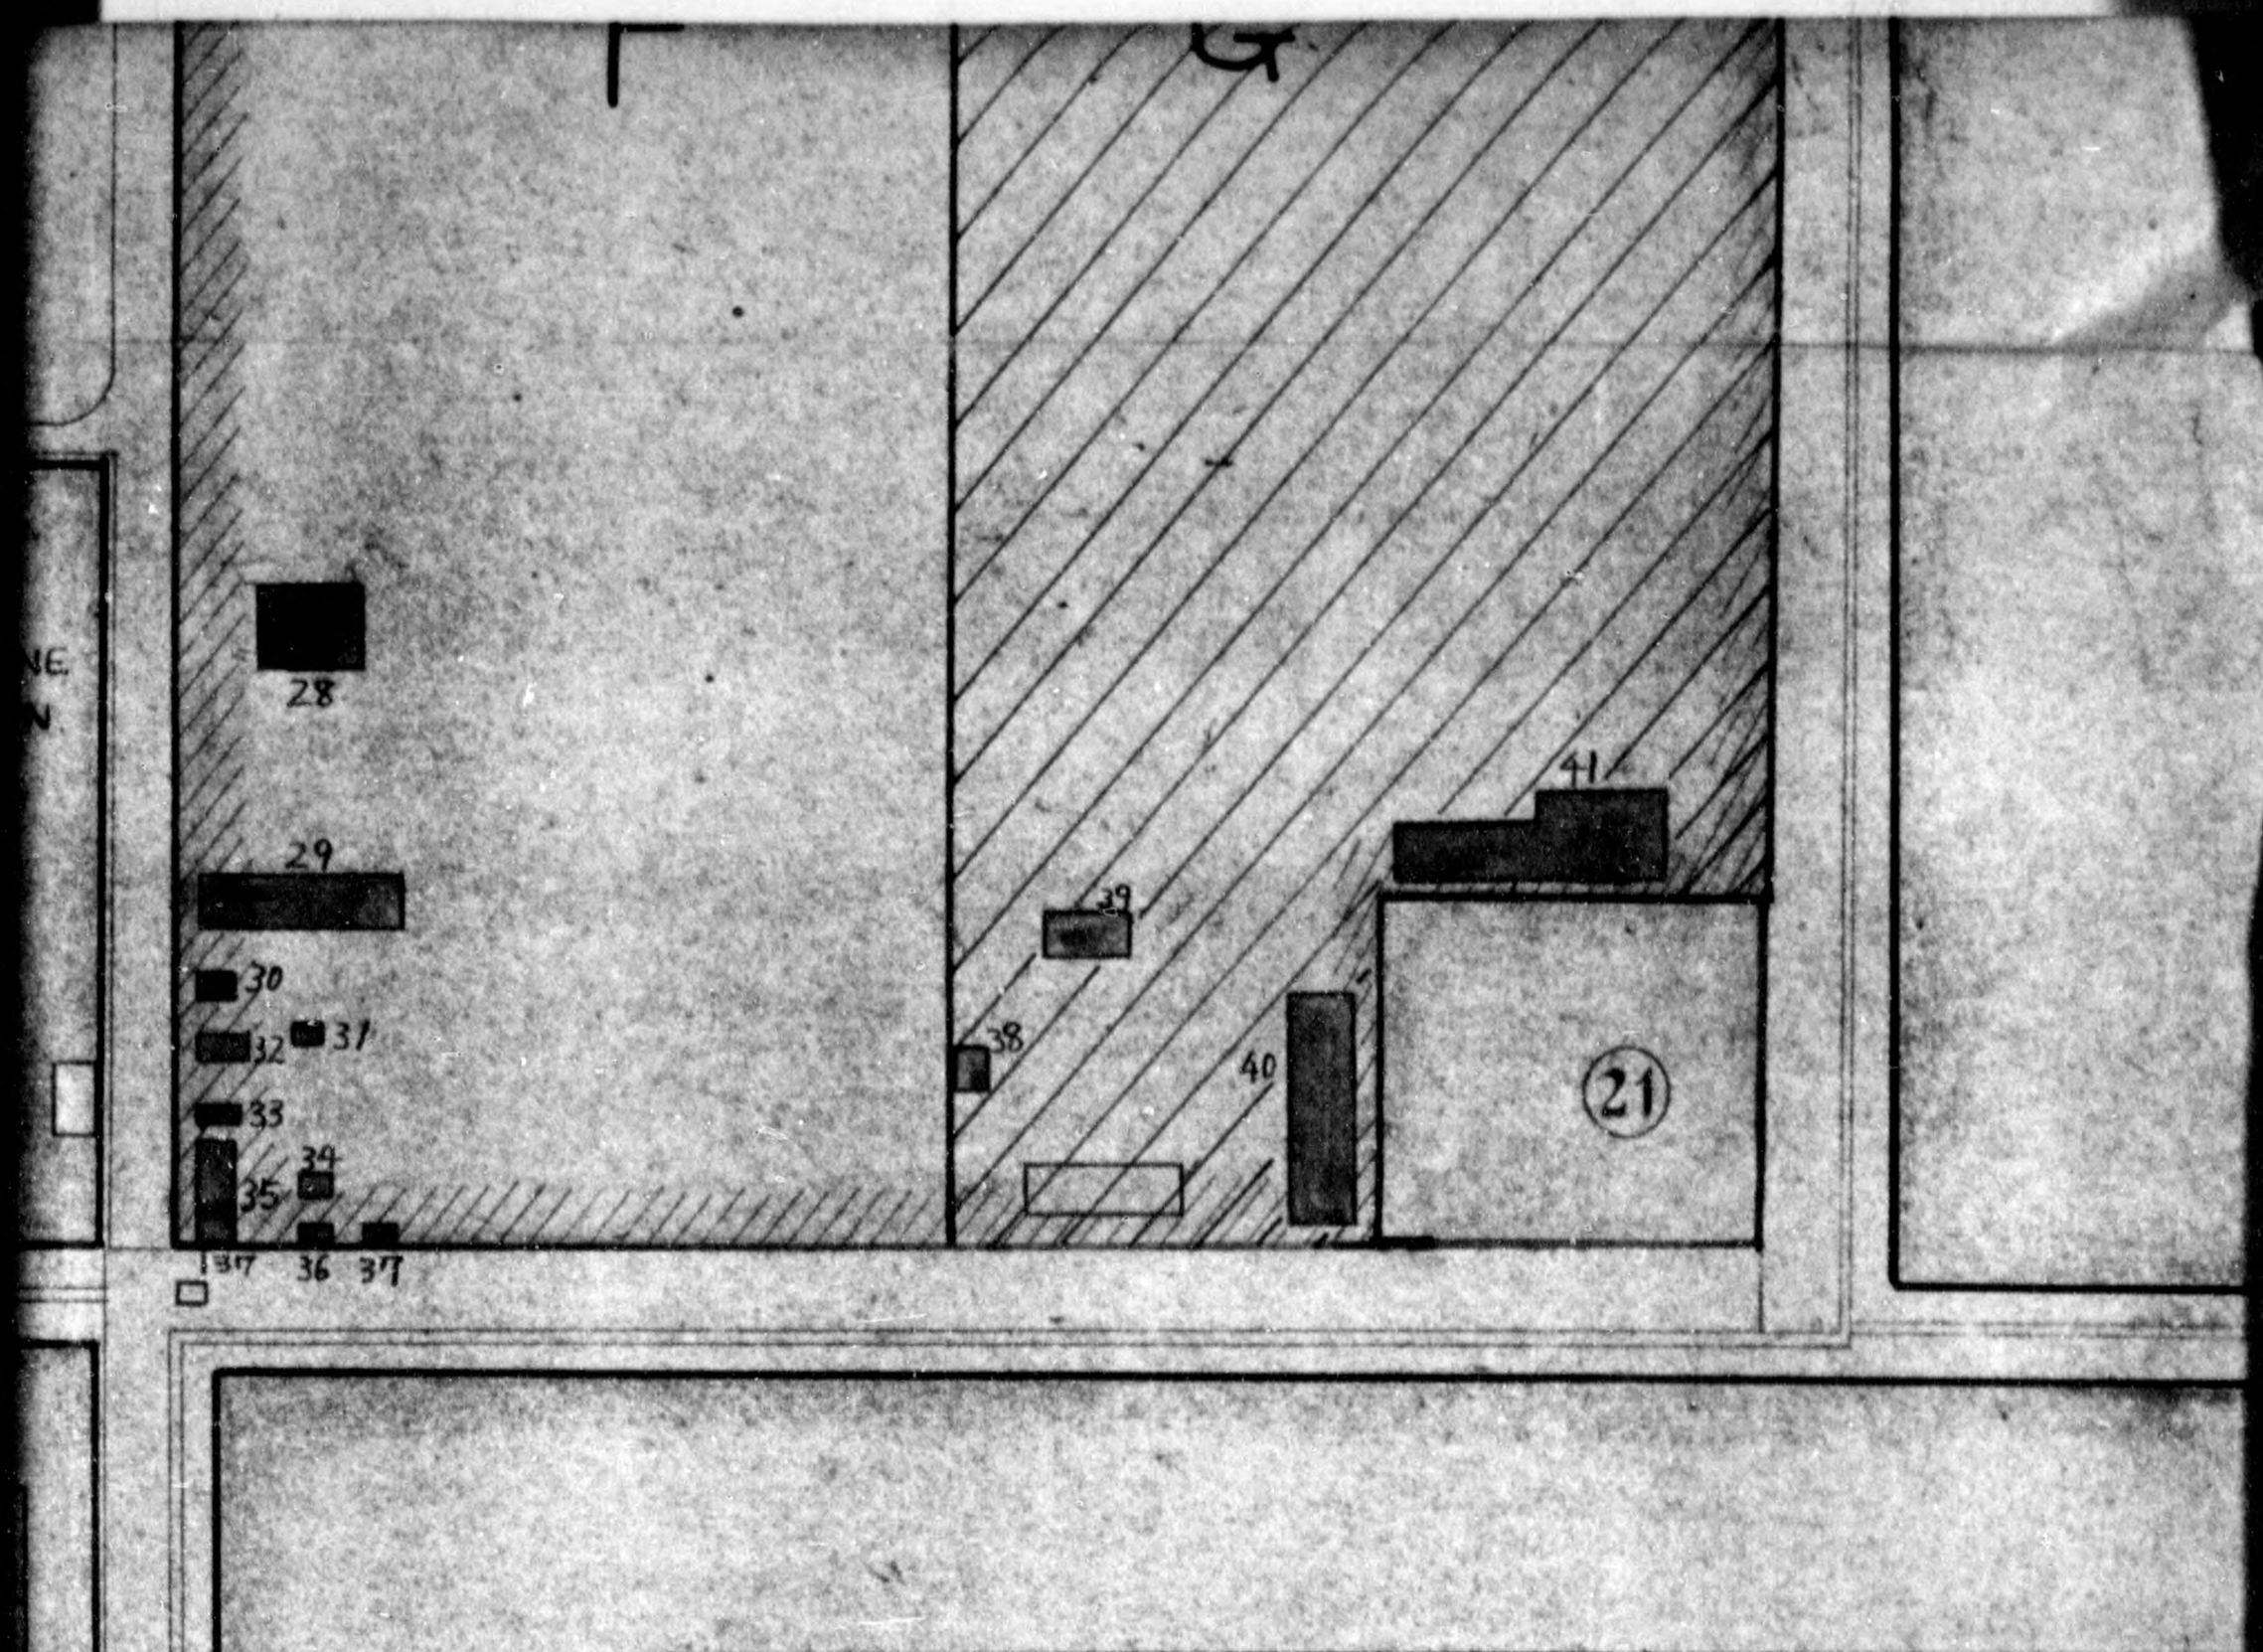

AREA NO	NAME OF PLANT	BLDG NO	NAME OF BUILDING
9	(CONTINUED) MISCELLANEOUS EQUIPMENT	65	MATERIALS WAREHOUSE
		66	PRINTING SHOP
		67	GARAGE
		68	WAREHOUSE
		69	LOCKER HOUSE
		70	DOCUMENTS HOUSE
		71	FACTORY OFFICE
		72	SWITCH STATION
		73	GUIDE OFFICE
		74	WAREHOUSE
10	HYDROGENATION PLANT POLYMERIZATION PLANT	75	SWITCH STATION
		76	PUMP HOUSE
		77	NAVY 96 TYPE HYDROGENATION EQUIP
		78	LOCKER HOUSE
		79	GAS POLYMERIZATIONS PUMP HOU
11	WATER GAS CONVERTOR WATER GAS PRODUCER METHANE CRACKING PLANT HYDROGEN GENERATING PLANT CATALYST PLANT	80	MATERIALS WAREHOUSE
		81	1ST CATALYST SHOP
		82	WATER GAS CONVERSION HOU
		83	WATER GAS PRODUCTING HOU
		84	NAVY 96 TYPE WATER GAS CONVERSION
		184	SWITCH STATION
		85	MANUFACTURED CATALYST HOUS
		86	LOCKER HOUSE

DECLASSIFIED E.O. 12065 SECTION 3-402 / NNDB NO.

TOKUYAMA WAN

AREA NO.	NAME OF PLANT	BLDG NO.	NAME OF BUILDING
	(CONTINUED)	87	WATCHMAN STA
		88	PUMP HOUSE
		89	SPOT OFFICE
(12)	1ST WATER PUMP PLANT 2ND. WATER PUMP PLANT	90	TRANSPORTION O
		91	WAREHOUSE
		92	PUMP HOUSE
		93	WAREHOUSE
		94	FOAMITE PUMP
		95	GENERATOR RO
		96	BATTERY ROO
		97	MATERIALS WAR
(13)	ELECTRIC POWER PLANT	98	ELECTRIC TESTI
		99	ELECTRIC REPAI
		100	MATERIALS WARE
		101	SWITCH STATION
		102	CURRENT LIMITIN
		103	3RD CRACKING P
		104	2ND. CRACKING P
		105	LOCKER HOUSE
		106	1ST CRACKING P
	2ND. BOILER PLANT	107	COOLING WATER
	1ST. CRACKING PLANT	108	4TH CRACKING P
(14)	2ND CRACKING PLANT.	109	OIL TANK HOUS
	3RD CRACKING PLANT	110	OIL TANK HOUS
	4TH. CRACKING PLANT	111	COAL WAREHOUSE
	DE-ASPHALTING PLANT	112	2ND. BOILER HOUS
	DRUM CLEANING PLANT	113	TOILET
		114	DE-ASPHALTING PLA
		115	WATCHMAN STATION
		116	SOLDERING IRON HE
		117	CAN PACKING SHO
		118	CAN REPAIRING SH
(15)	CAN MANUFACTURING PLANT	119	MANUFACTURED GOOD
		120	TOILET
		121	TOILET
		122	BOX MANUFACTURING
		123	CAN MANUFACTURING
		124	MATERIALS WAREHOU
		125	LOCKER HOUSE
		126	COAL WAREHOUSE
(16)	1ST CRUDE OIL DISTILLATION PLANT	127	2ND CRUDE OIL DISTILLATIO
	2ND CRUDE OIL DISTILLATION PLANT	128	VACUUM DISTILLATION PL

NAME OF BUILDING
ALS WAREHOUSE
NG SHOP
GE
HOUSE
ER HOUSE
ENTS HOUSE
RY OFFICE
H STATION
OFFICE
HOUSE
H STATION
HOUSE
96 TYPE HYDROGENATION EQUIPMENT HOUSE
ER HOUSE
POLYMERIZATIONS PUMP HOUSE
RIALS WAREHOUSE
CATALYST SHOP
ER GAS CONVERSION HOUSE
ER GAS PRODUCTING HOUSE
96 TYPE WATER GAS CONVERSION HOUSE
CH STATION
UFACTURED CATALYST HOUSE
KER HOUSE

DECLASSIFIED E.O. 12065 SECTION 3-402 / NNDG NO.

NAME OF BUILDING
AN STATION
HOUSE
FFICE
RTION OFFICE
OUSE
HOUSE
OUSE
PUMP HOUSE
TOR ROOM
Y ROOM
ALS WAREHOUSE
C TESTING HOUSE
C REPAIRING SHOP
LS WAREHOUSE
STATION
T LIMITING REACTOR HOUSE
ACKING PLANT PUMP HOUSE
ACKING PLANT PUMP HOUSE
HOUSE
ACKING PLANT PUMP HOUSE
G WATER PUMP HOUSE
ACKING PLANT PUMP HOUSE
NK HOUSE
NK HOUSE
AREHOUSE
OILER HOUSE
ALTING PLANT PUMP HOUSE
AN STATION
NG IRON HEATING SHOP
ACKING SHOP
EPAIRING SHOP
CTURED GOODS WAREHOUSE
NUFACTURING SHOP
NUFACTURING SHOP
LS WAREHOUSE
HOUSE
WAREHOUSE
OIL DISTILLATION PLANT PUMP HOUSE
DISTILLATION PLANT BOILER HOUSE

AREA NO	NAME OF PLANT	BLDG NO	NAME OF BUILDING
16	(CONTINUED)	129	LOCKER HOUSE
	1ST VACUUM DISTILLATION PLANT	130	VACUUM DISTILLATION PLANT PUMP
		131	OIL LABORATORY
17	FOAMIT FIRE FIGHTING EQUIPMENT	132	DRUGS WAREHOUSE
	OIL BLENDING PLANT	133	OIL TANKS HOUSE
		134	FOAMITE PUMP HOUSE
18	3RD CRUDE OIL DISTILLATION PLANT	135	FRACTIONAL DISTILLATION PLANT PUMP
	FRACTIONAL DISTILLATION PLANT	136	1ST CRUDE OIL DISTILLATION PUMP HO
	DISTILLATION PLANT (BATCH TYPE)		
	GASOLINE TREATING PLANT		
19	KEROSENE TREATING PLANT		
20	1ST BOILER PLANT		
21	TURPENTINE DISTILLING PLANT	137	WATCHMAN STATION
	3RD WATER PUMP PLANT		
	DRUM MANUFACTURING PLANT		
		138	WATCHMAN STATION
		139	CENTRAL OIL PUMP HOUSE
	SYNTHETIC MATHANOL PLANT	140	NAVY 98 TYPE WATER GAS GENERAT
22	WATER GAS GENERATOR	141	TOILET
	5TH BOILER PLANT	142	5TH BOILER HOUSE
		143	LANCASHIRE BOILER HOUSE
		144	MATERIALS WAREHOUSE
		145	HYDROGEN GAS PRODUCTING HOU
		146	HYDROGEN GENERATING SHOP
		147	SYNTHSTIC METHANOL AND ITS REFINING
		148	WAREHOUSE
		149	GLASS MANUFACTURING SHOP
		150	WATCHMAN STATION
		151	WATCHMAN STATION
23	DRUM MANUFACTURING PLANT	152	TOILET
	DRUM CLEANING, FILLING	153	DRUM WAREHOUSE
	AND REPAIRING PLANT	154	DRUM WAREHOUSE
		155	CARBIDE WAREHOUSE
	[redacted]		

DECLASSIFIED E.O. 12065 SECTION 3-402 / NNDG NO: 776845

AREA NO	NAME OF PLANT	BLDG NO	NAME OF BUILDING
(16)	(CONTINUED)	129	LOCKER HOUSE
	1ST VACUUM DISTILLATION PLANT	130	VACUUM DISTILLATION PLANT PUMP HOUSE
		131	OIL LABORATORY
(17)	FOAMIT FIRE FIGHTING EQUIPMENT	132	DRUGS WAREHOUSE
	OIL BLENDING PLANT	133	OIL TANKS HOUSE
		134	FOAMITE PUMP HOUSE
	3RD CRUDE OIL DISTILLATION PLANT	135	FRACTIONAL DISTILLATION PLANT PUMP HOUSE
(18)	FRACTIONAL DISTILLATION PLANT	136	1ST CRUDE OIL DISTILLATION PUMP HOUSE
	DISTILLATION PLANT (BATCH TYPE)		
	GASOLINE TREATING PLANT		
(19)	KEROSENE TREATING PLANT		
(20)	1ST BOILER PLANT		
(21)	TURPENTINE DISTILLING PLANT	137	WATCHMAN STATION
	3RD WATER PUMP PLANT		
	DRUM MANUFACTURING PLANT		
		138	WATCHMAN STATION
	SYNTHETIC MATHANOL PLANT	139	CENTRAL OIL PUMP HOUSE
(22)	WATER GAS GENERATOR	140	NAVY 98 TYPE WATER GAS GENERATING HOUSE
	5TH BOILER PLANT	141	TOILET
		142	5TH BOILER HOUSE
		143	LANCASHIRE BOILER HOUSE
		144	MATERIALS WAREHOUSE
		145	HYDROGEN GAS PRODUCTING HOUSE
		146	HYDROGEN GENERATING SHOP
		147	SYNTHSTIC METHANOL AND ITS REFINING SHOP
		148	WAREHOUSE
		149	GLASS MANUFACTURING SHOP
		150	WATCHMAN STATION
		151	WATCHMAN STATION
(23)	DRUM MANUFACTURING PLANT	152	TOILET
	DRUM CLEANING, FILLING	153	DRUM WAREHOUSE
	AND REPAIRING PLANT	154	DRUM WAREHOUSE
		155	CARBIDE WAREHOUSE
	[redacted]		

DECLASSIFIED E.O. 12065 SECTION 3-402 / NNDG NO. 770815

Number of building	Area (tsubo)	Released or Unrelereased	Quantity in Custody	Name of Buyer or Temporary User and Others
1	104.00			Temporary use by Hikari Branch, Hatabu Workshop, Hiroshima R.R. Division
2	3,035.00		870	Partially temporary use by Hikari Branch, Hatabu Workshop, Hiroshima R.R. Division
3	1,694.50			Temporary use by Hikari Branch, Hatabu, Workshop, Hiroshima R.R.D.
4	8.25			
5	1,950.00			ditto
6	240.00			ditto
7	19.25			
8	445.00			ditto
9	220.00			ditto
10	345.00			ditto
11	11.00			
12	240.00	Released on 11, Feb. '48		Sold to Hikari Branch, Hatabu Workshop, Hiroshima R.R.Div.
13	408.00			Temporary use by Hikari Branch, Hatabu Workshop, Hiroshima R.R.D.
14	224.00	Released on 11, Feb.'48		Temporary use by Nishi Nippon Kosan K. K.
15.	8.25			
16	108.50		1	
17	50.00	Released on 11, Feb, '48		Sold to Nishi Nippon Kosan K.K

DECLASSIFIED E.O. 12065 SECTION 3-402 / NNBG NO: 77-0-15

Number of building	Area (tsubo)	Released or Unreleased	Quantity in Custody	Name of Buyer or Temporary User and others
18	340.00	Released on 11, Feb.'48		Sold to Yawata Steel Foundary Works, Nippon Seitetsu K.K.
19	13.20			
20	82.50	Released on 11, Feb.'48		Ditto
21	15.00		3	
22	900.00	Released on 11, Feb.'48		ditto
23	975.00	Released on 11. Feb.'48		ditto
24	23.70		3	
25	1,300.00	Released on 11, Feb. '48		Sold to Tokuyama Eigeki K.K. (Cinema Theatre)
26	1,200.00	Released on 11. Feb. '48		roceeding to sell
27	53,00		17	
28	1,601.25	Released on 11, Feb. '48	79	
29	169.00	Released on 11, Feb. '48	61	
30	275.00	Released on 11, Feb. '48		Temporary Use by Hikai Pulp K.K.
31.	151.25	Released on 11, Feb. '48		ditto
32	4.60	Released on 11, Feb. '48		ditto
33	9.00	Released on 11, Feb. '48		ditto

DECLASSIFIED E.O. 12065 SECTION 3-402 / NNDG NO. 779879

Number of building	Area (tsubo)	Released or Unreleased	Quantity in Custody	Name of Buyer or Temporary User and Others
34	325.50		15	
35	6.00			
36	233.75	Released on 11, Feb. '48		Sold to Yawata Steel Foundary Works, Nippon Seitetsu K.K.
37	672.30			
38	2,151.10		69	
39	125.00	Released on 11, Feb. '48		
40	5.60			
41	112.00		6	
42	9.00			
43	111.52		5	
44	1,082.60		13	
45	391.40		38	
46	14.00			
47	213.30		6	
48	3,593.04	Released on 11, Feb. '48	27	
49	848.00	Released on 11, Feb. '48		Sold to Yawata Steel Foundary Works, Nippon Seitetsu K.K.
50	497.00	Released on 11, Feb. '48		ditto
51	7.50		3	
52	17.50			
53	4.00			

DECLASSIFIED E.O. 12065 SECTION 3-402 / NNDG NO. 779913

Number of building	Area (tsubo)	Released or Unreleased	Quantity in Custody	Name of Buyer or Temporary User and Others
54	1,706.90	Released on 11, Feb.'48		Sold to Yawata Steel Foundary Works, Nippon Seitetsu K. K.
55	51.00			
56	351.48	Released on 11, Feb. '48		ditto
57	64,80	Released on 11, Feb.'48		ditto
58	192,50	Released on 11, Feb. '48	62	
59	2,086.00	Released on 11, Feb. '48		ditto
60	21.75			
61	852.44			
62	1,385.80			
63	6.75			
64	6,133.57		1,012	
65	496.00	Released on 11, Feb. '48		
66	11.40			
67	15.75		3	
68	1,320.00	Released on 11, Feb. '48		Sold to Hikari Municipal Office.
69	1,310.00	Released on 11, Feb. '48		ditto
70	60.00	Released on 11, Feb.'48		ditto
71	1,570.40	Released on 11, Feb. '48	20	

DECLASSIFIED E.O. 12065 SECTION 3-402 / NNDG NO: 779815

Number of building	Area (tsubo)	Released or Unreleased	Quantity in Custtody	Name of Buyer or Temporary User and Others
72	14.00		3	
73	5.60			
74	21.00		3	
75	4,370.25	Released on 11,Feb. '48		Sold to Hiroshima Prefecture Gov't
76	249.30	Released on 11,Feb. '48		
77	5.40			
78	1,103.49	Released on 11,Feb. '48		Sold to Yawata Steel Foundary Works, Nippon Seitetsu K. K.
79	605.01	Released on 11,Feb. '48		ditto
80	15.81		5	
81	750.96	Released on 11,Feb. '48		ditto
82	13.50		7	
83	537.00	Released on 11,Feb. '48		ditto
84	47.61	Released on 11,Feb. '48		
85	12,60			
86	300,00	Released on 11,Feb. '48		ditto
87	159.00		1	
88	25.20	Released on 11,Feb.'48		

DECLASSIFIED E.O. 12065 SECTION 3-402 / NNDG NO. 779879

Number of building	Area (tsubo)	Released or Unreleased	Quantity on Custody	Name of Buyer or Temporary User and Others
89	18.30		3	
90	1,250.00		6	
91	6.80	Released on 11, Feb. '48		
92	17.10	Released on 11, Feb. '48		
93	35.10	Released on 11, Feb. '48		
94	12.25	Released on 11, Feb. '48		
95	257.95	Released on 11, Feb. '48		
96	302.32			Temporary Use by Takeda Pharmaceutical Indutries Co. Ltd.
97	185.40	Released on 11, Feb. '48		ditto
98	125.60			ditto
99	9.90			ditto
100	1,055.06	Released on 11, Feb. '48		Partially Temporary Use by Takeda Pharmaceutical Industries Co. Ltd.
101	155.87			ditto
102	20.88			
103	700.00	Released on 11, Feb. '48		Sold to Yawata Steel Foundary Works, Nippon Seitetsu K. K.
104	1,495.00	Released on 11, Feb. '48		ditto
105	8.40			
106	12.15			
107	1,447.50	Released on		

DECLASSIFIED E.O. 12065 SECTION 3-402 / NNDG NO. 779915

Number of building	Area (tsubo)	Released or Unreleased	Quantity in Custody	Name of Buyer or Temporary User and Others
107	1,247.00	Released on 11, Feb. '48		Sold to Yawata Steel Foundary Works, Nippon Seitetsu K. K.
108	16.00			
109	1,495.00	Released on 11, Feb. '48		ditto
110	8.40		2	
111	16.00			
112	1,196.00	Released on 11, Feb. '48		Sold to Yawata Steel Foundary Works, Nippon Seiyetsu K. K. Partially Temporary Use by Asahi Salt Mfg. Co Ltd.
113	1,196.00	Released half on 11, Feb.'48	6	Partially (about an half of) Temporary Use by Asahi Salt Mfg. Co. LTD.
114	16.00			Temporary Use by Asahi Salt Mfg. Co.
115	158.00			ditto
116	14.10			
117	1,495.00	Released on 11, Feb. '48	19	
118	11.49			
119	1,495.00		307	
120	11.40			
121	11.40			
122	30.74			
123	5.00			

DECLASSIFIED E.O. 12065 SECTION 3-402 / NNDG NO: 779913

Number of building	Area (tsubo)	Released or Unreleased	Quantity in Custody	Name of Buyer or Temporary User and Others
124	3.00			Used as a guard-box at the main gate
125	14.88	Released on 11, Feb. '48		Sold to Shimonoseki Gas Co. Ltd.
126	297.00			Temporary Use by Takeda Pharmaceutical Industries Co. Ltd.
127	9.57			ditto
128	6.60			ditto
129	324.90			ditto
130	446.00			ditto
131	74.50	Released on 11, Feb. '48	11	Partiall Temporary Use by Takeada Pharmaceutical Industries Co. Ltd
132	1,192.01	Released on 11, Feb. '48		Sold to Yawata Steel Foundary Works, Nippon Seitetsu K.K.
133	1,192.01	Released on 11, Feb. '48		ditto
134	200.00	Released on 11, Feb. '48		ditto
135	1,497.50	Released on 11, Feb. '48		ditto
136	1,000.00	Released on 11, Feb. '48		ditto
137	1,499.50	Released on 11, Feb. '48	17	Proceeding to sell
138	170.82			Temporary Use by Takeda Pharmaceutical Industries

DECLASSIFIED E.O. 12065 SECTION 3-402 / NNDG NO. 779015

Number of building	Area (tsubo)	Released or Unreleased	Quantity in Custody	Name of Buyer or Temporary User and Others
139	1,495.00			Temporary Use by Takeda Pharmaceutical Industries Co. Ltd.
140	11.40			ditto
141	16.24			ditto
142	11.40			
143	1,495.00			
144	17.78	Released on 11, Feb. '48	18	
145	400.00			Temporary Use by Takeda Pharmaceutical Industries Co. Ltd.
146	66.30			
147	5.00			
148	4.14			
149	94.50			
150	244.79			Temporary Use by Takeda Pharmaceutical Industries Co. Ltd.
151	7.26			ditto
152	244.75			ditto
153	6.00			
154	565.80			ditto
155	11.25			ditto
156	70,00			ditto
157	4.00			ditto

DECLASSIFIED E.O. 12065 SECTION 3-402 / NNDG NO. 779913

Number of building	Area (tsubo)	Released or Unreleased	Quantity in Custody	Name of Buyer or Temporary User and Others
158	65.00			Temporary Use by Takeda Pharmaceutical Industries Co. Ltd.
159	100.00			ditto
160	25.50			
161	4.40			
162	11.00			
163	11.00			
164	199.00		1	
165	1,850.00		926	
166	11.00			
167	7.04			
168	323.10			Temporary Use by Takeda Pharmaceutical Industries Co. Ltd.
169	352.00		29	
220	4.84			
221	1.21			
222	16.34			
223	6.35			
224	8.33			
225	7.56			
226	997.50	Released on 11, Feb. '48		Sold to Yamato Steel, Foundary Works, Nippon Seitetsu K.K.
227	722.80		1	
228	550.00			
229	25.71			Temporary Use by Hikari Municipal Office.

DECLASSIFIED E.O. 12065 SECTION 3-402 / NNDG NO. 119913

Number of building	Area (tsubo)	Released or Unreleased	Quantity in Custody	Name of Buyer or Temporary User and Others
230	26.31			Temporary Use by Hikari Municipal Office
231	6.35			ditto
232	14.82			ditto
233	1.82			ditto

Remarks:-

1. In the column of " Released or Unreleased " the blank lines show unreleased buildings.

2. " Quantity in Custody " means the equipment kept in Custody Shops , and there are many other equipments scattered out of building.

DECLASSIFIED E.O. 12065 SECTION 3-402 / NNDG NO: 119919

HIKARI BRANCH, HATABU WORKSHOP.
HIROSHIM R. R. DIVISION.
GROUND 26,012 TSUBO
BUILDING 7,892.25 TSUBO

NIPPON CHUKO K.K.,
RELEASED ON 9TH. AUG. 1948
GROUND 8,567.09 TSUBO

HIKARI PULP K.K.
RELEASED ON 9TH. FEB. 1948.
GROUND 6,901. TSUBO

HAITAN KODAN
GROUND 19.825 TSUBO

DECLASSIFIED E.O. 12065 SECTION 3-402 / NNDG NO: 119819

NISHI NIPPON KOSAN K.K.
RELEASED ON 9TH AUG. 1948.
TO WATER WORKS
GROUND 1,349.35 TSUBO

WATER SUPPLY SYSTEM

HIKARI CITY OFFICE
RELEASED ON 9TH. FEB. 1948.
GROUND 191,382.16 TSUBO

TOKUYMA TEPPAN K.K.
GROUND 110,396 TSUBO
BUILDING 14,489.61 "

RAIL

STATE

DECLASSIFIED E.O. 12065 SECTION 3-402 / NNDB NO: 119815

PLANT LAYOUT

HIKARI NAVAL ARSENAL (CODE No 45

MITSUI. HIKARI CITY. YAMAGUCHI PREFECTURE

SCALE 1/5000

N

NOTE

	AUTHORIZED USE	100
	RESTITUTION ITEMS	63
	OTHERS	70
	TOTAL	233

—·— BOUNDARY OF REPARATIO

BLDG OF

BUILDING CONSTRUCTION RATIO

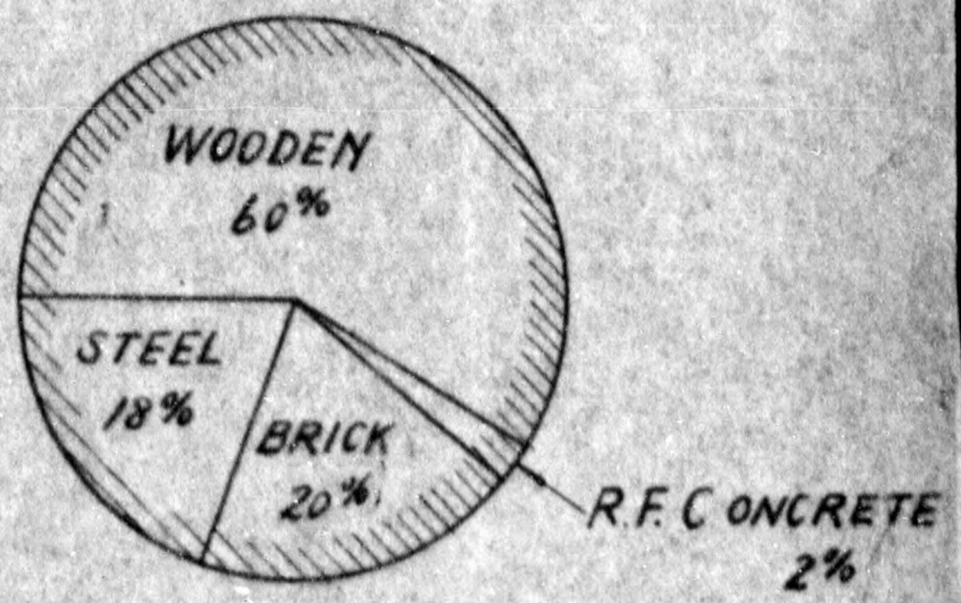

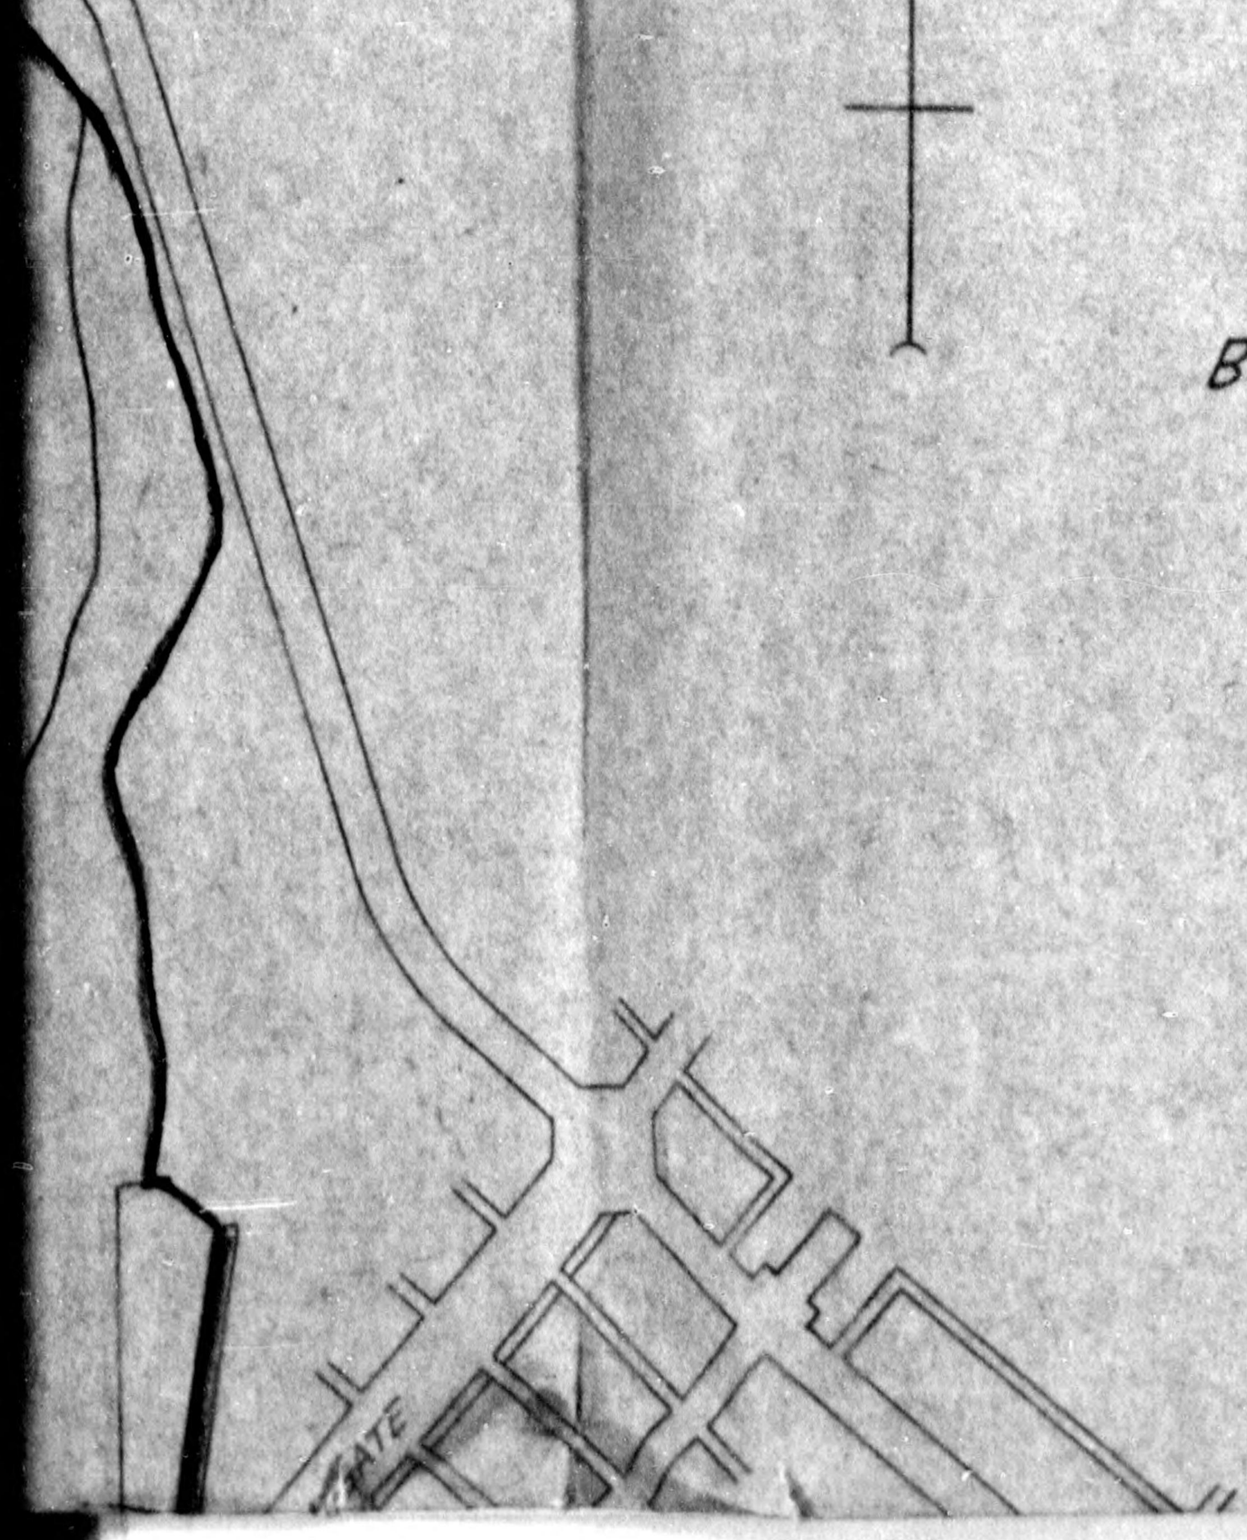

DECLASSIFIED E.O. 12065 SECTION 3-402 / NNBG NO: 77-0015

OUT

(CODE Nº 45-4)

REFECTURE

BLDG OF ITEM

AUTHORIZED USE 100

RESTITUTION ITEMS 63

OTHERS 70

TOTAL 233

BOUNDARY OF REPARATION AREA

UCTION RATIO

R.F.C ONCRETE
2%

NOTE;

AREA IN CUSTODY

AREA RELEASED

AREA IN AUTHORIZED USE

AREA, APPLIED

AREA SOLD

BUILDING IN CUSTODY

BUILDING SOLD

BUILDING APPLIED

BUILDING RELEASED BUT UNREMOVED (EXCEPT CUSTODY SHOP)

EX-BUILDING

BUILDING IN AUTHORIZED USE.

DECLASSIFIED E.O. 12065 SECTION 3-402 / NNBG NO.

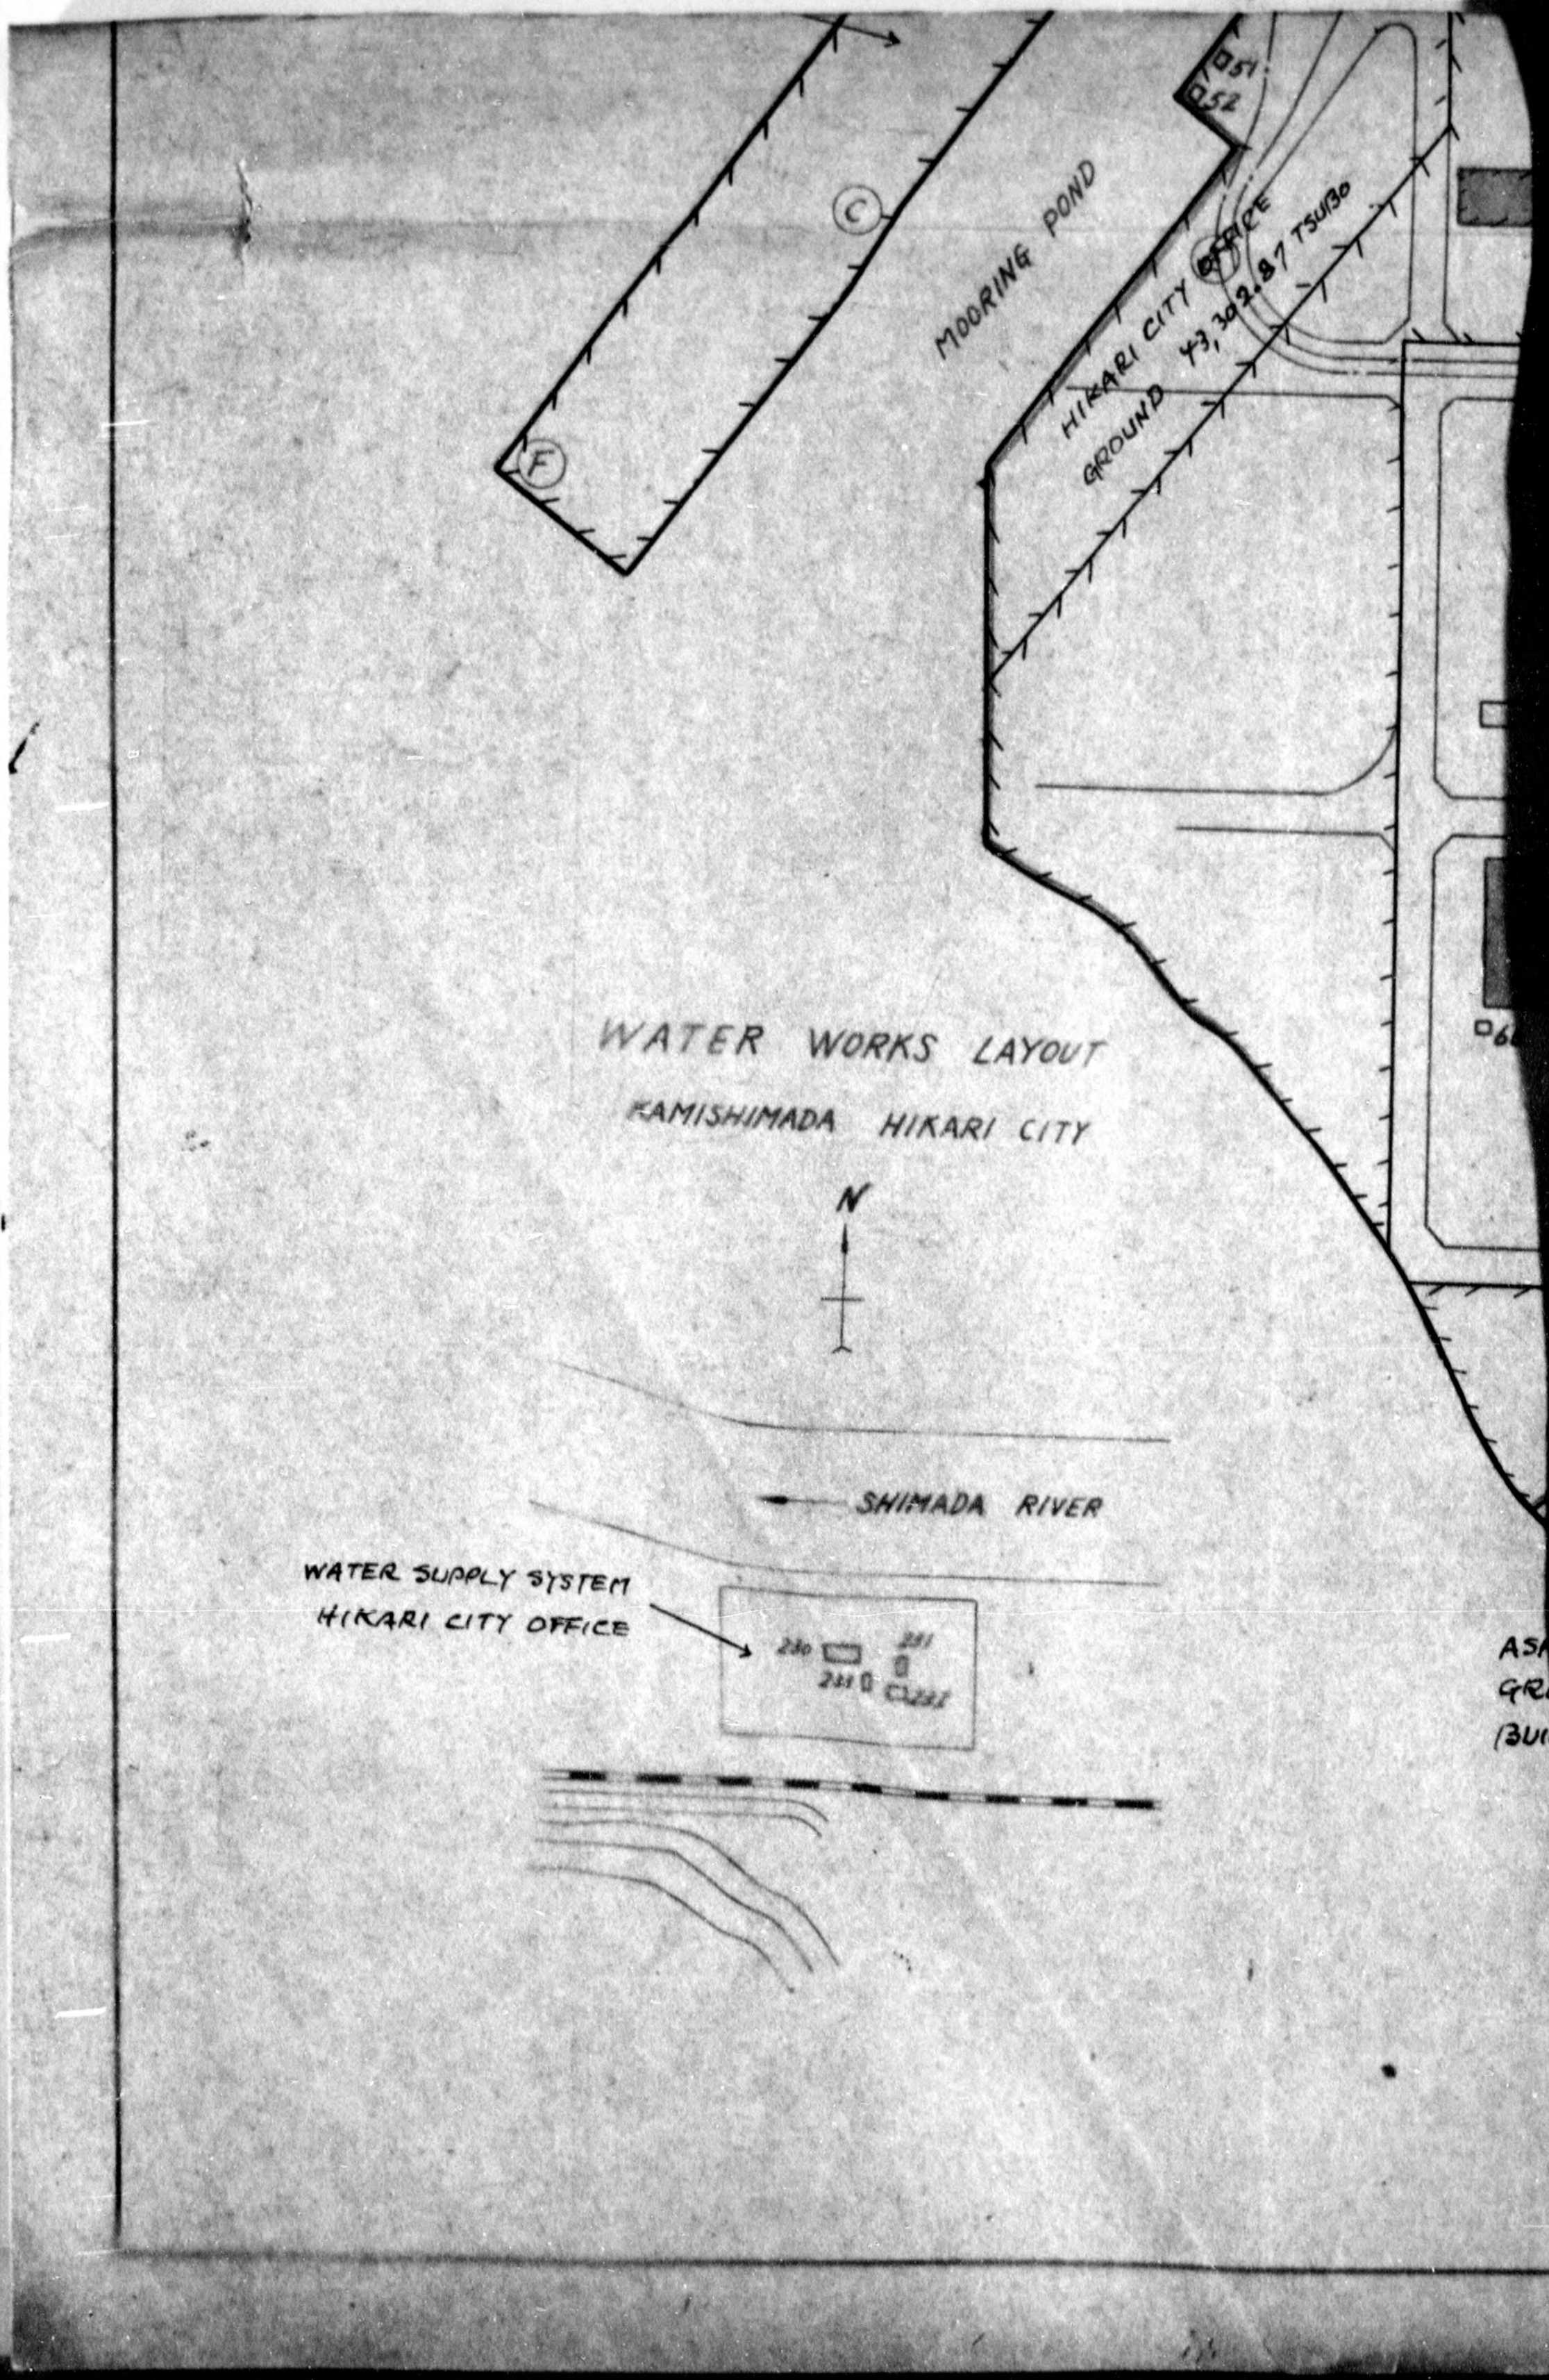

DECLASSIFIED E.O. 12065 SECTION 3 402 7 NARS NO.

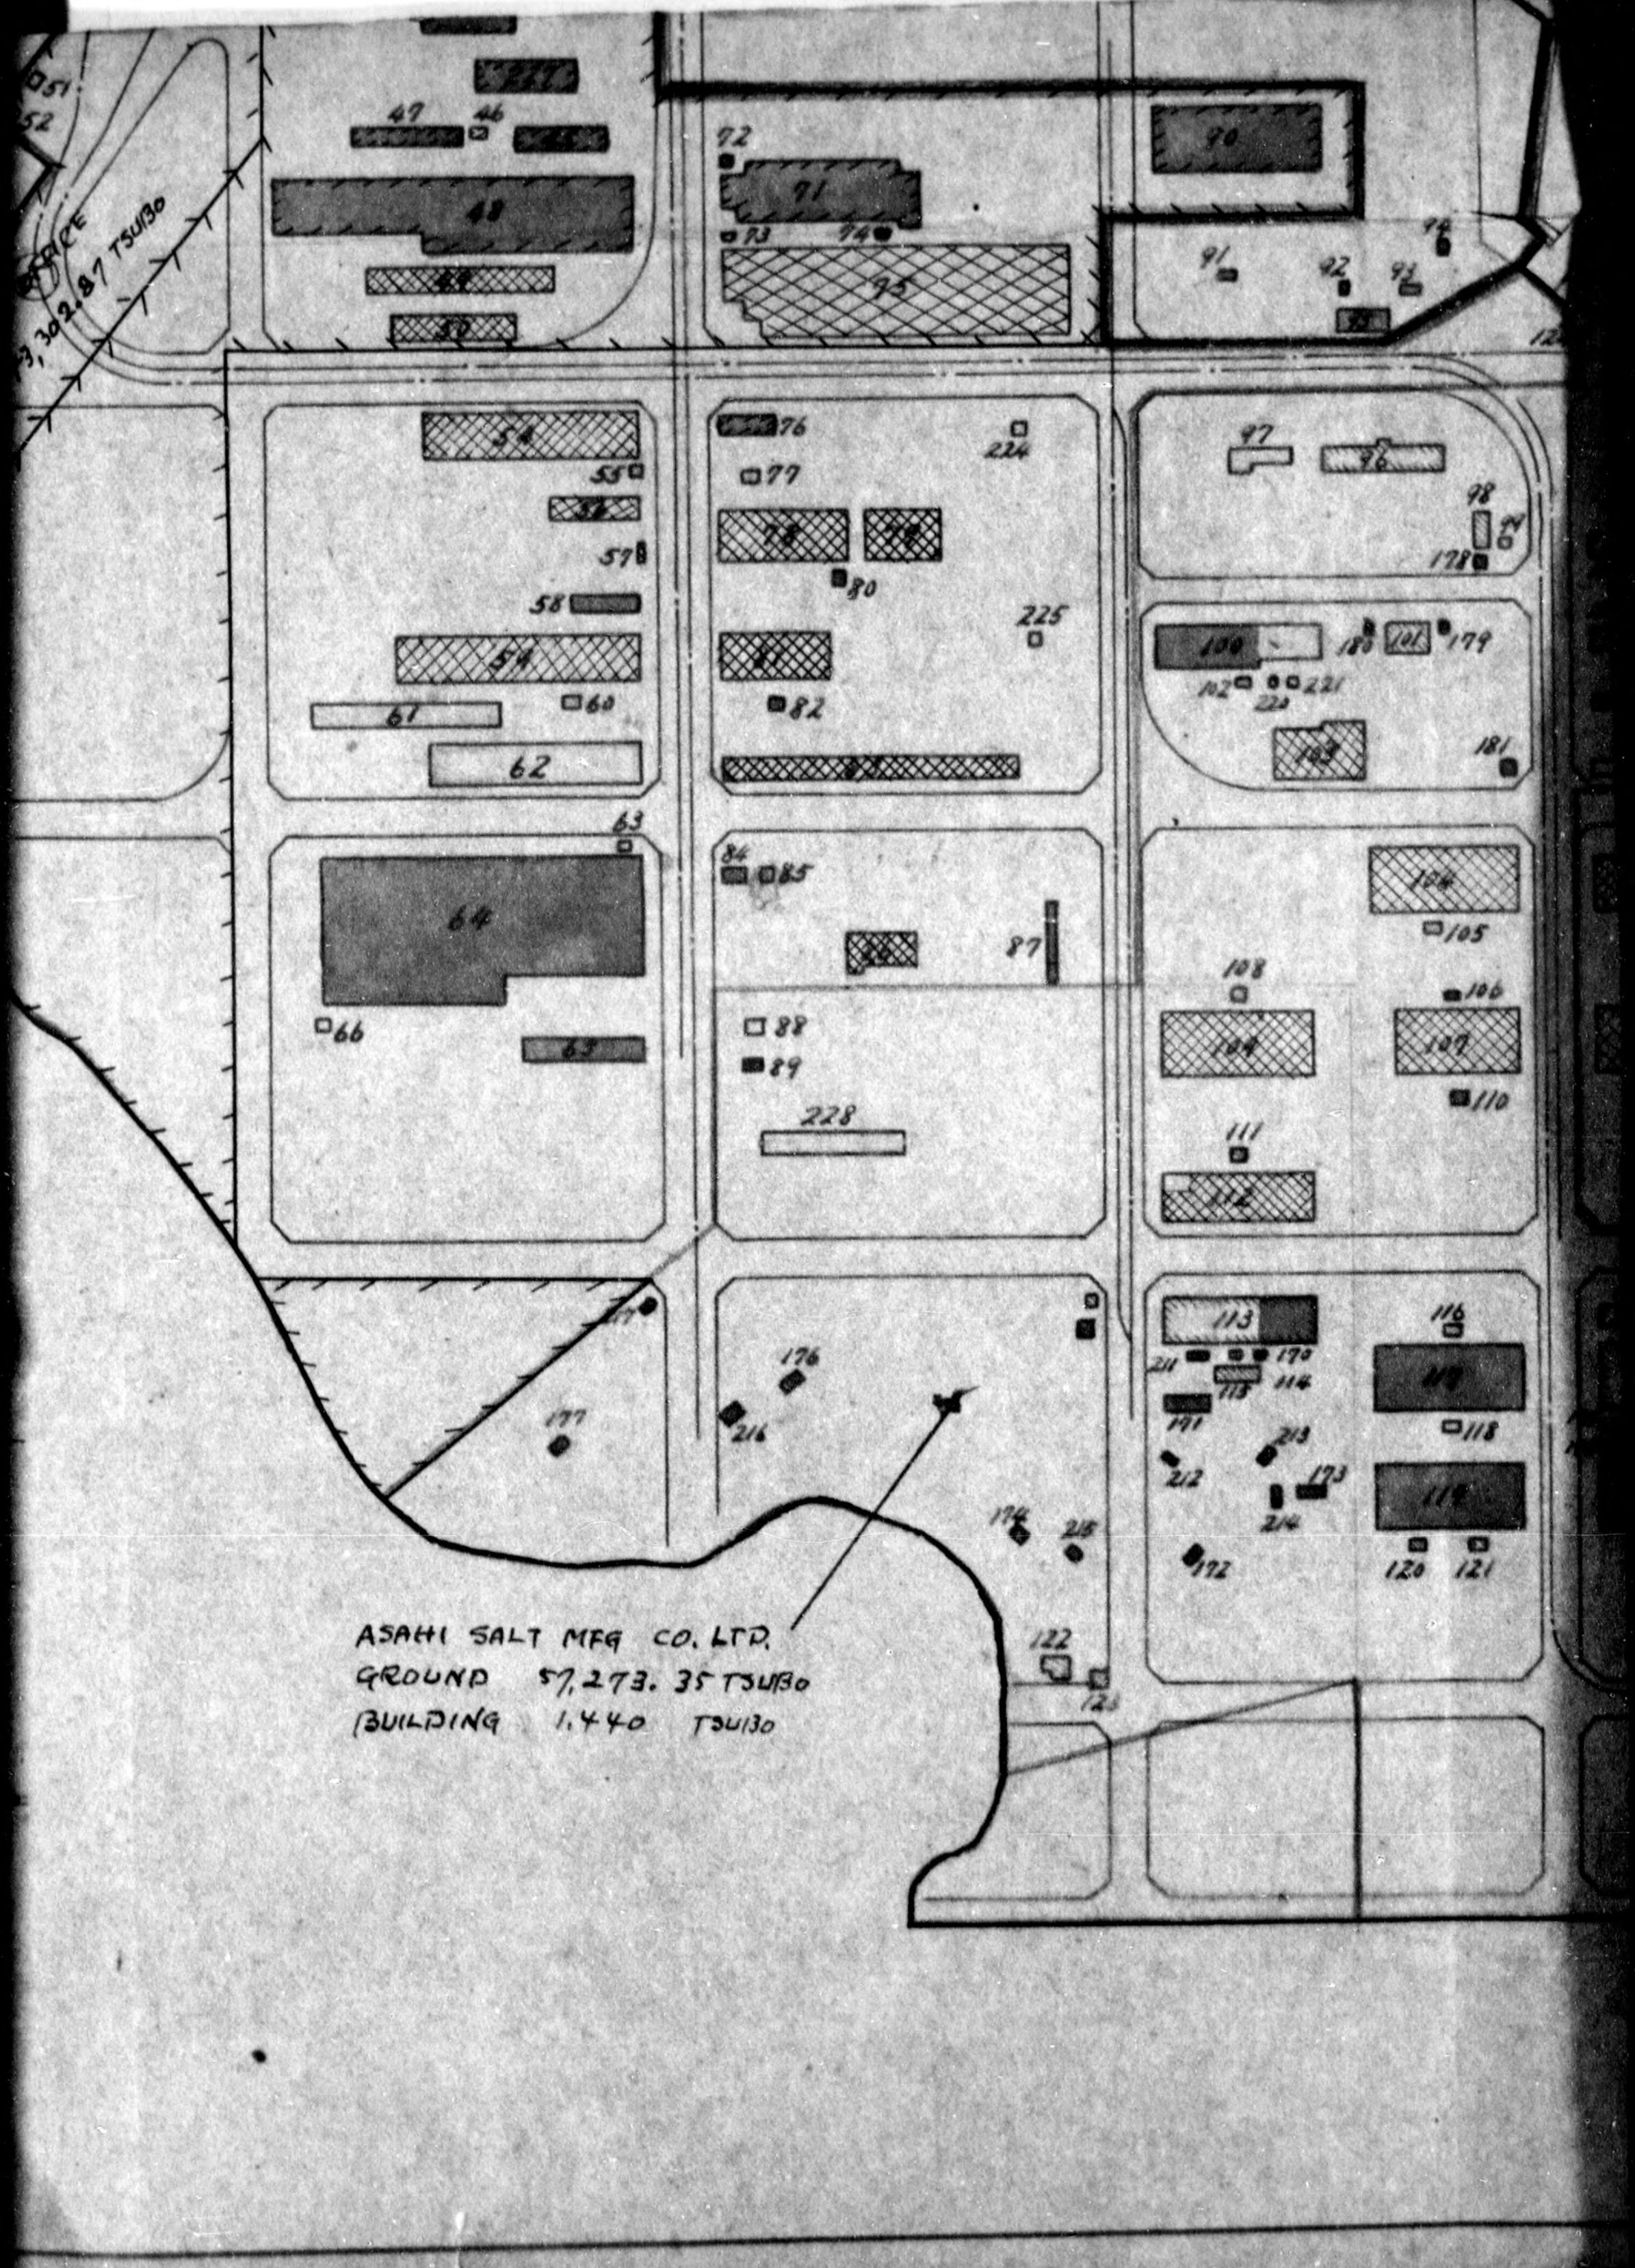

DECLASSIFIED E.O. 12065 SECTION 3 402 7 NARS NO

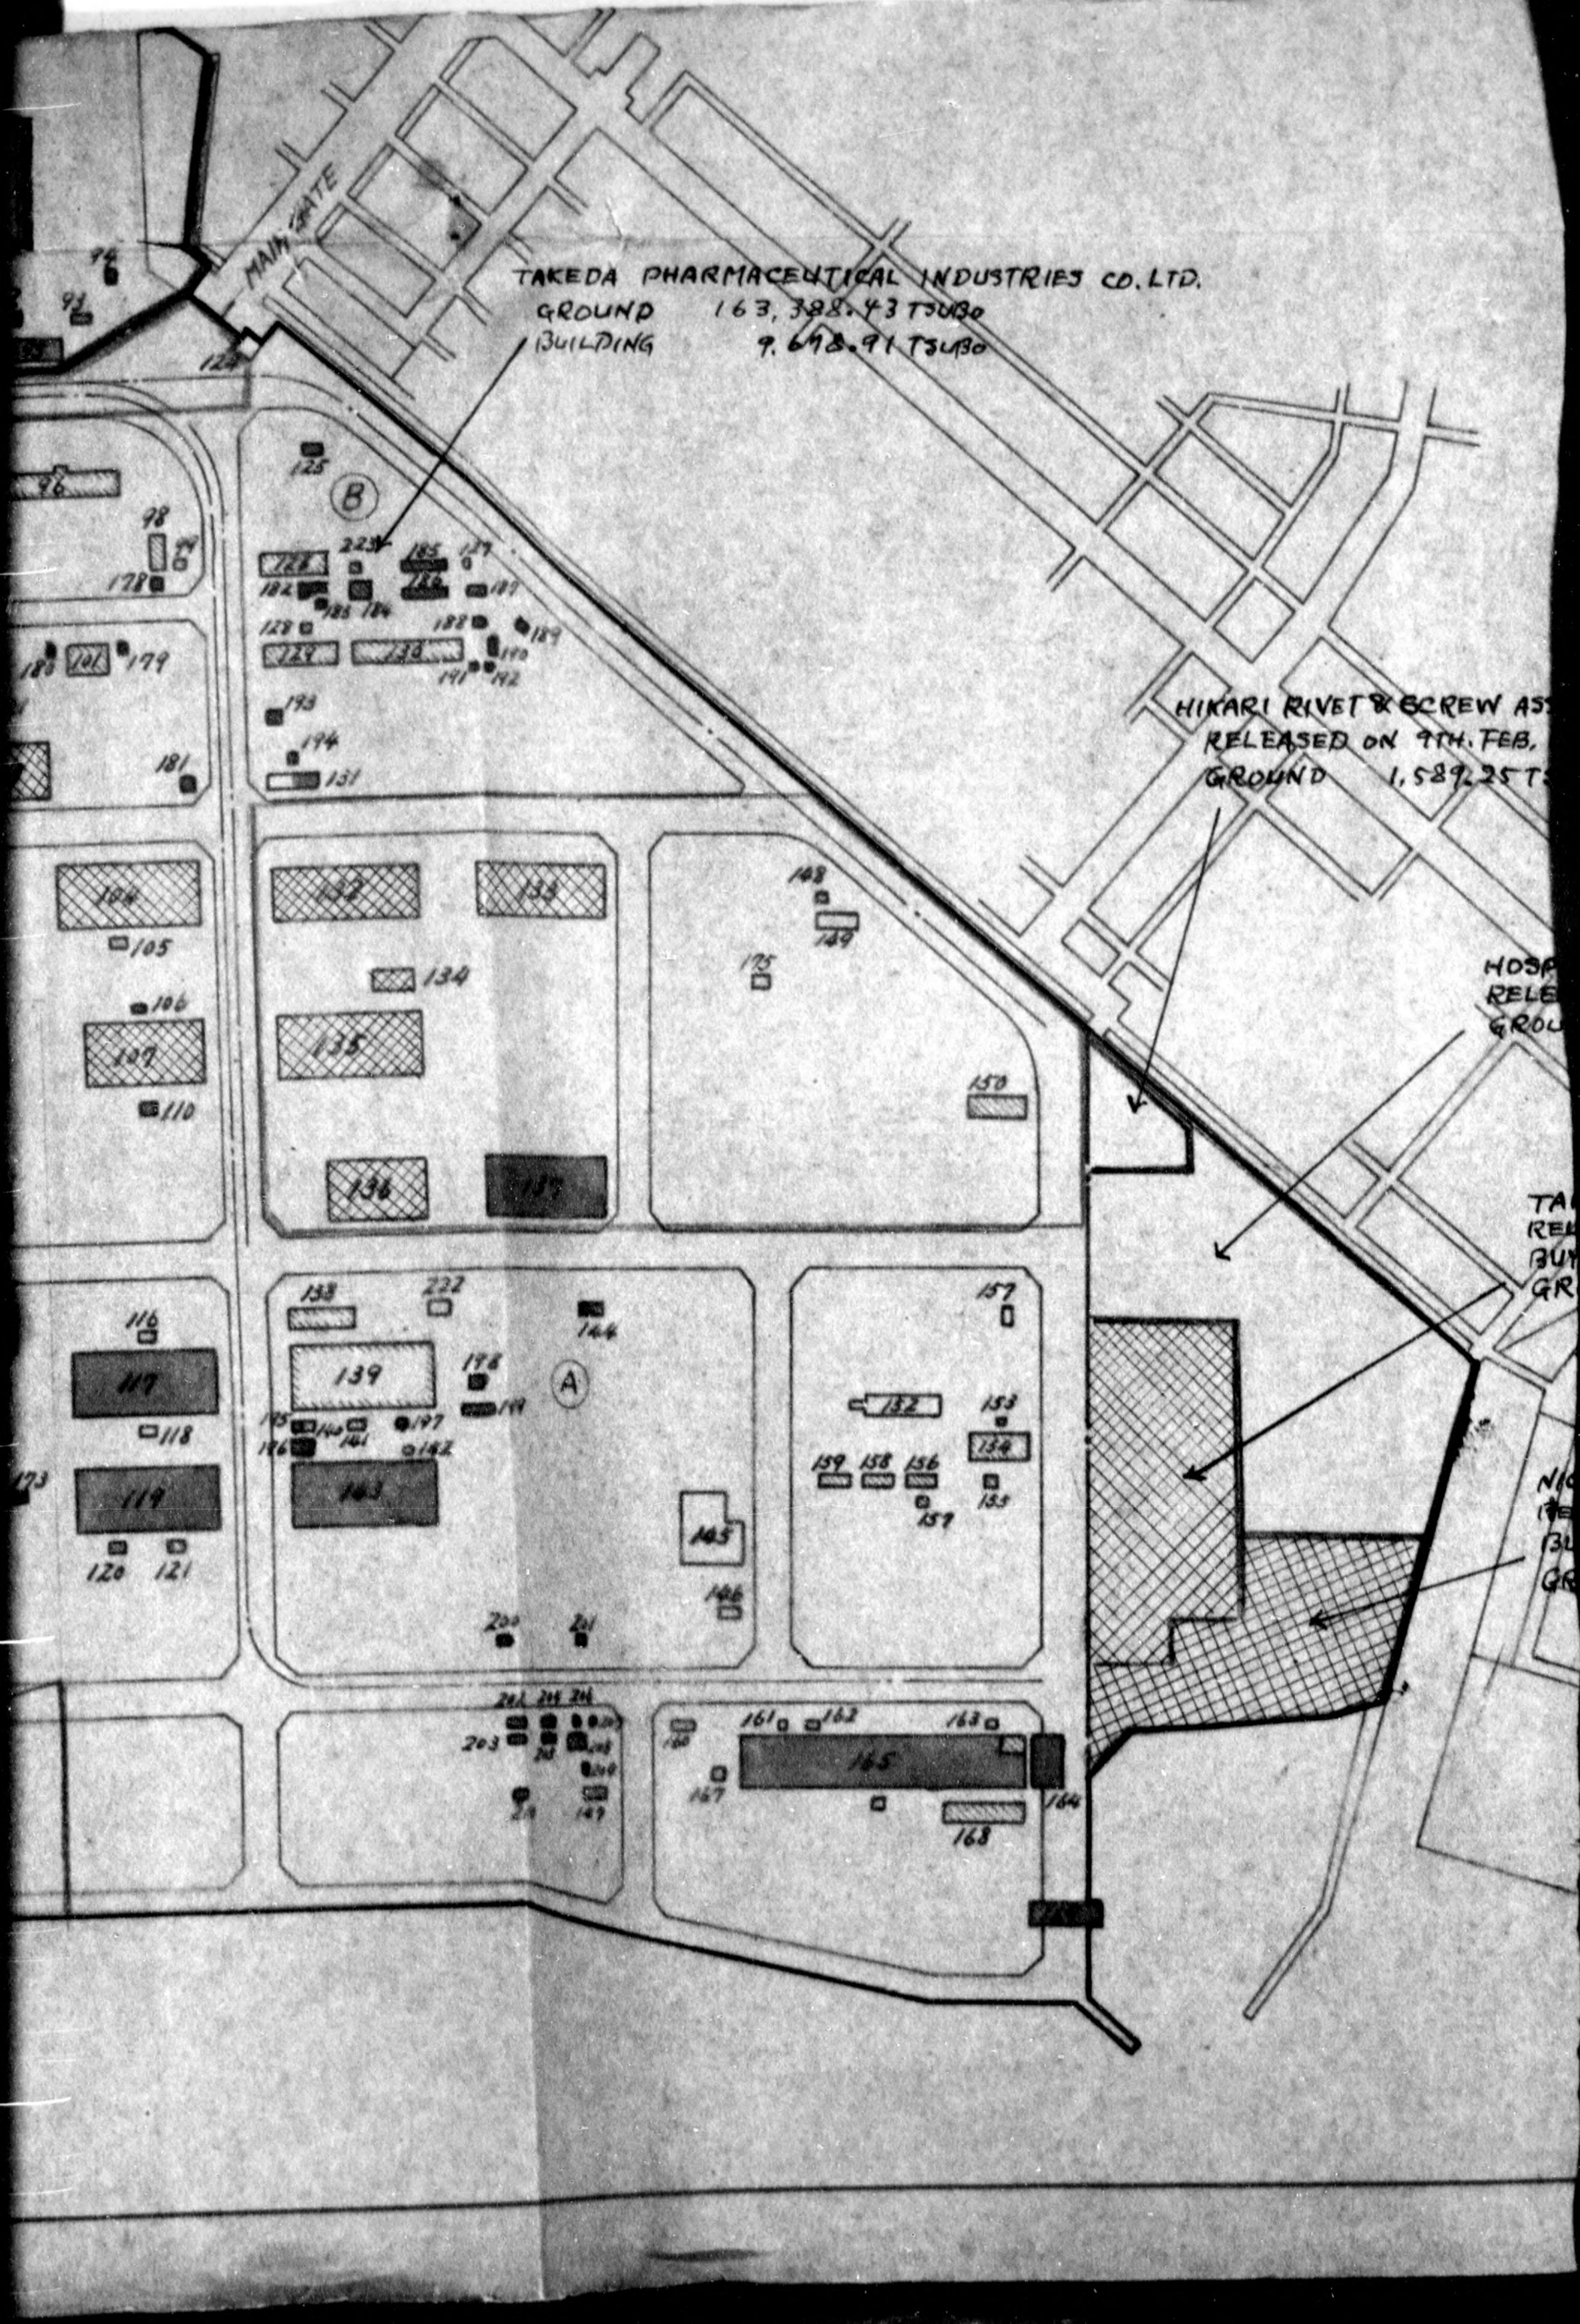

DECLASSIFIED E.O. 12065 SECTION 3 (E) 1 AND/OR 2

BUILDING APPLIED

BUILDING RELEASED BUT UNREMOVED (EXCEPT CUSTODY SHOP)

EX-BUILDING

BUILDING IN AUTHORIZED USE.

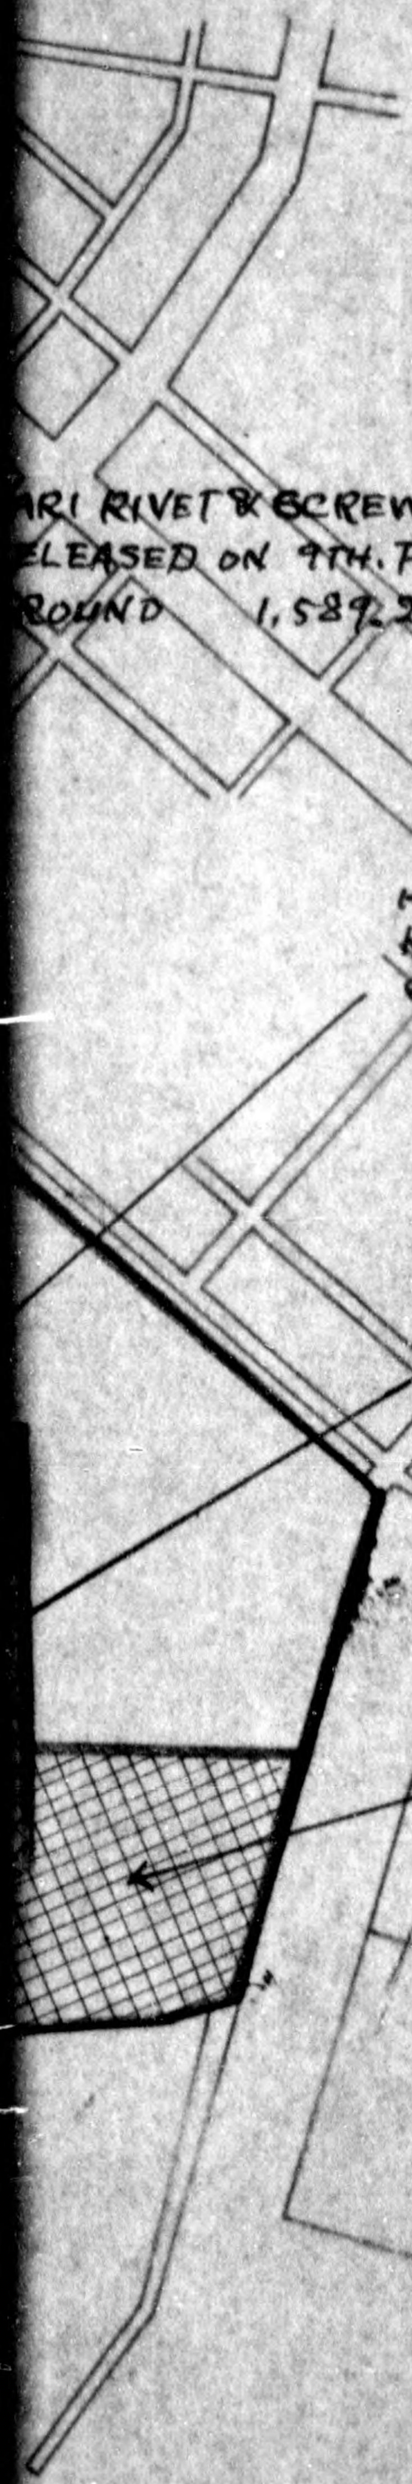

ARI RIVET & SCREW ASSOCIATION
ELEASED ON 9TH. FEB. 1948.
ROUND 1,589.25 TSUBO

HOSPITAL
RELEASED ON 7TH. OCT. 1949.
GROUND 12,567 TSUBO

TAKEDA HOUSE
RELEASED ON 9TH. FEB. 1948
BUYER TAKEDA PHARMACEUTICAL INDUSTRIES Co. LTD.
GROUND 5,449.71 TSUBO

NICHIMAN SHOKUHIN KAGAKU K.K.
RELEASED ON 9TH. FEB. 1948
BUYER NICHIMAN SHOKUHIN KAGAKU K.K.
GROUND 7,190.19 TSUBO

DECLASSIFIED E.O. 12065 SECTION 3 NSC 7 MAR 80 By [illegible] NARS

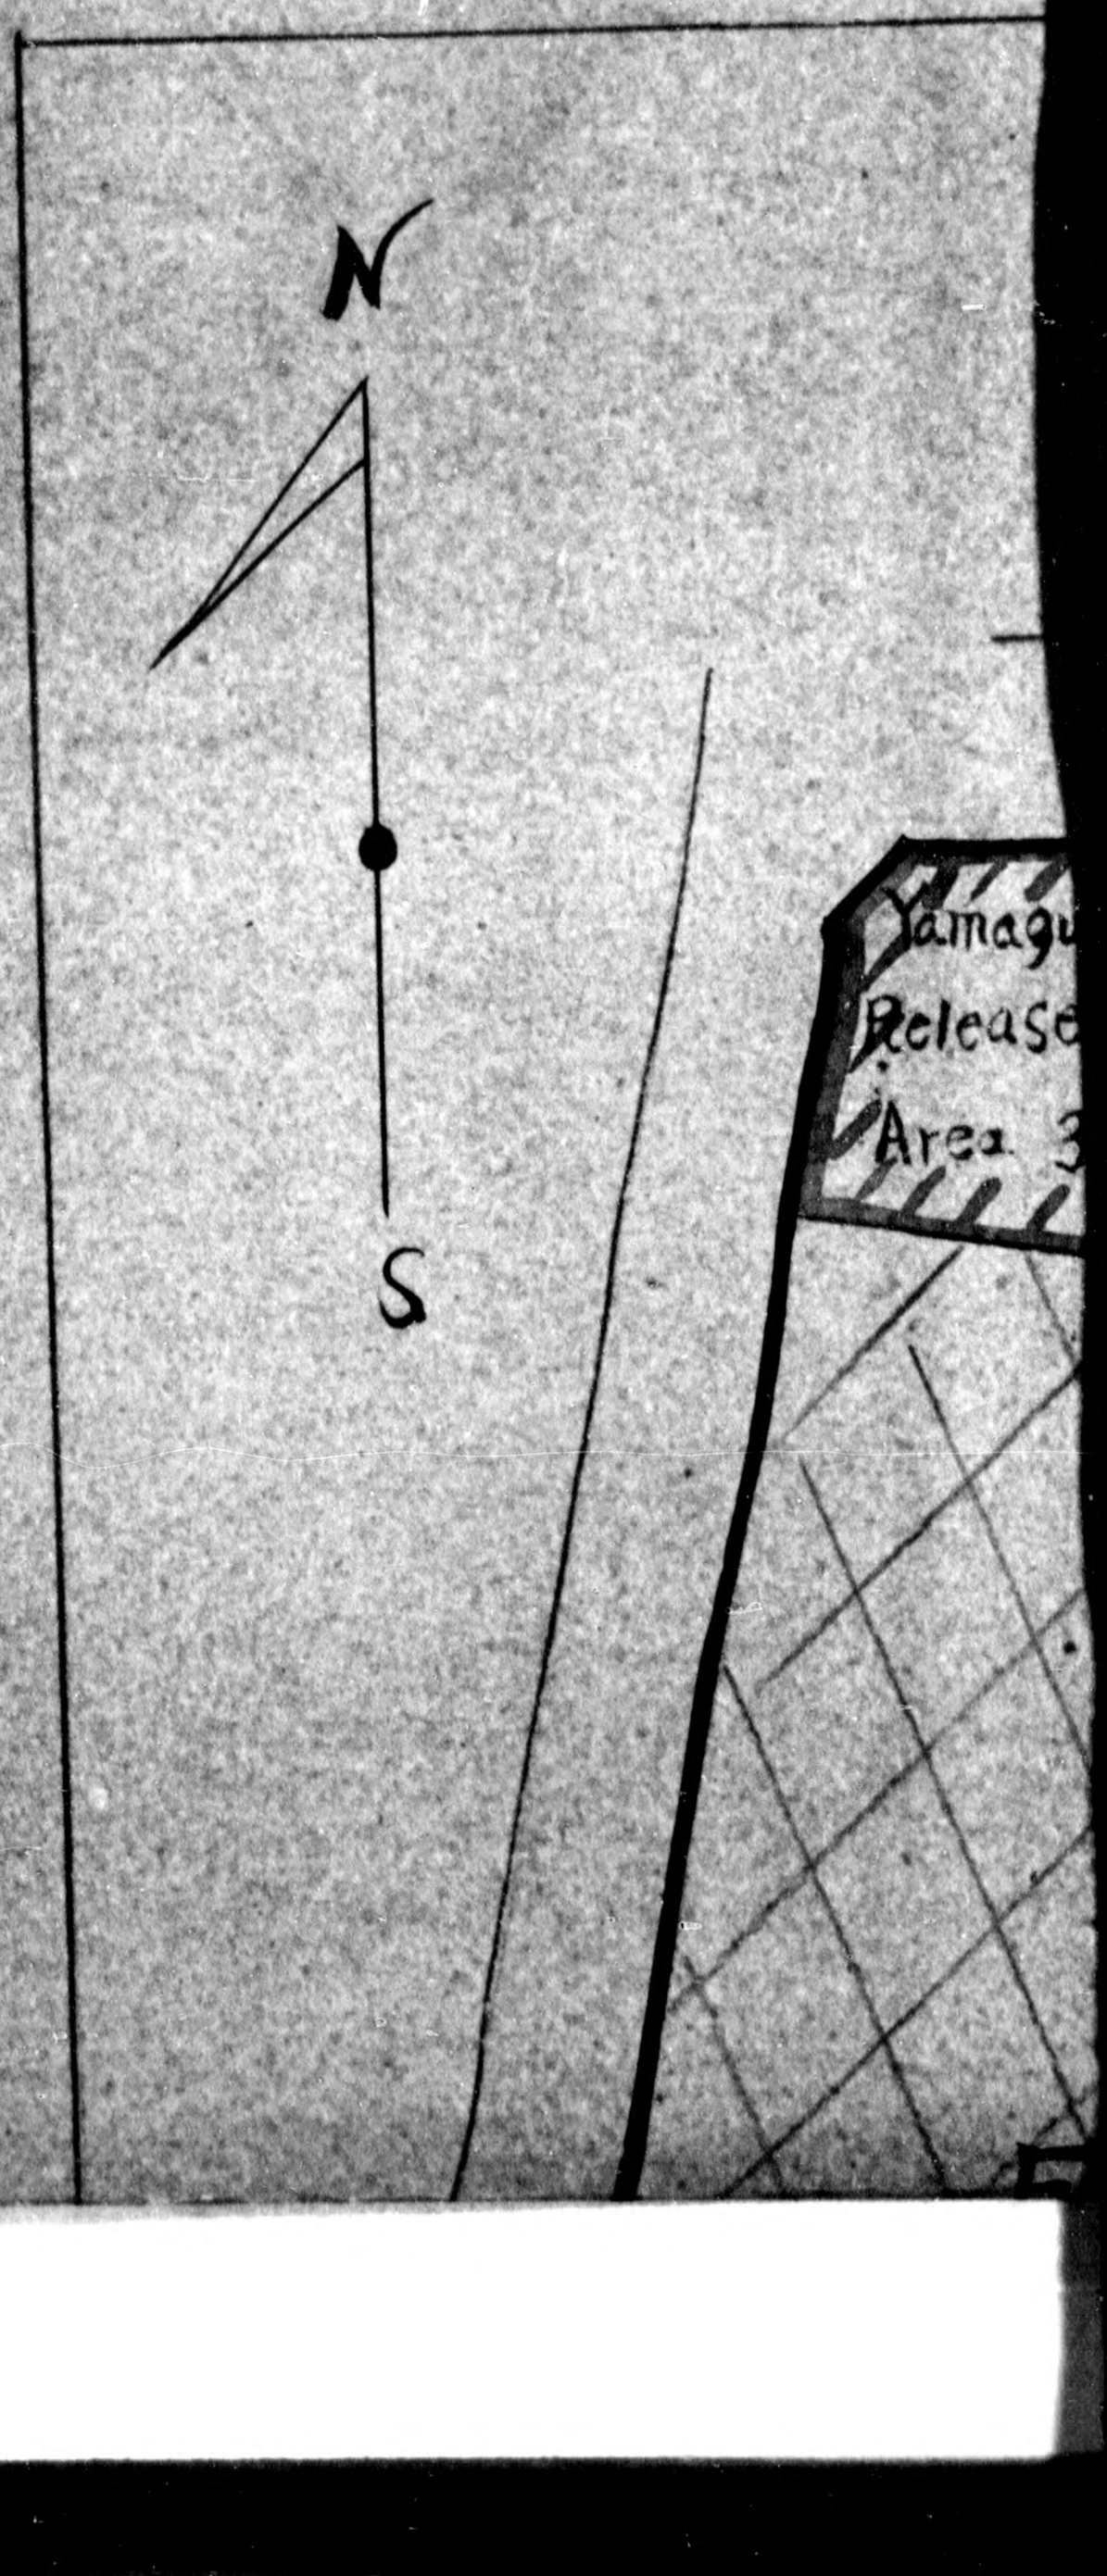

DECLASSIFIED E.O. 12065 SECTION 3 NSC 7 MAR 80

Ube Branch of Ex-

Yamaguchi Pref Truck Co
Release: 23 Jan 1948
Area 302 Tubo

 

DECLASSIFIED E.O. 12065 SECTION 3 402 (MARS NO. 1 1 0 3 0 1 0

# of Ex-Naval Kure Arsenal

Code No. 45-3

Ube Kosan CO.

Release: 23 Jan. 1948

Area: 901 Tub

Area: 2491 Tubo

Instance

Areas sold to private comp

Areas require for reparati

Areas in use by Japanese

Buildings require for rep

Buildings released but loc

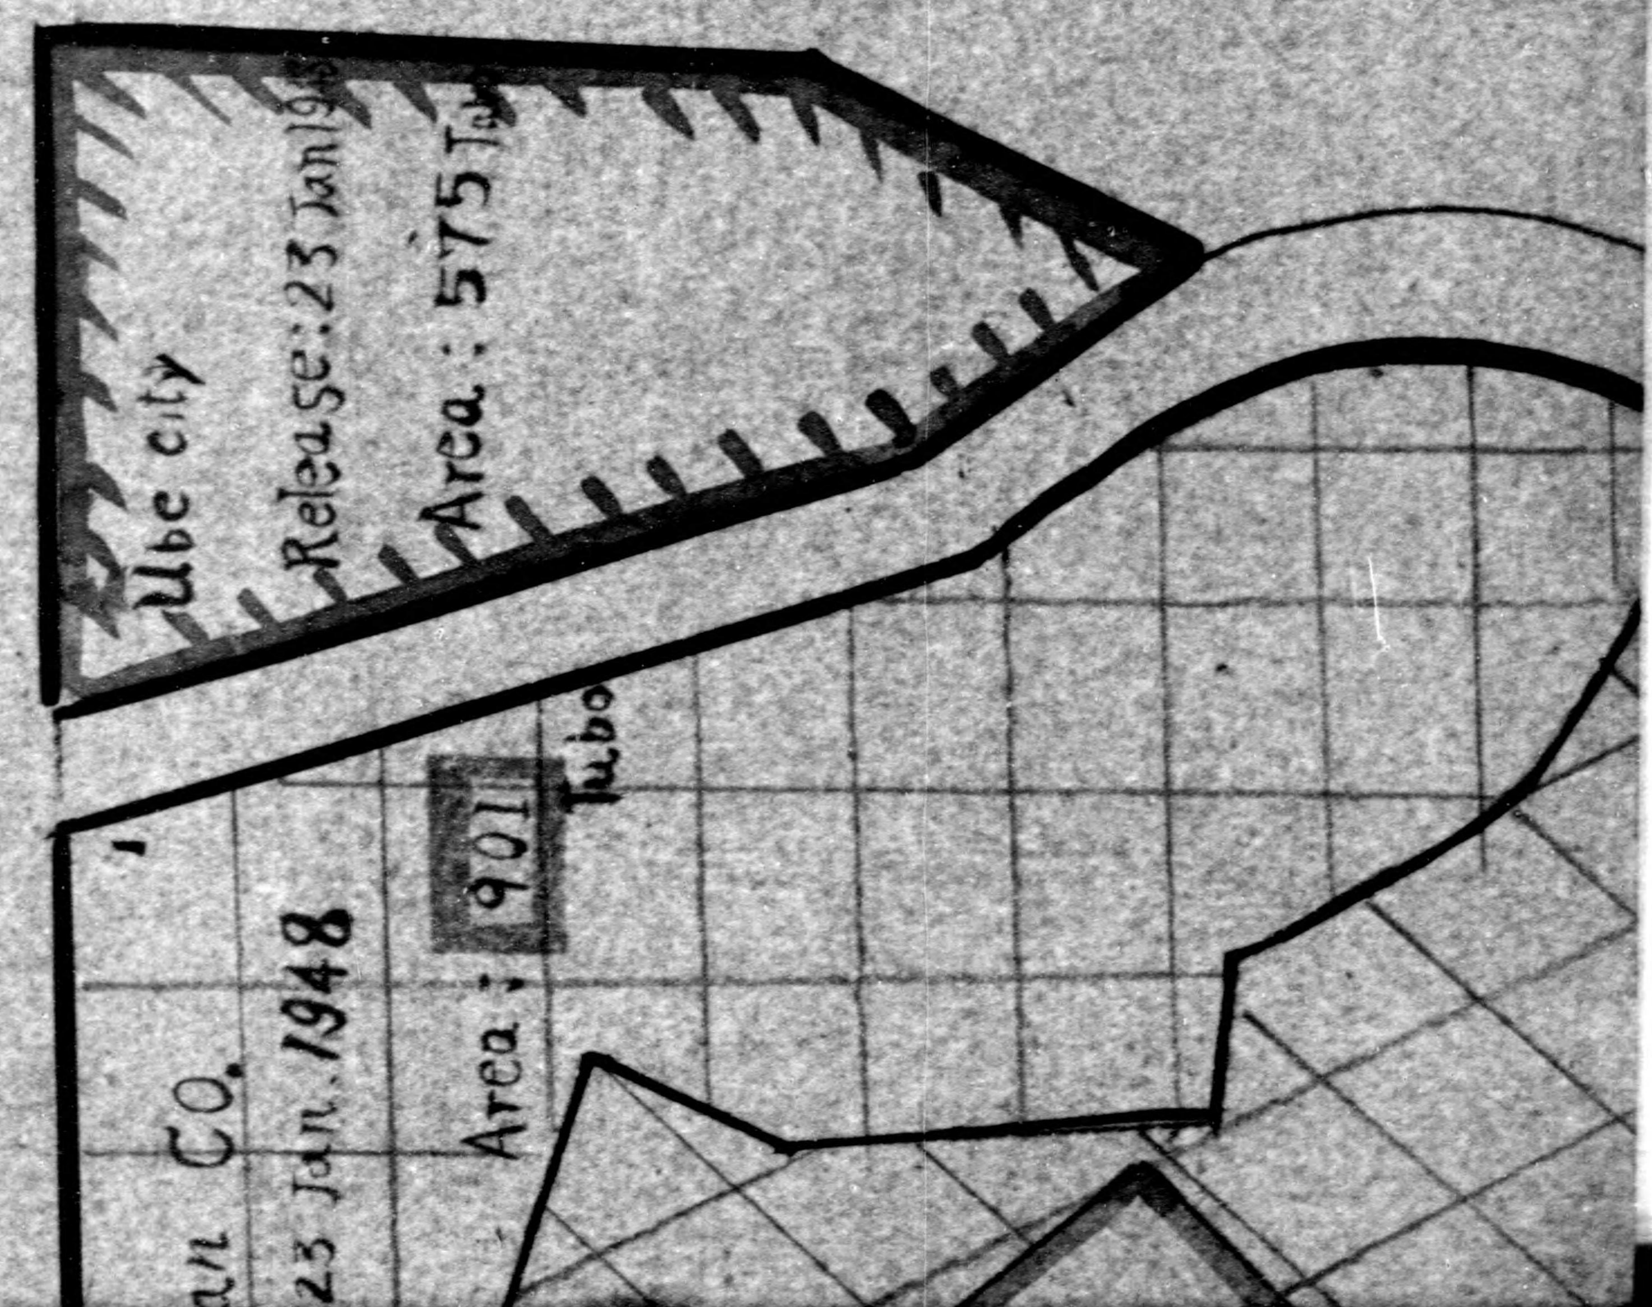

45-3

an Co.
23 Jan. 1948

DECLASSIFIED E.O. 12065 SECTION 3

Areas sold to private comp

Areas require for reparati

Areas in use by Japanese

Buildings require for rep

Buildings released but loc

Instance

Ube city

Release: 23 Jan 9

Area: 575 Tsu

DECLASSIFIED E.O. 12065 SECTION 3 NSC 7 BY NARS DATE 12-1-78

DECLASSIFIED E.O. 12065 SECTION 3 NND

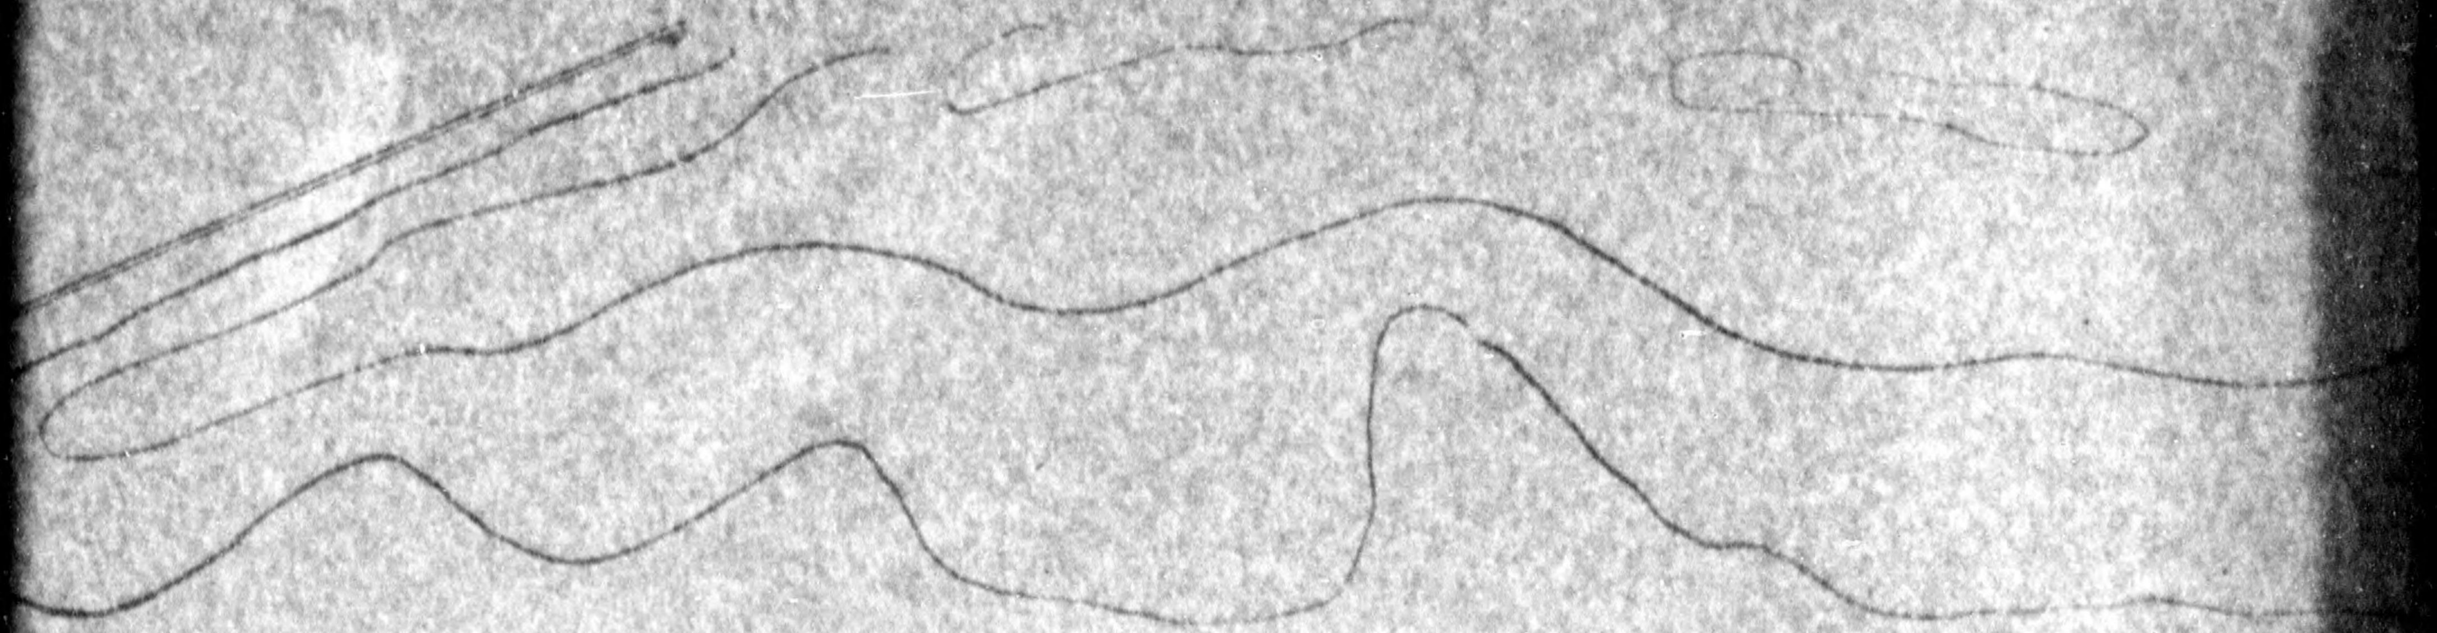

Areas released 24,587 Tsubo

Dated 8 July 1946

AG 601 (MG) 2nd

"Building Reparation Plant for Emergency Housing."

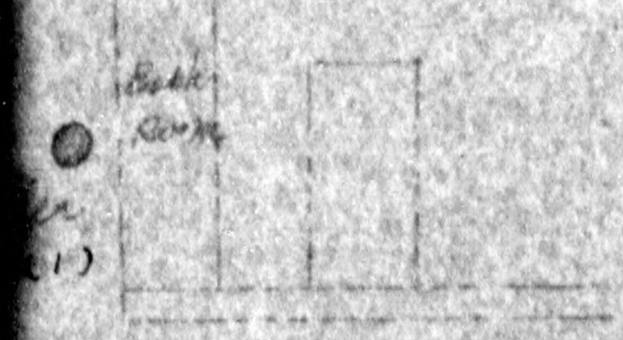

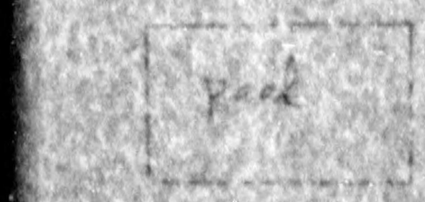

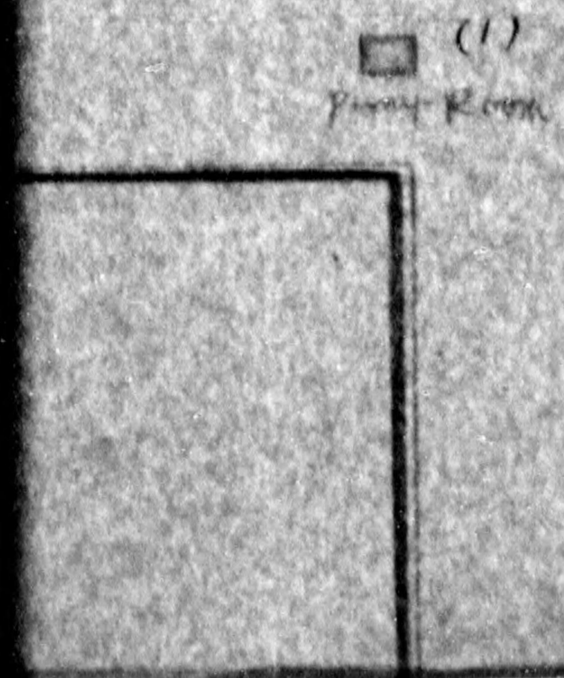

IWAMI PL

GOTSU-MA

SCALE

(BURROW

Tsubo

gency Housing."

DECLASSIFIED E.O. 12065 SECTION 3 NSC

IWAMI PLANT of THE OSAKA ARMY ARSENAL

Code No. 36-1 (1)

GOTSU-MACHI NAKA-GUN SHIMANE PREFECTURE

PLANT LAYOUT

SCALE 1 : 1,000

GRAND AREA 35439 Tsubo

(BORROWED FROM THE SHIMANE CHEMICAL INDUSTRY)

DRAWN BY GOTSU BRANCH OF CHUGOKU STATE PROPERTY BUREAU

Areas to succeed by the ex-Army 8

Areas not released 35,439

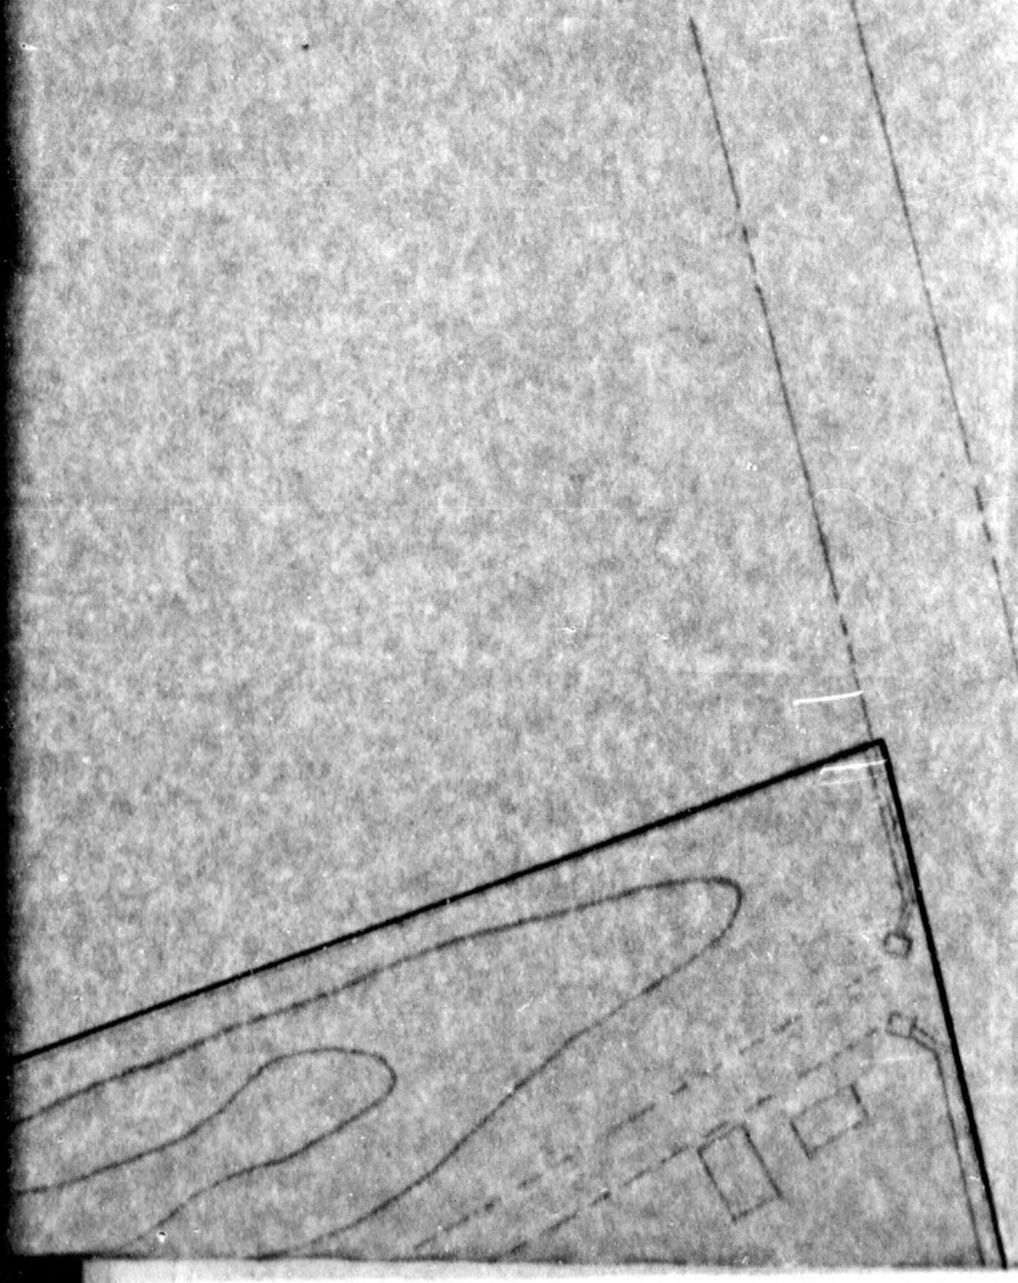

OF THE OSAKA ARMY ARSENAL

No. 36-1 (1)

NAKA-GUN SHIMANE PREFECTURE

LANT LAYOUT

1 : 1,000

EA 35439 Tsubo

ROM T SHIMANE CHEMICAL INDUSTRY

DRAWN BY GOTSU BRANCH
OF CHUGOKU STATE
PROPERTY BUREAU

Areas to succeed by the ex-Army 80,143 Tsubo

Areas not released 35,439 Tsubo

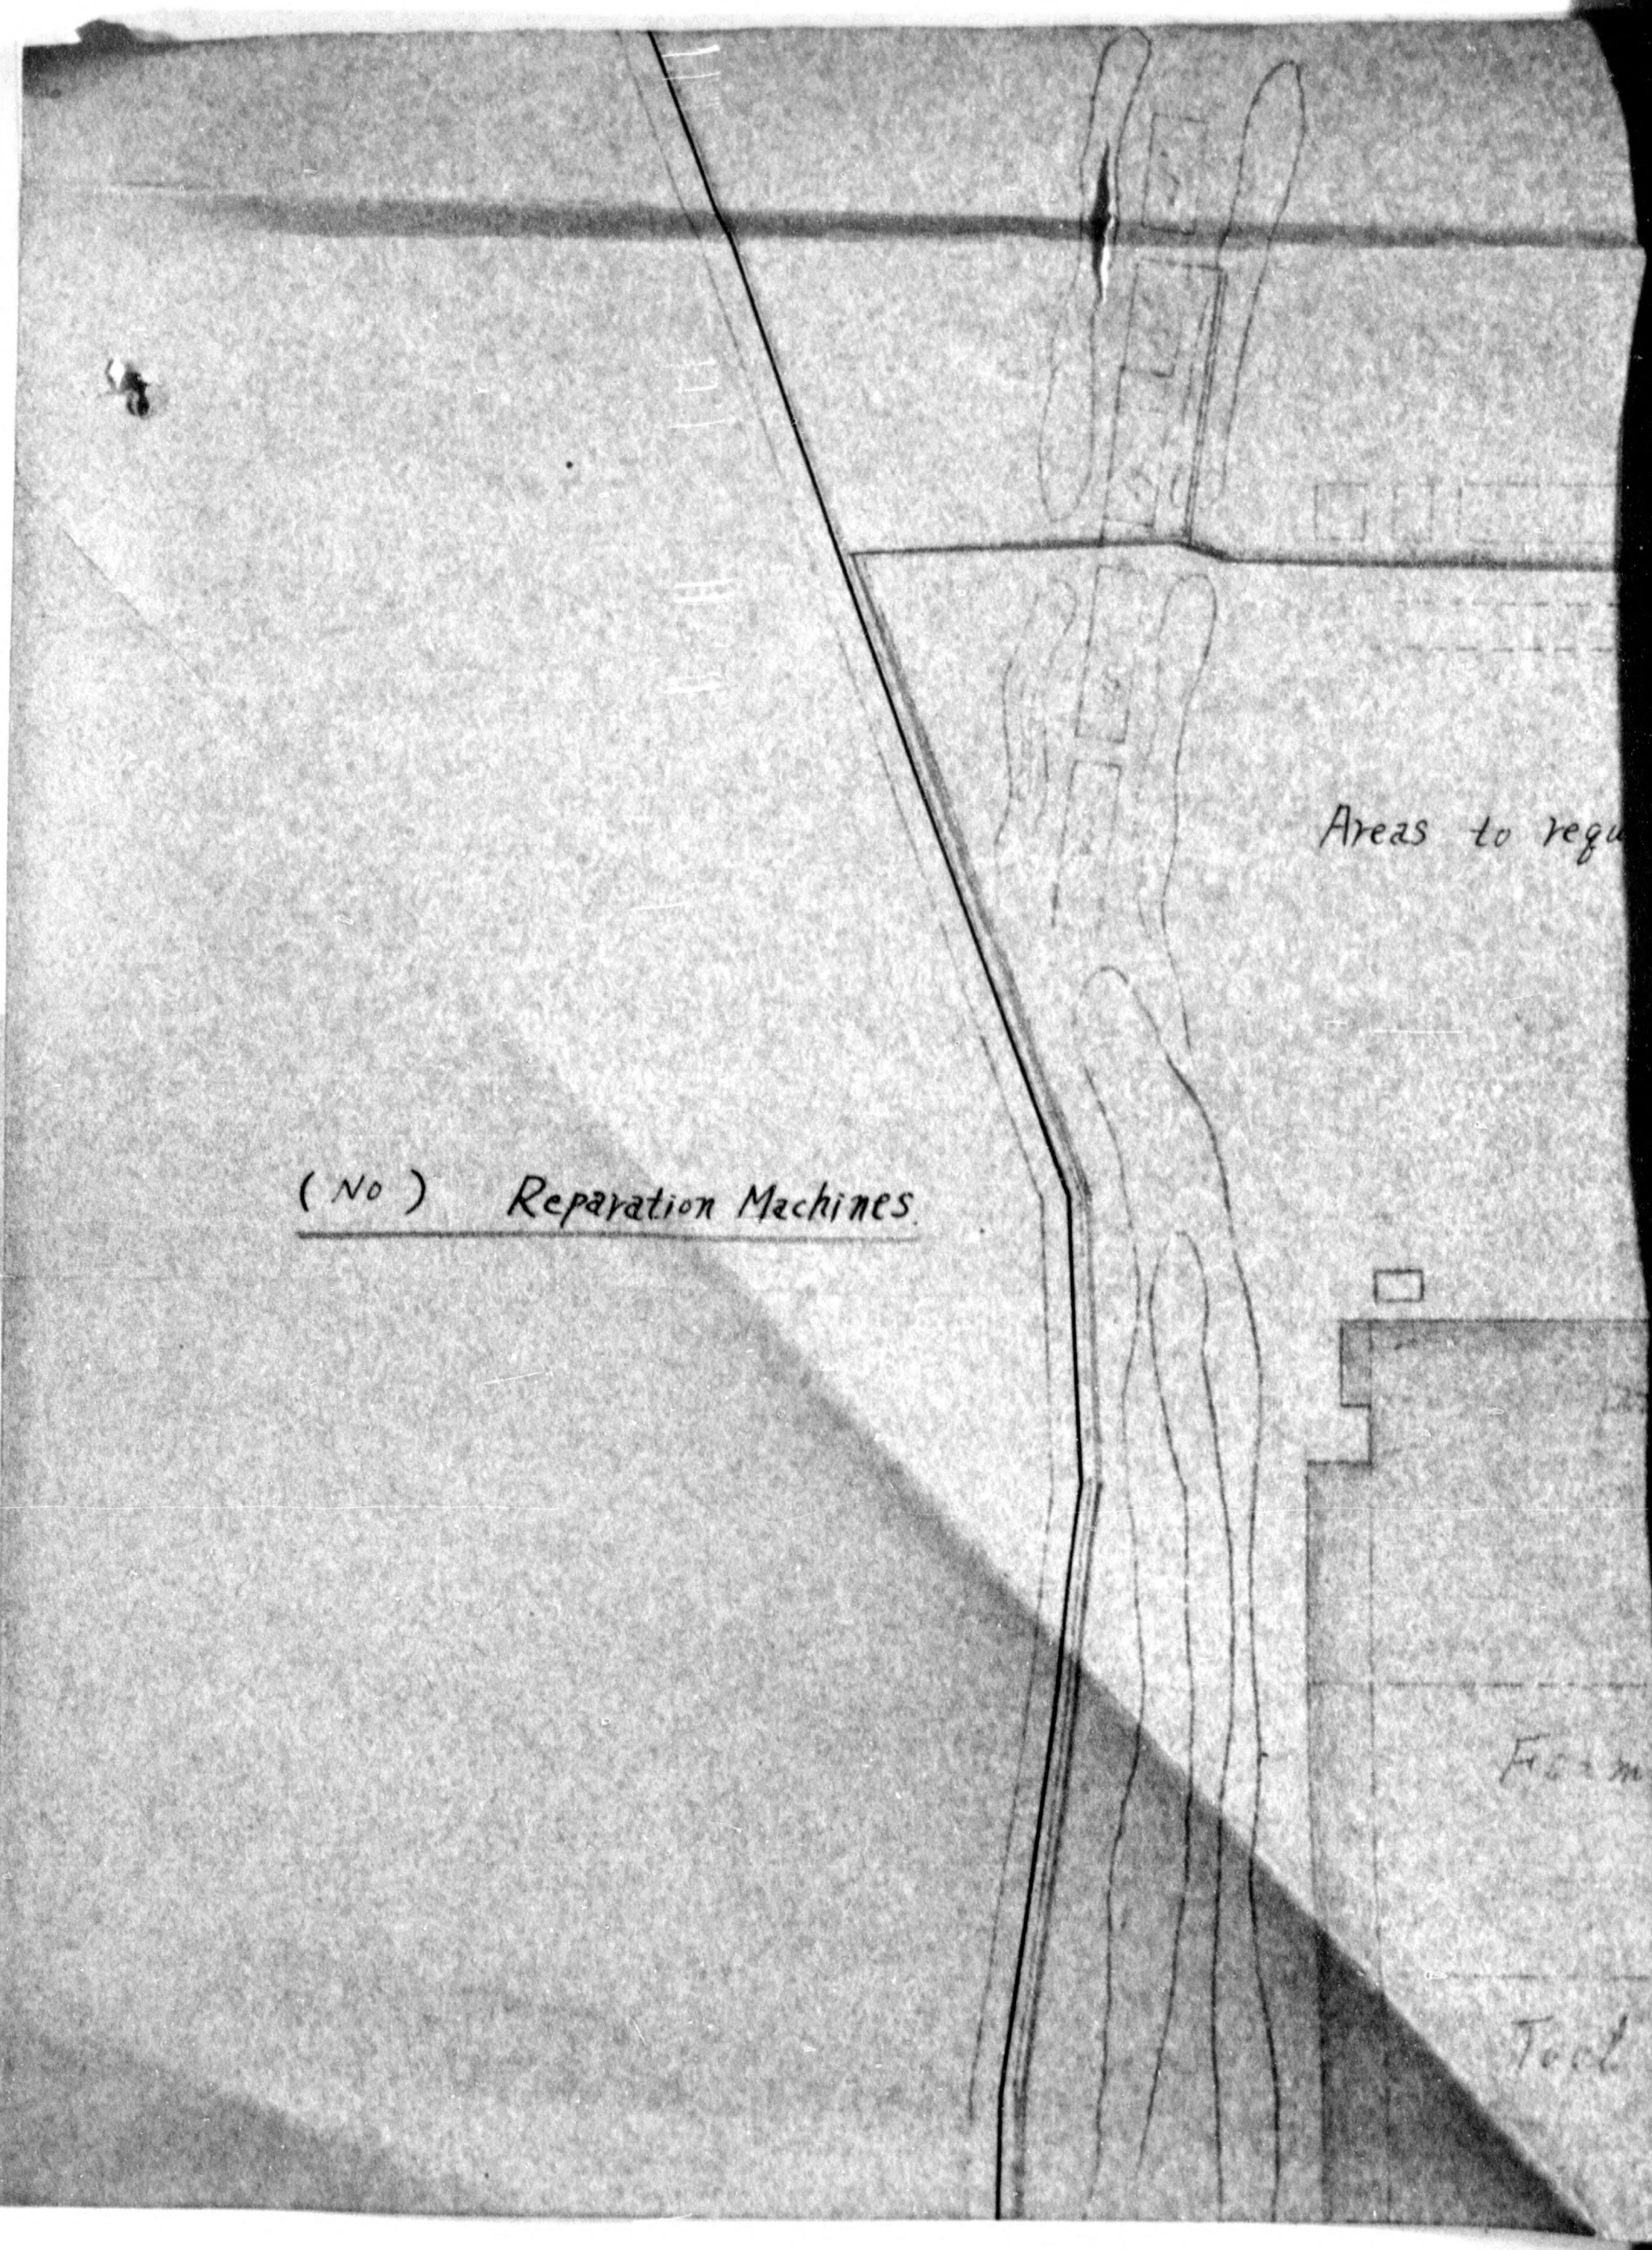
Areas to regu
(No) Reparation Machines
Fram
Tool

Middle School

Office 22 Tsubo

(4)

eas to required for Defence 35,439 Tsubo

Clerk Service Room 39 Tsubo (8)

30 Tsubo

Dressing Room (1) 285 Tsubo

Cookery 90 Tsubo

9059 Tsubo (844)

Press Work

Press Work

Lathe Work

9059 Tsubo

( )

Tool Work

Finishing Work

Store Room

Store Room

Store Room

Store Room

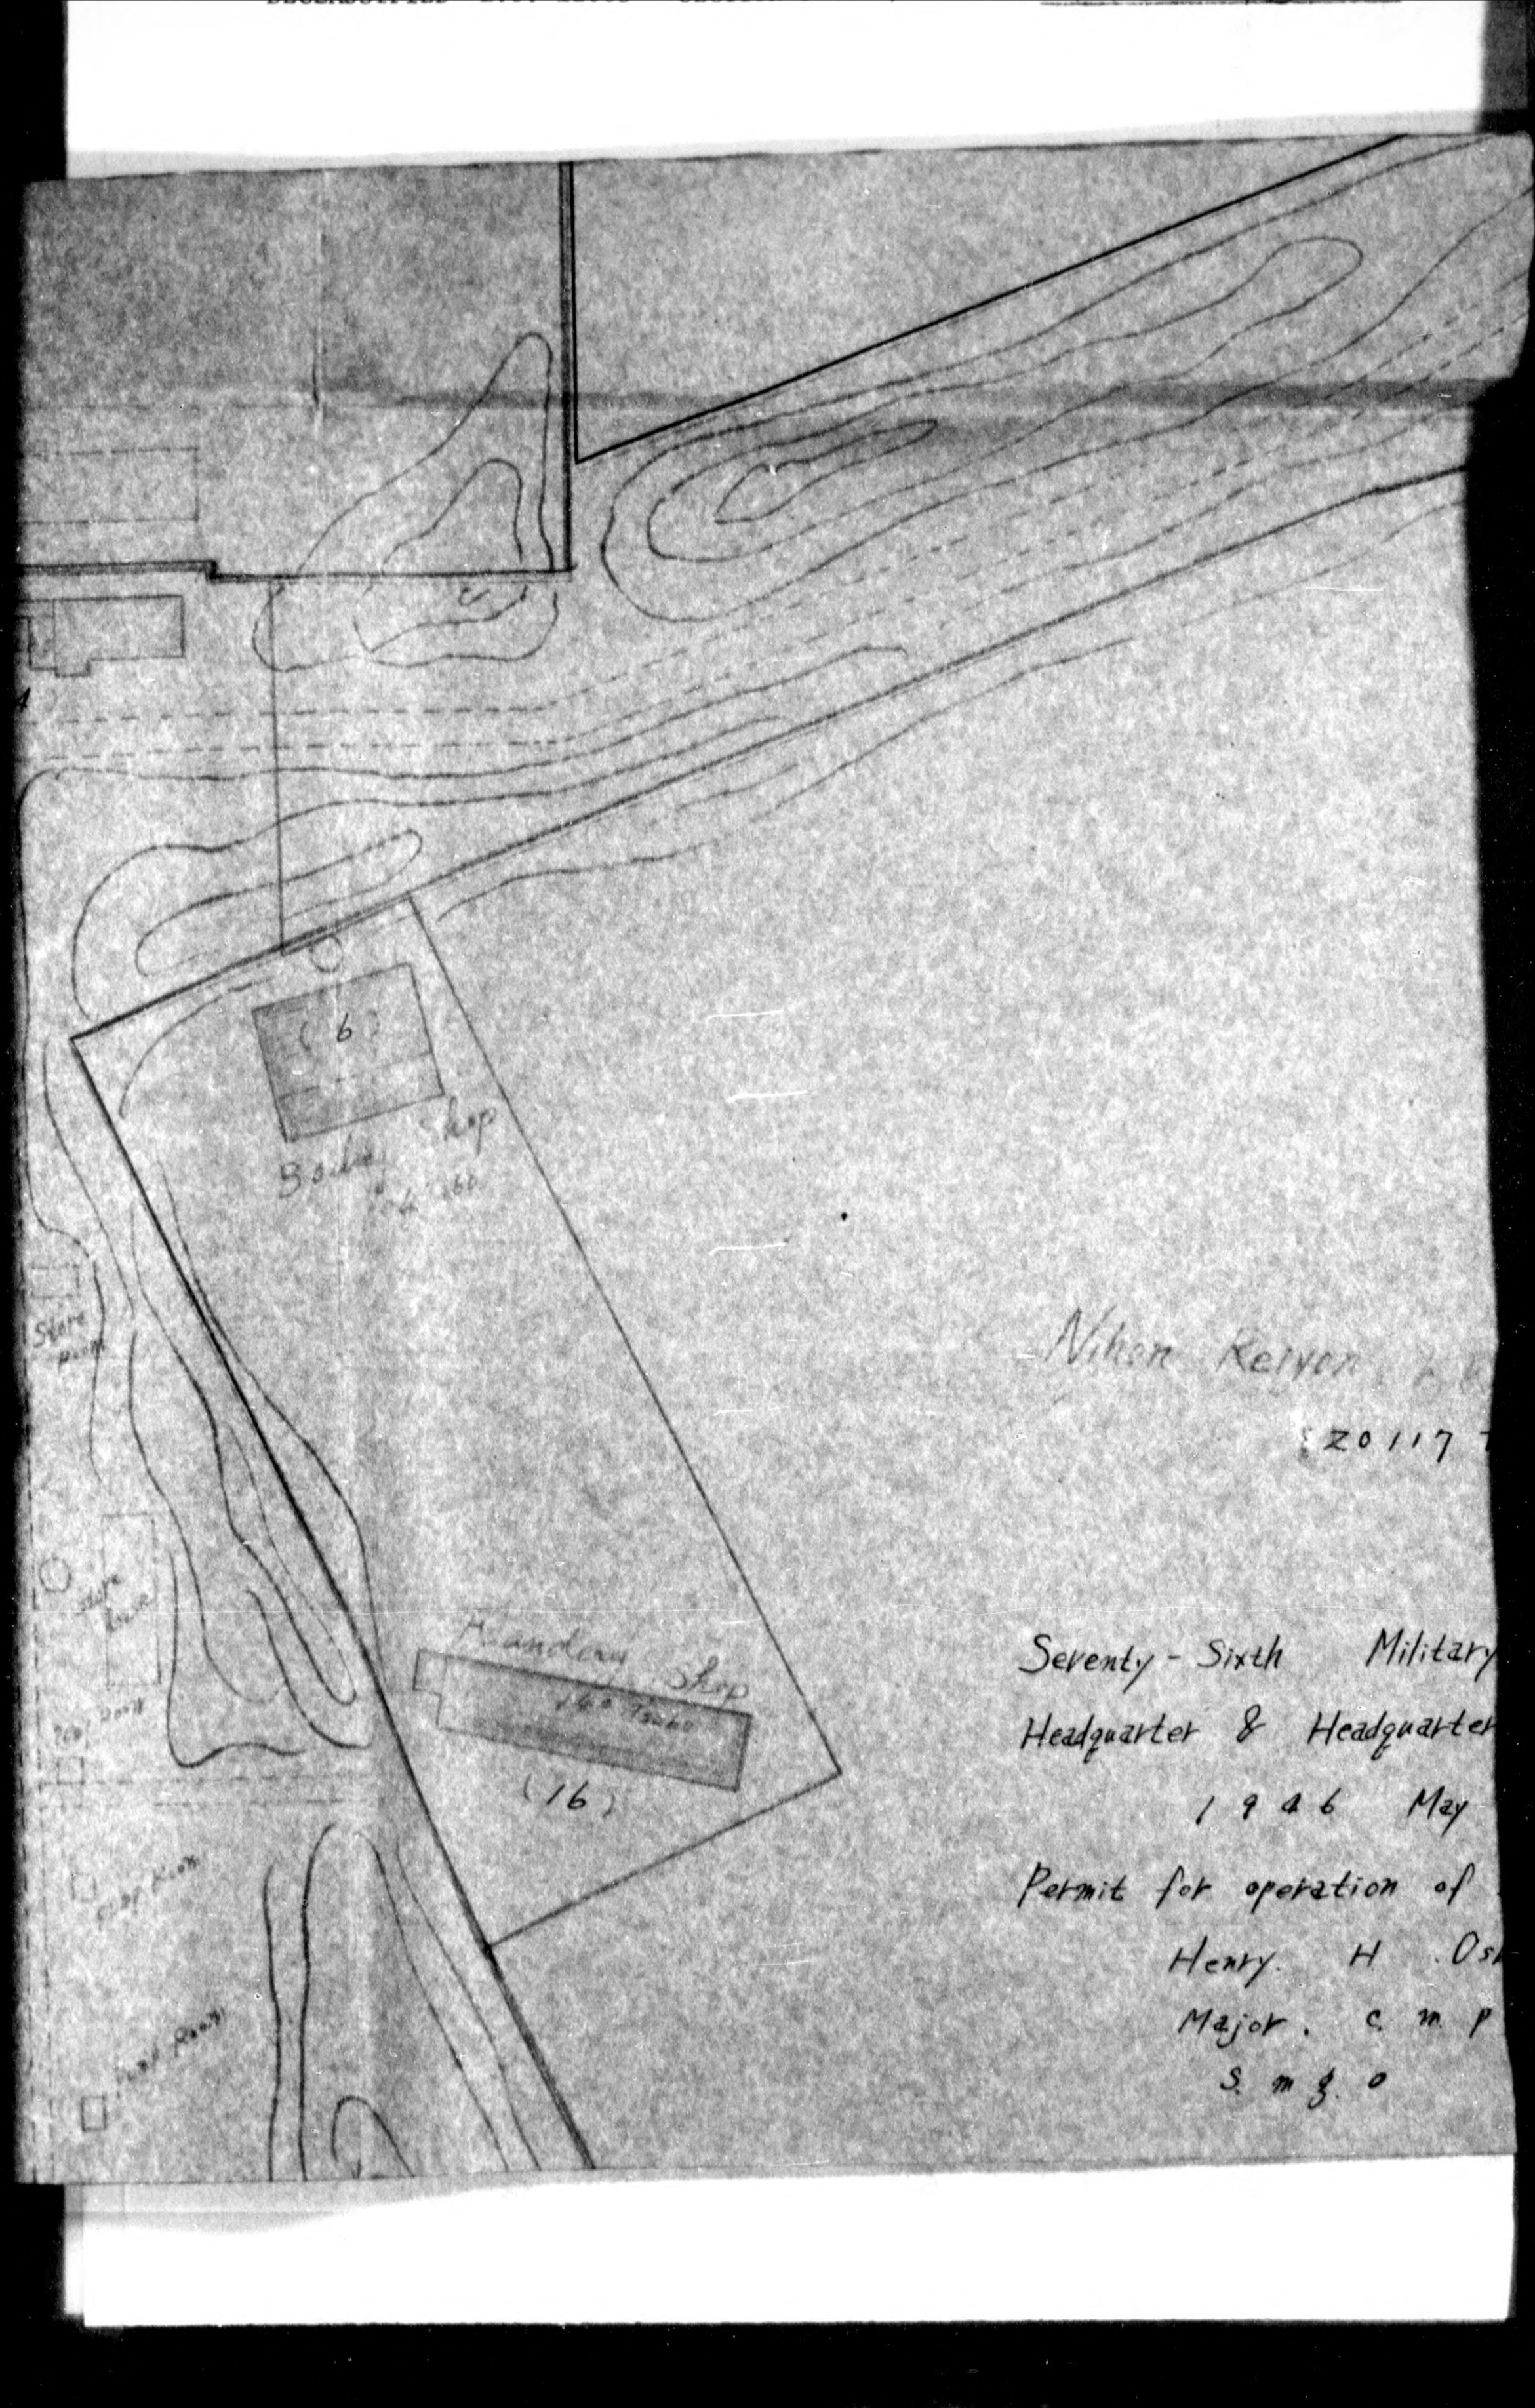
(6)
(16)
Seventy - Sixth Military
Headquarter & Headquarter
1946 May
Permit for operation of
Henry H. Os
Major, C m p
S m g. o

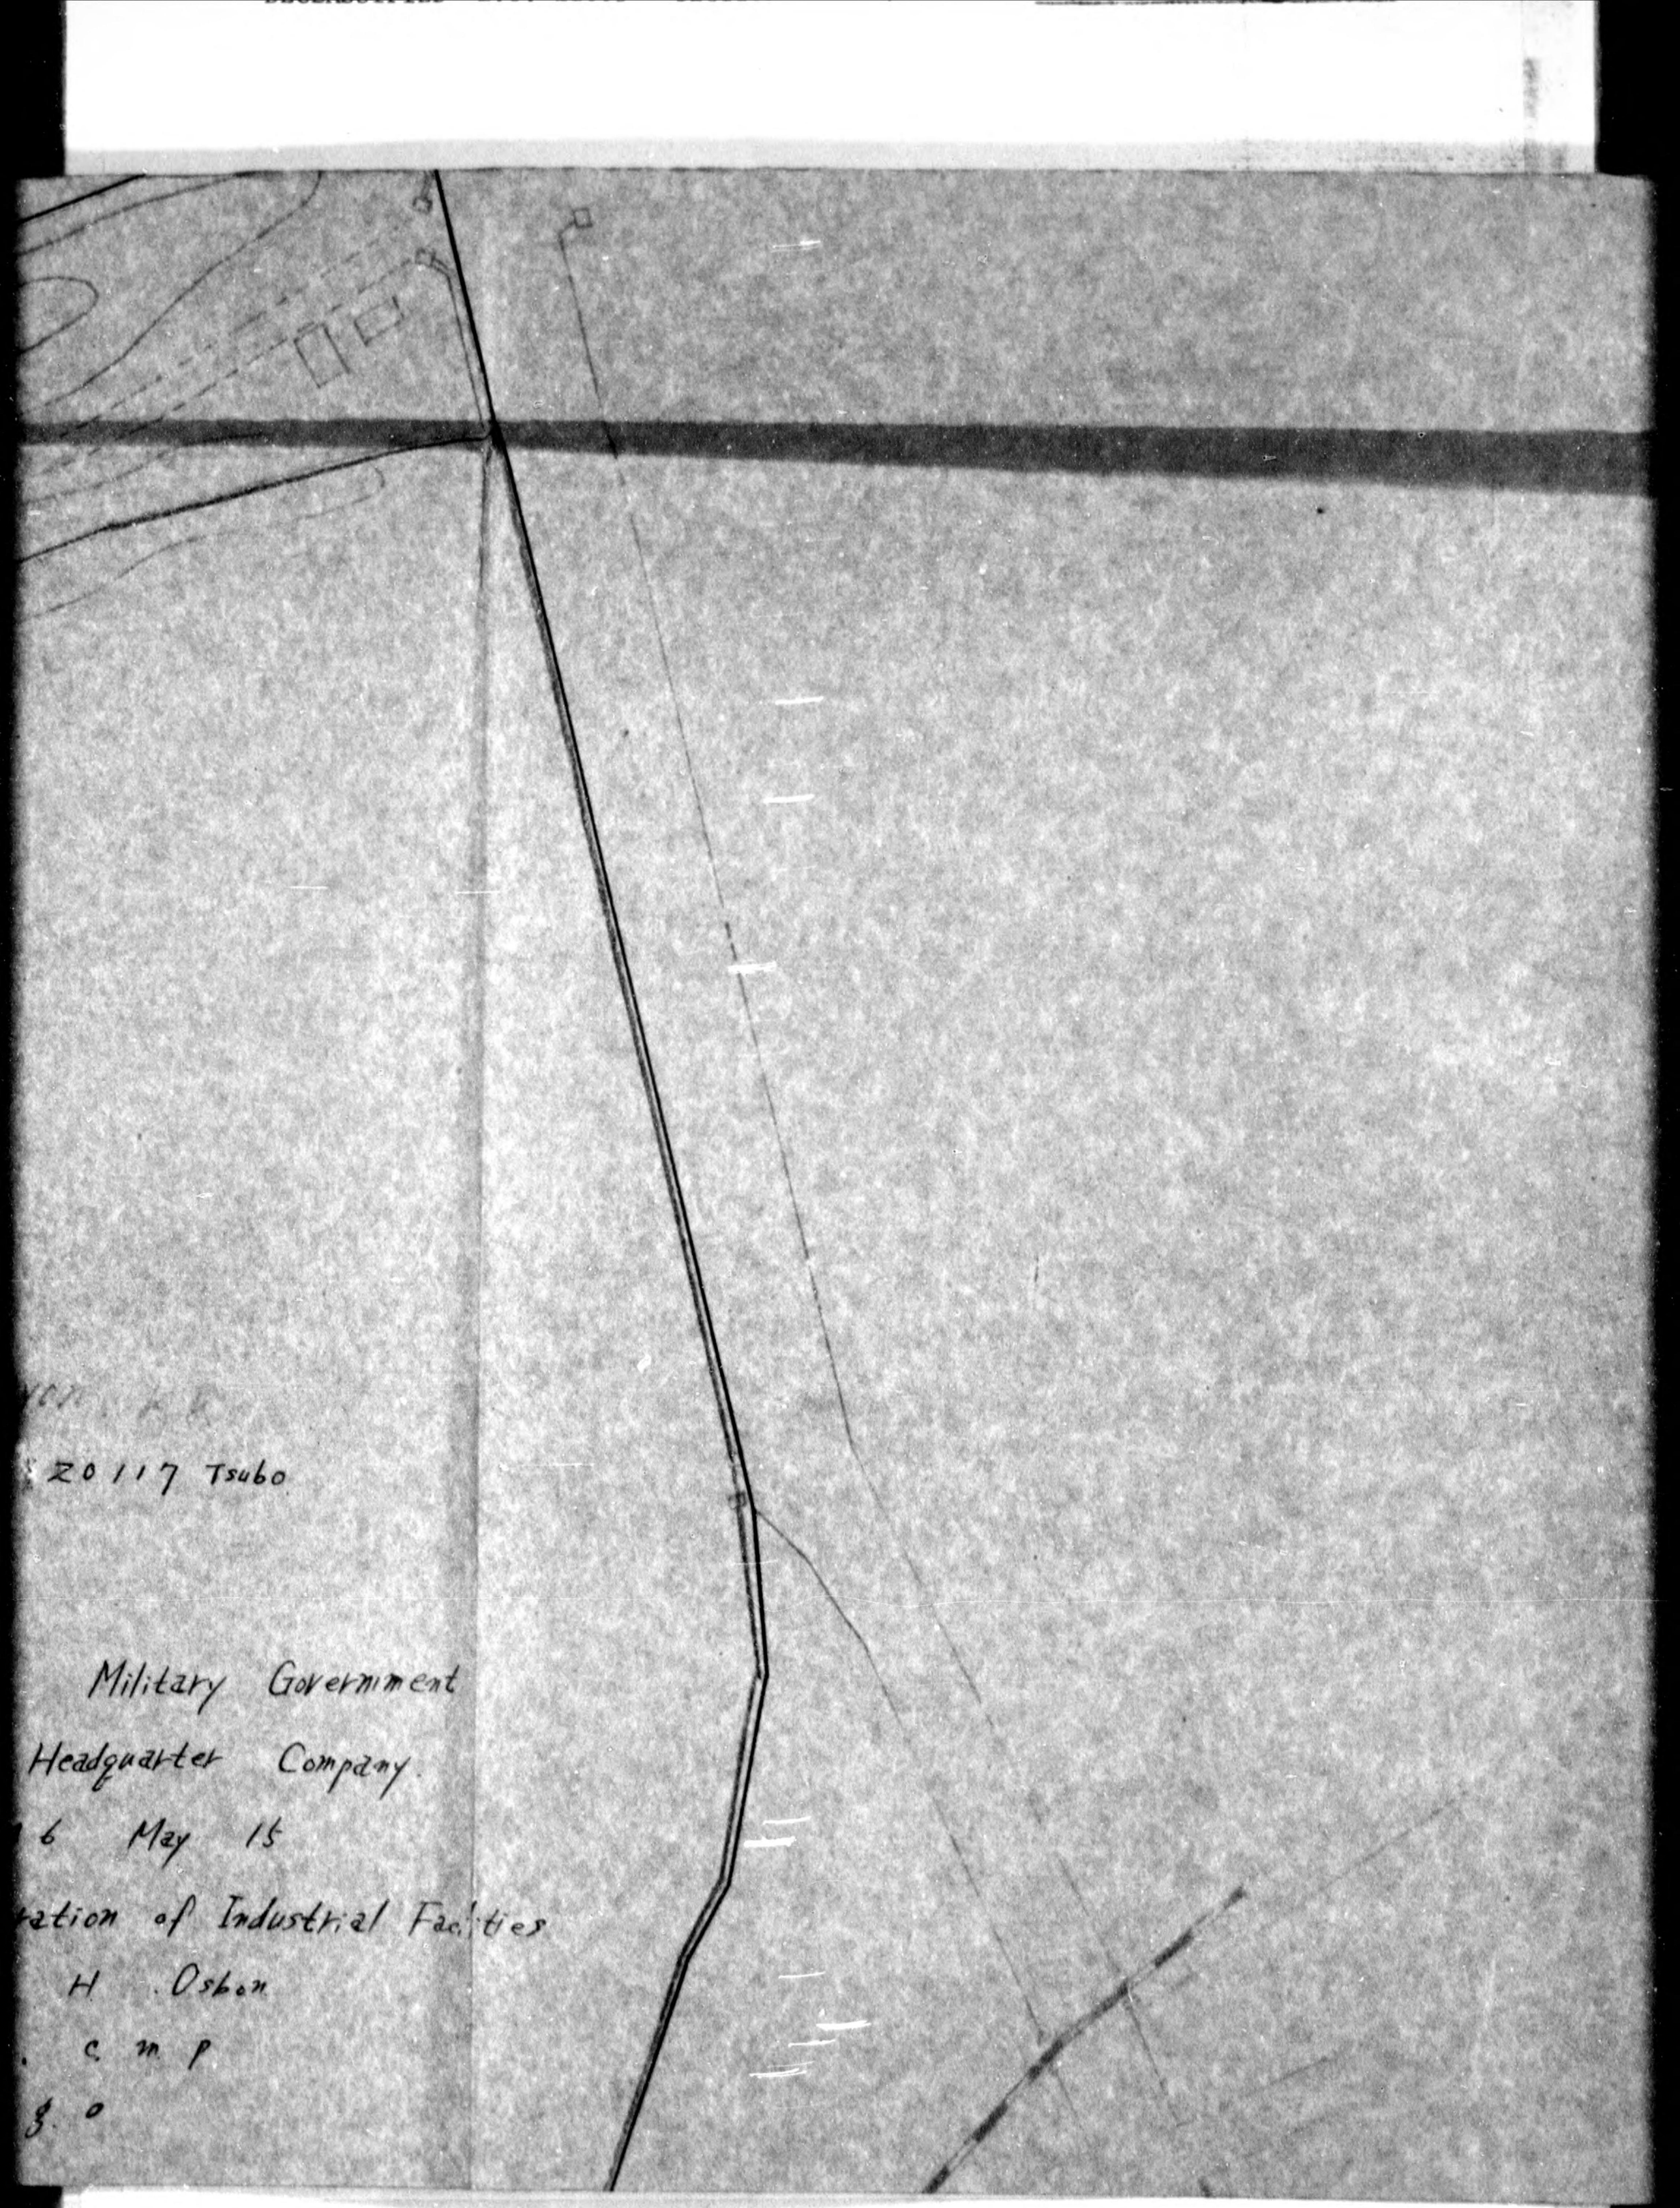
20117 Tsubo
Military Government
Headquarter Company.
6 May 15
ration of Industrial Facilities
H. Osbon
c m p
g. o

DECLASSIFIED E.O. 12065 GENERAL [illegible]

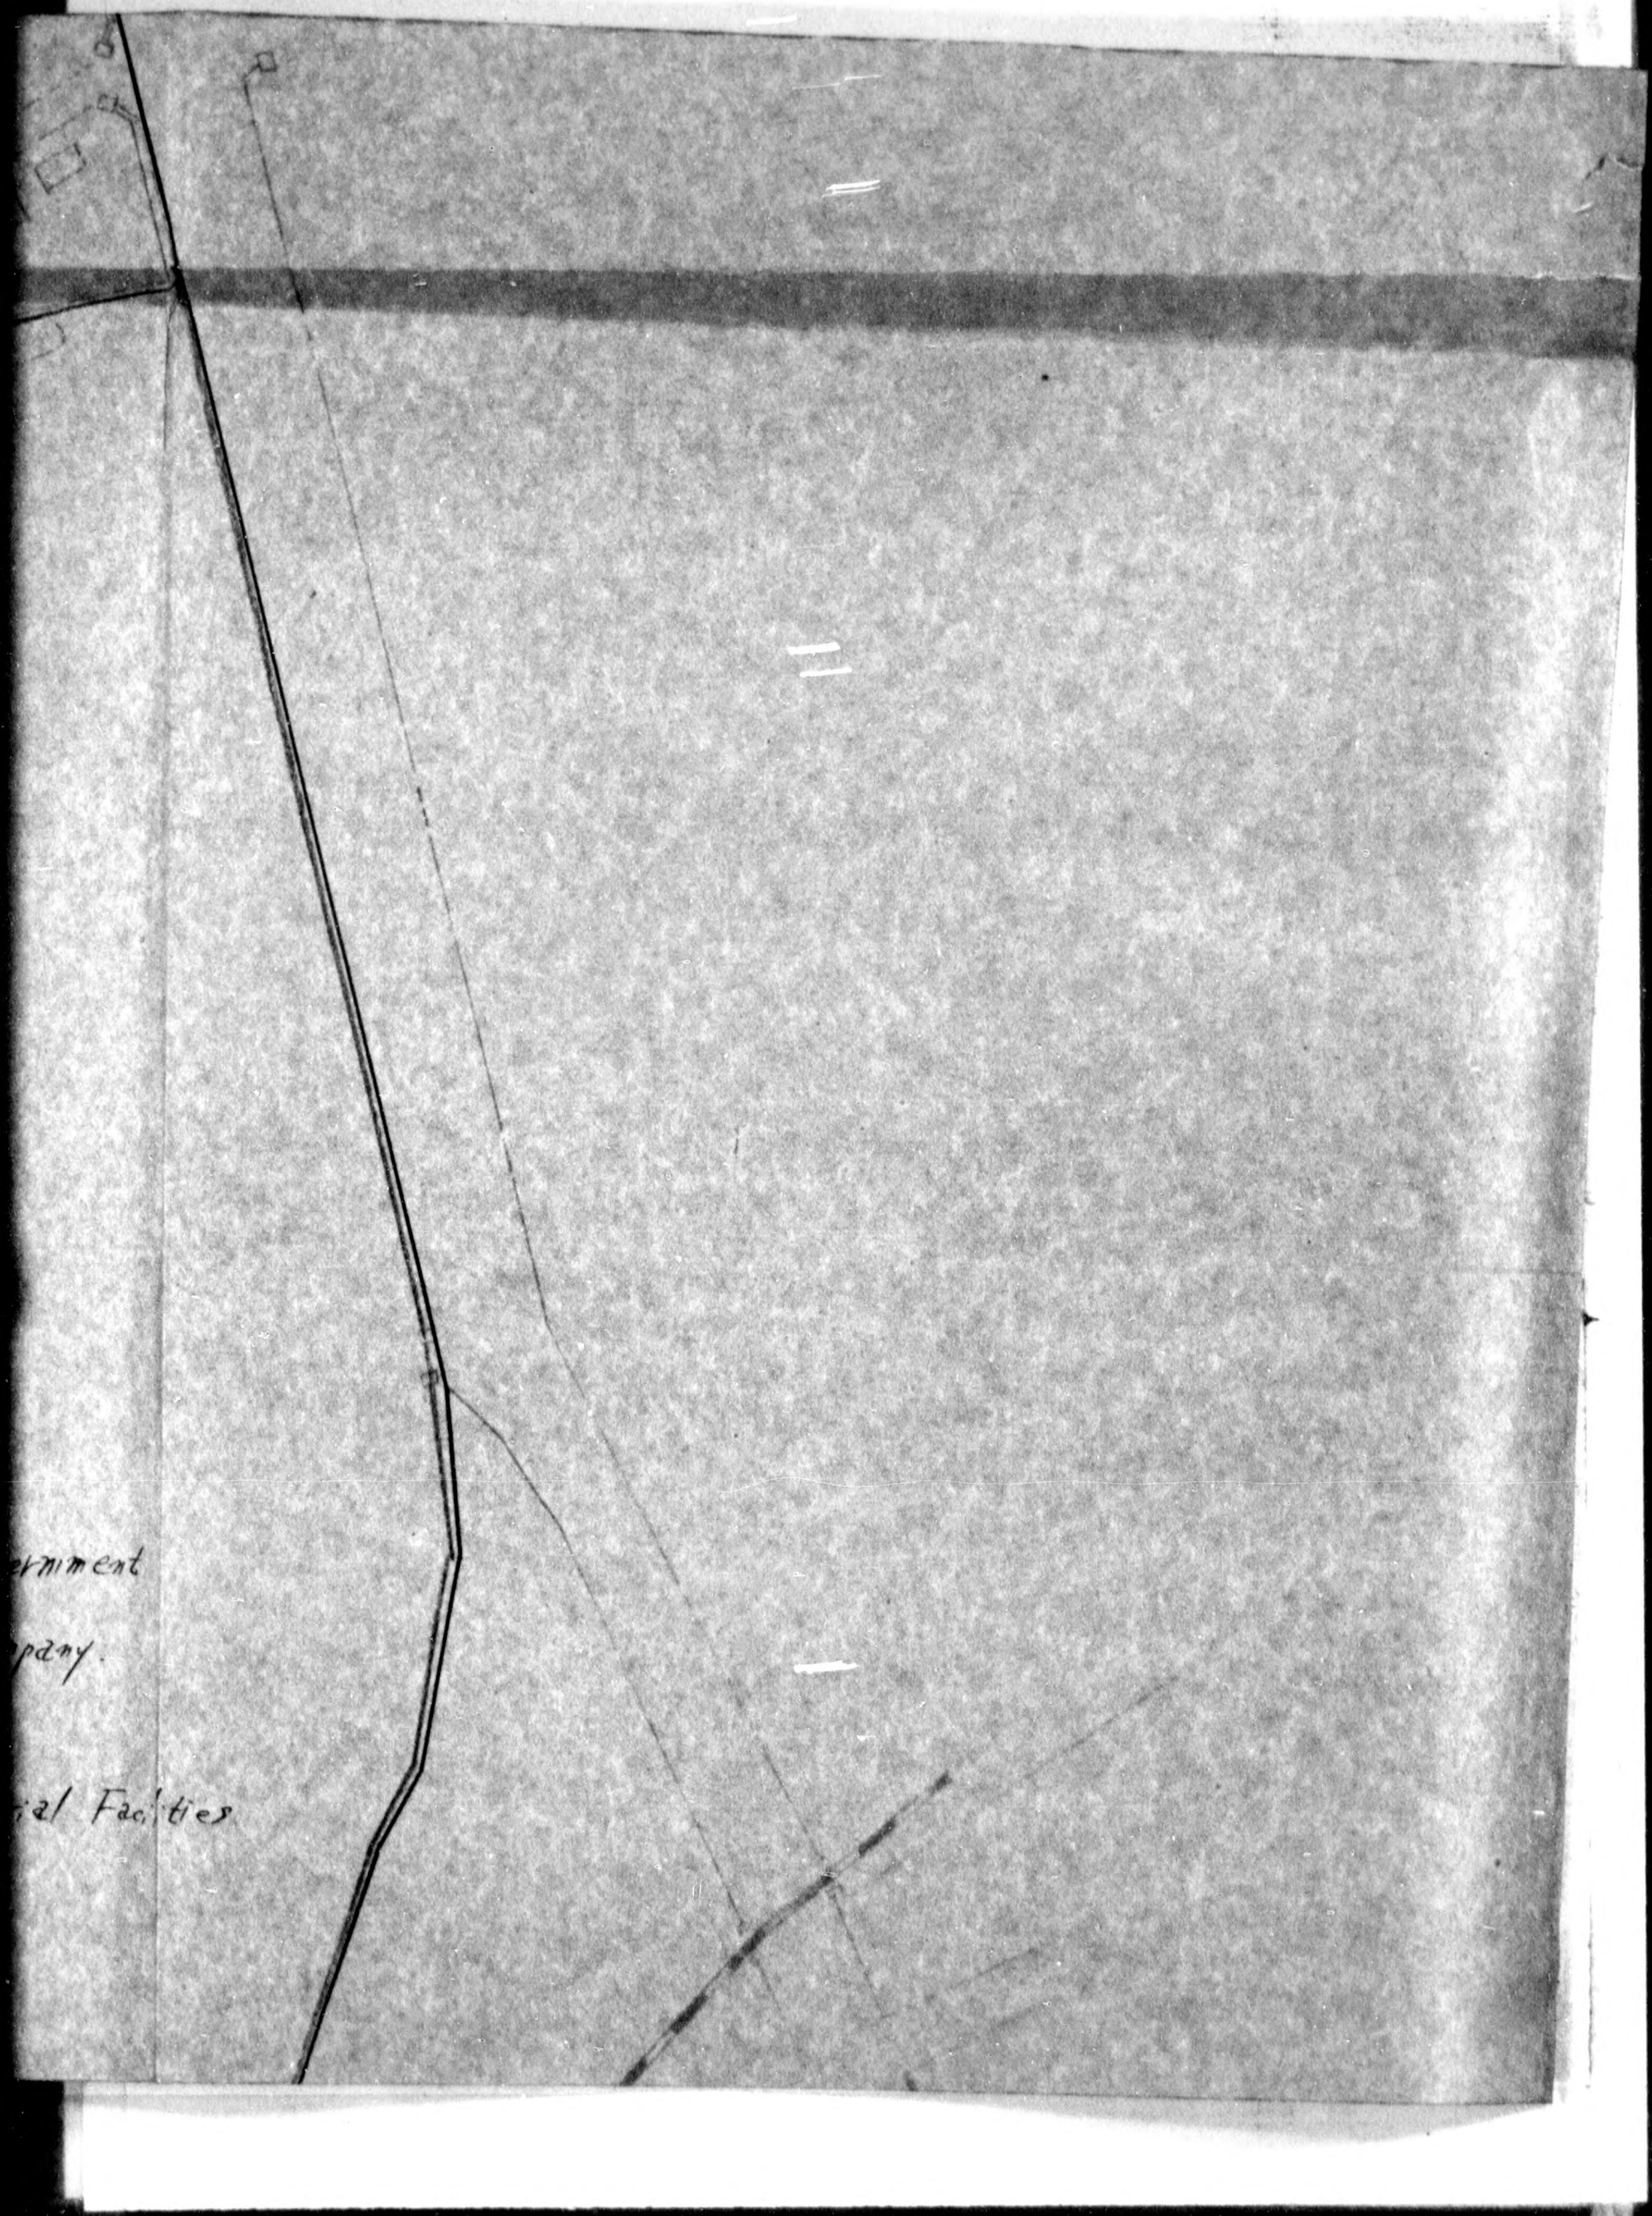

ernment

pany.

ial Facilities

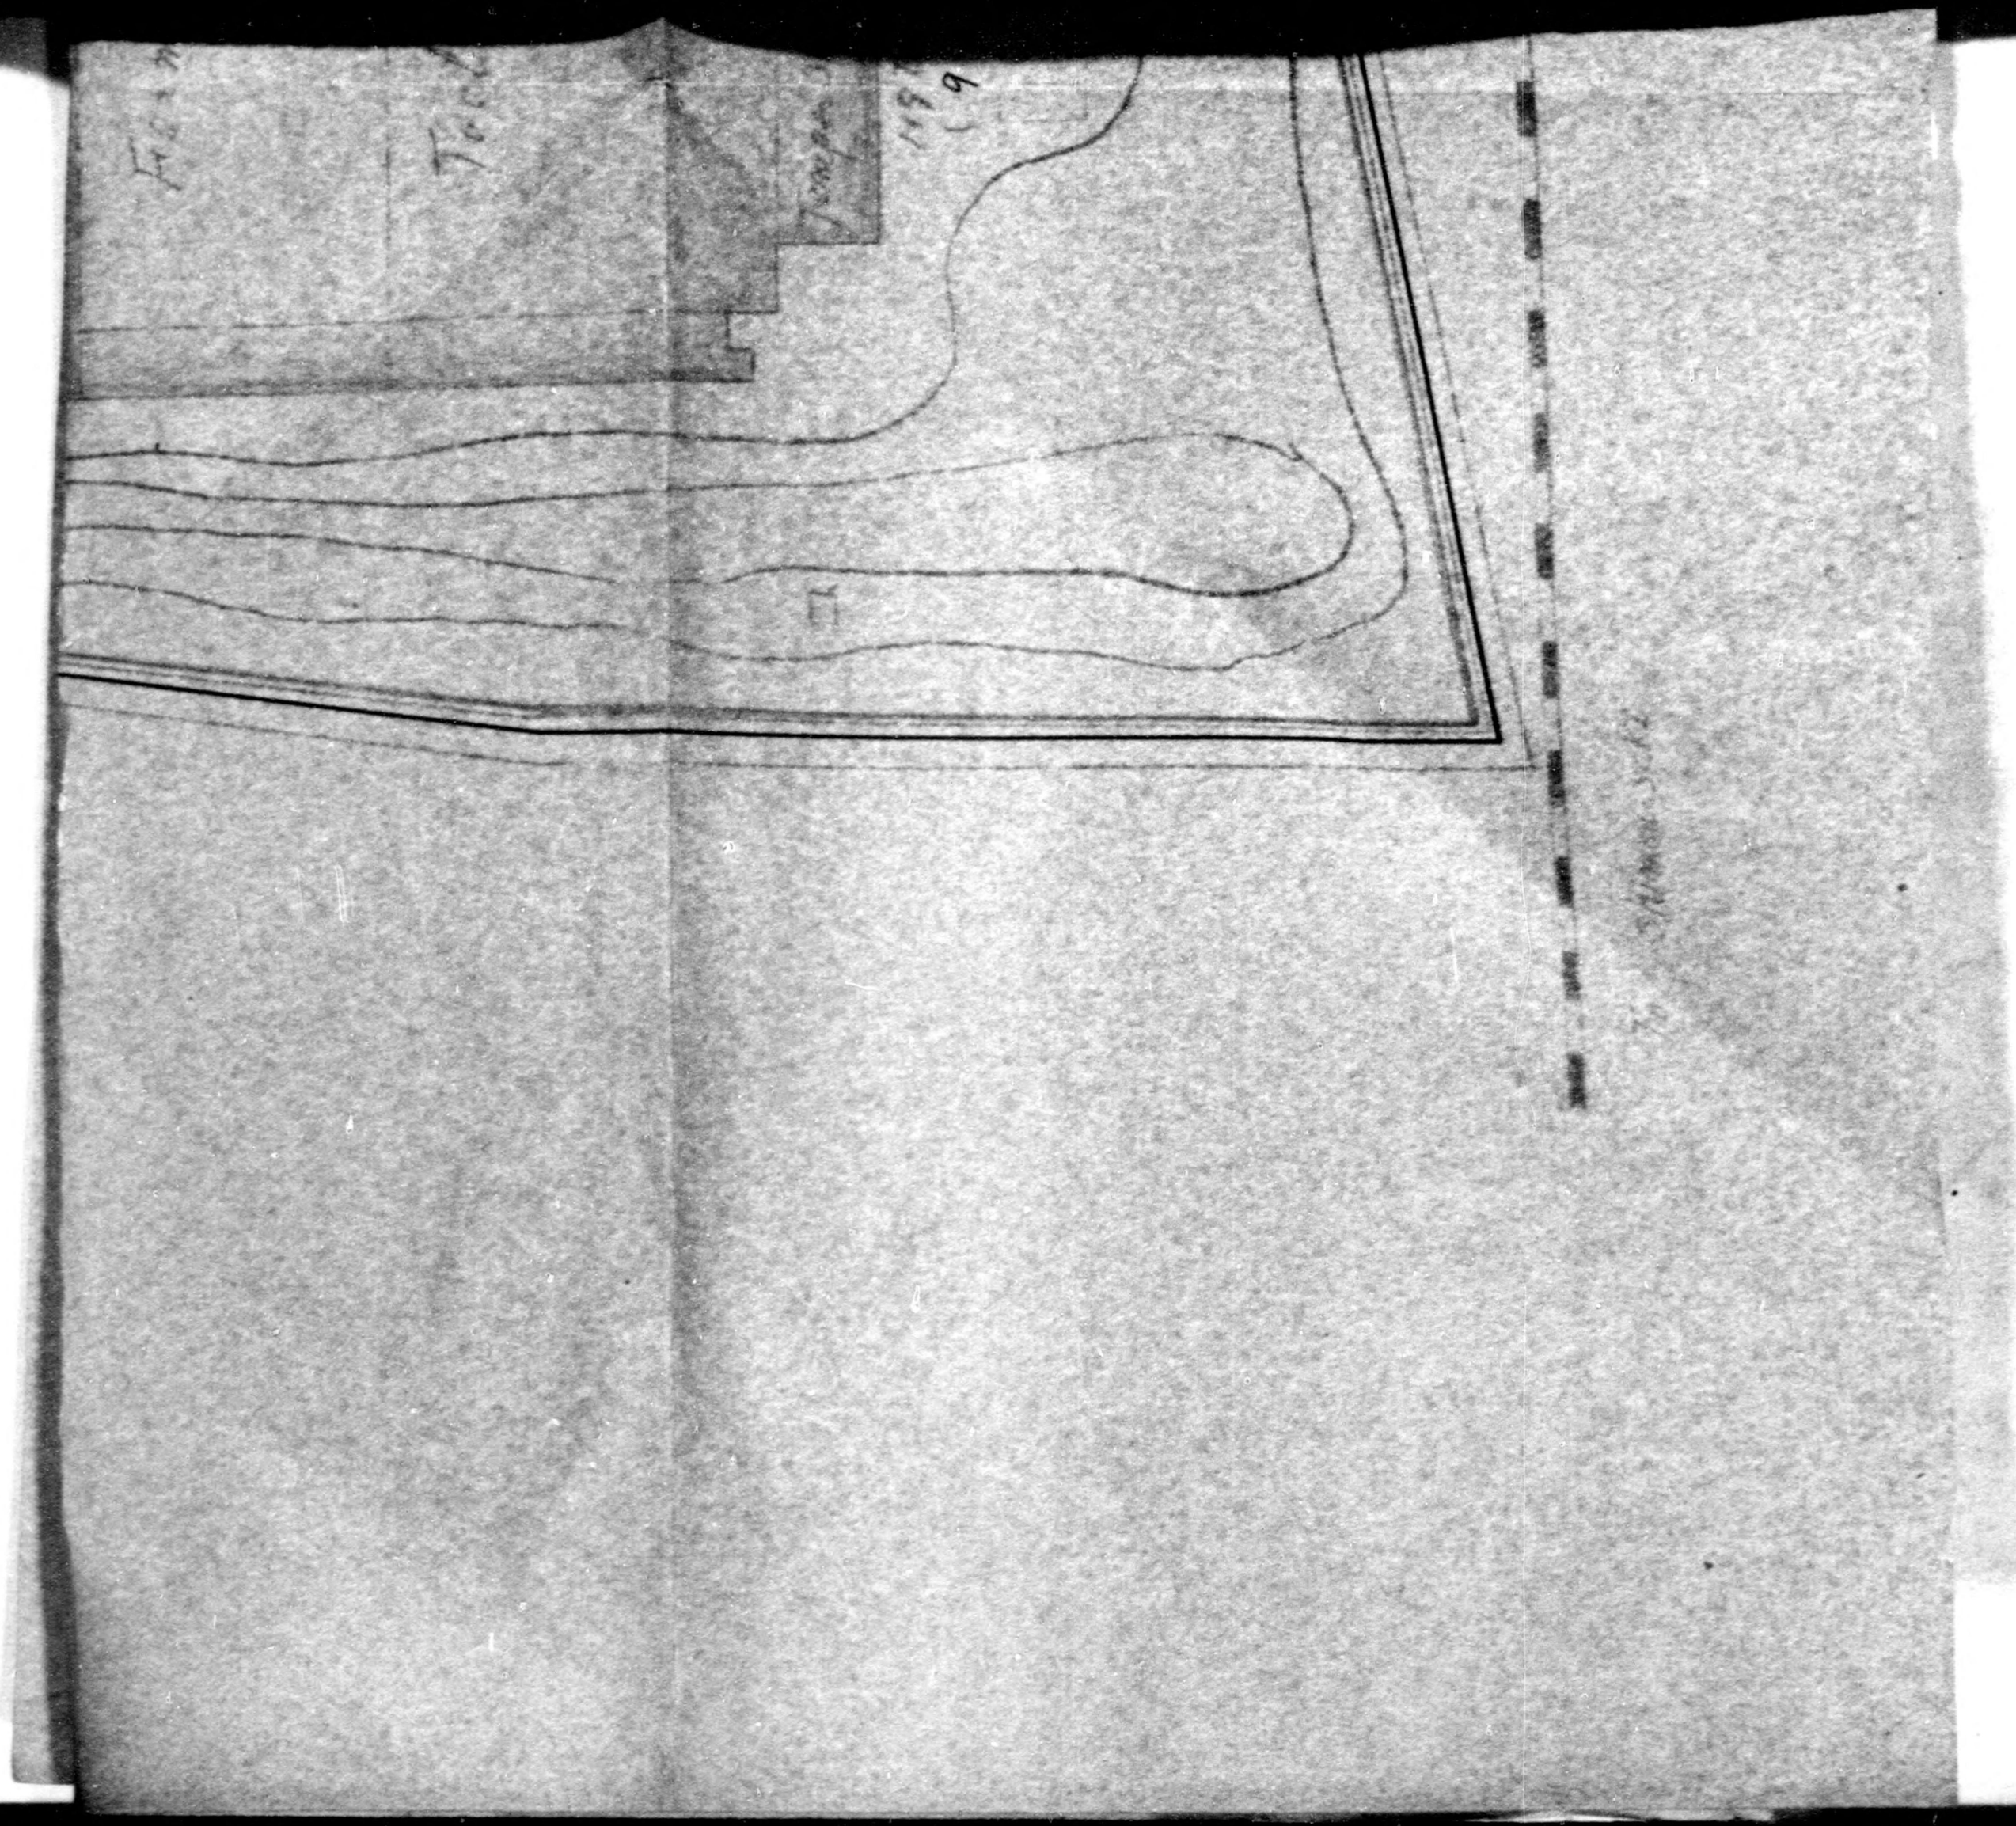

DECLASSIFIED E.O. 12065 SECTION 3 NND 7 MARS REV

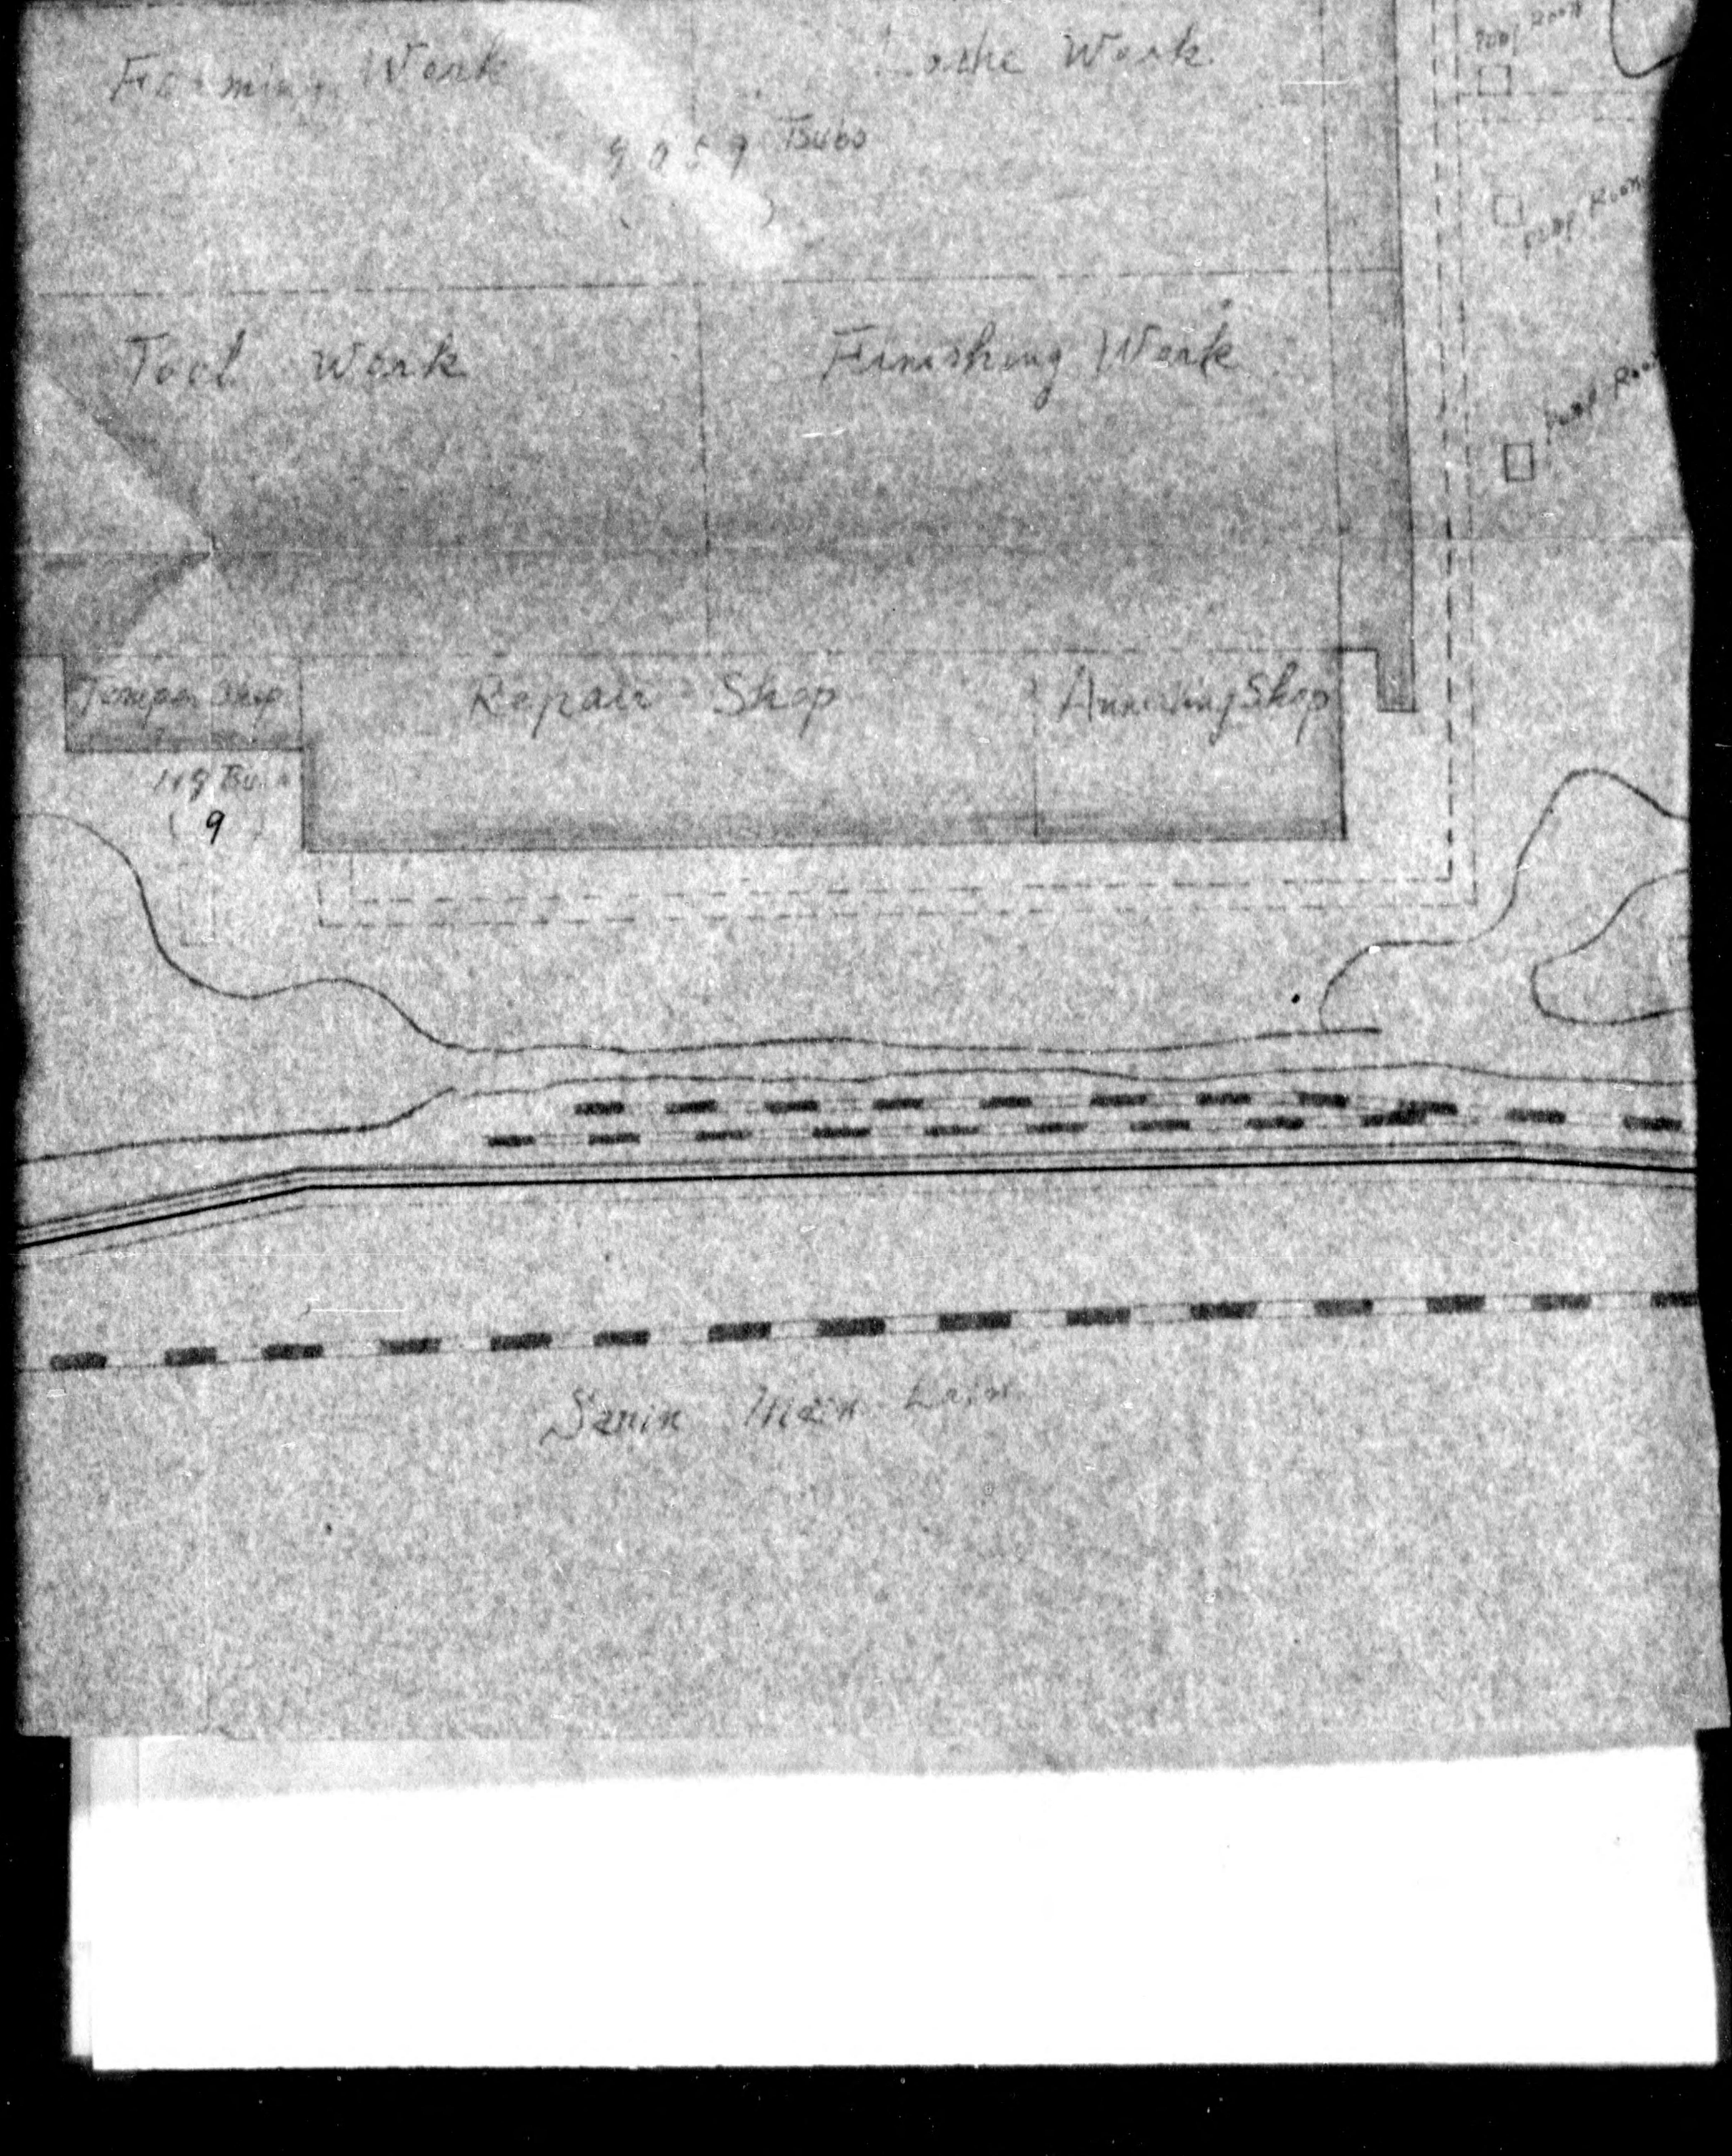
Tool Work
Finishing Work
Repair Shop
Annealing Shop
Pool Room
Pool Room
Pool Room

DECLASSIFIED E.O. 12065 SECTION 3 402 / NNBS NO

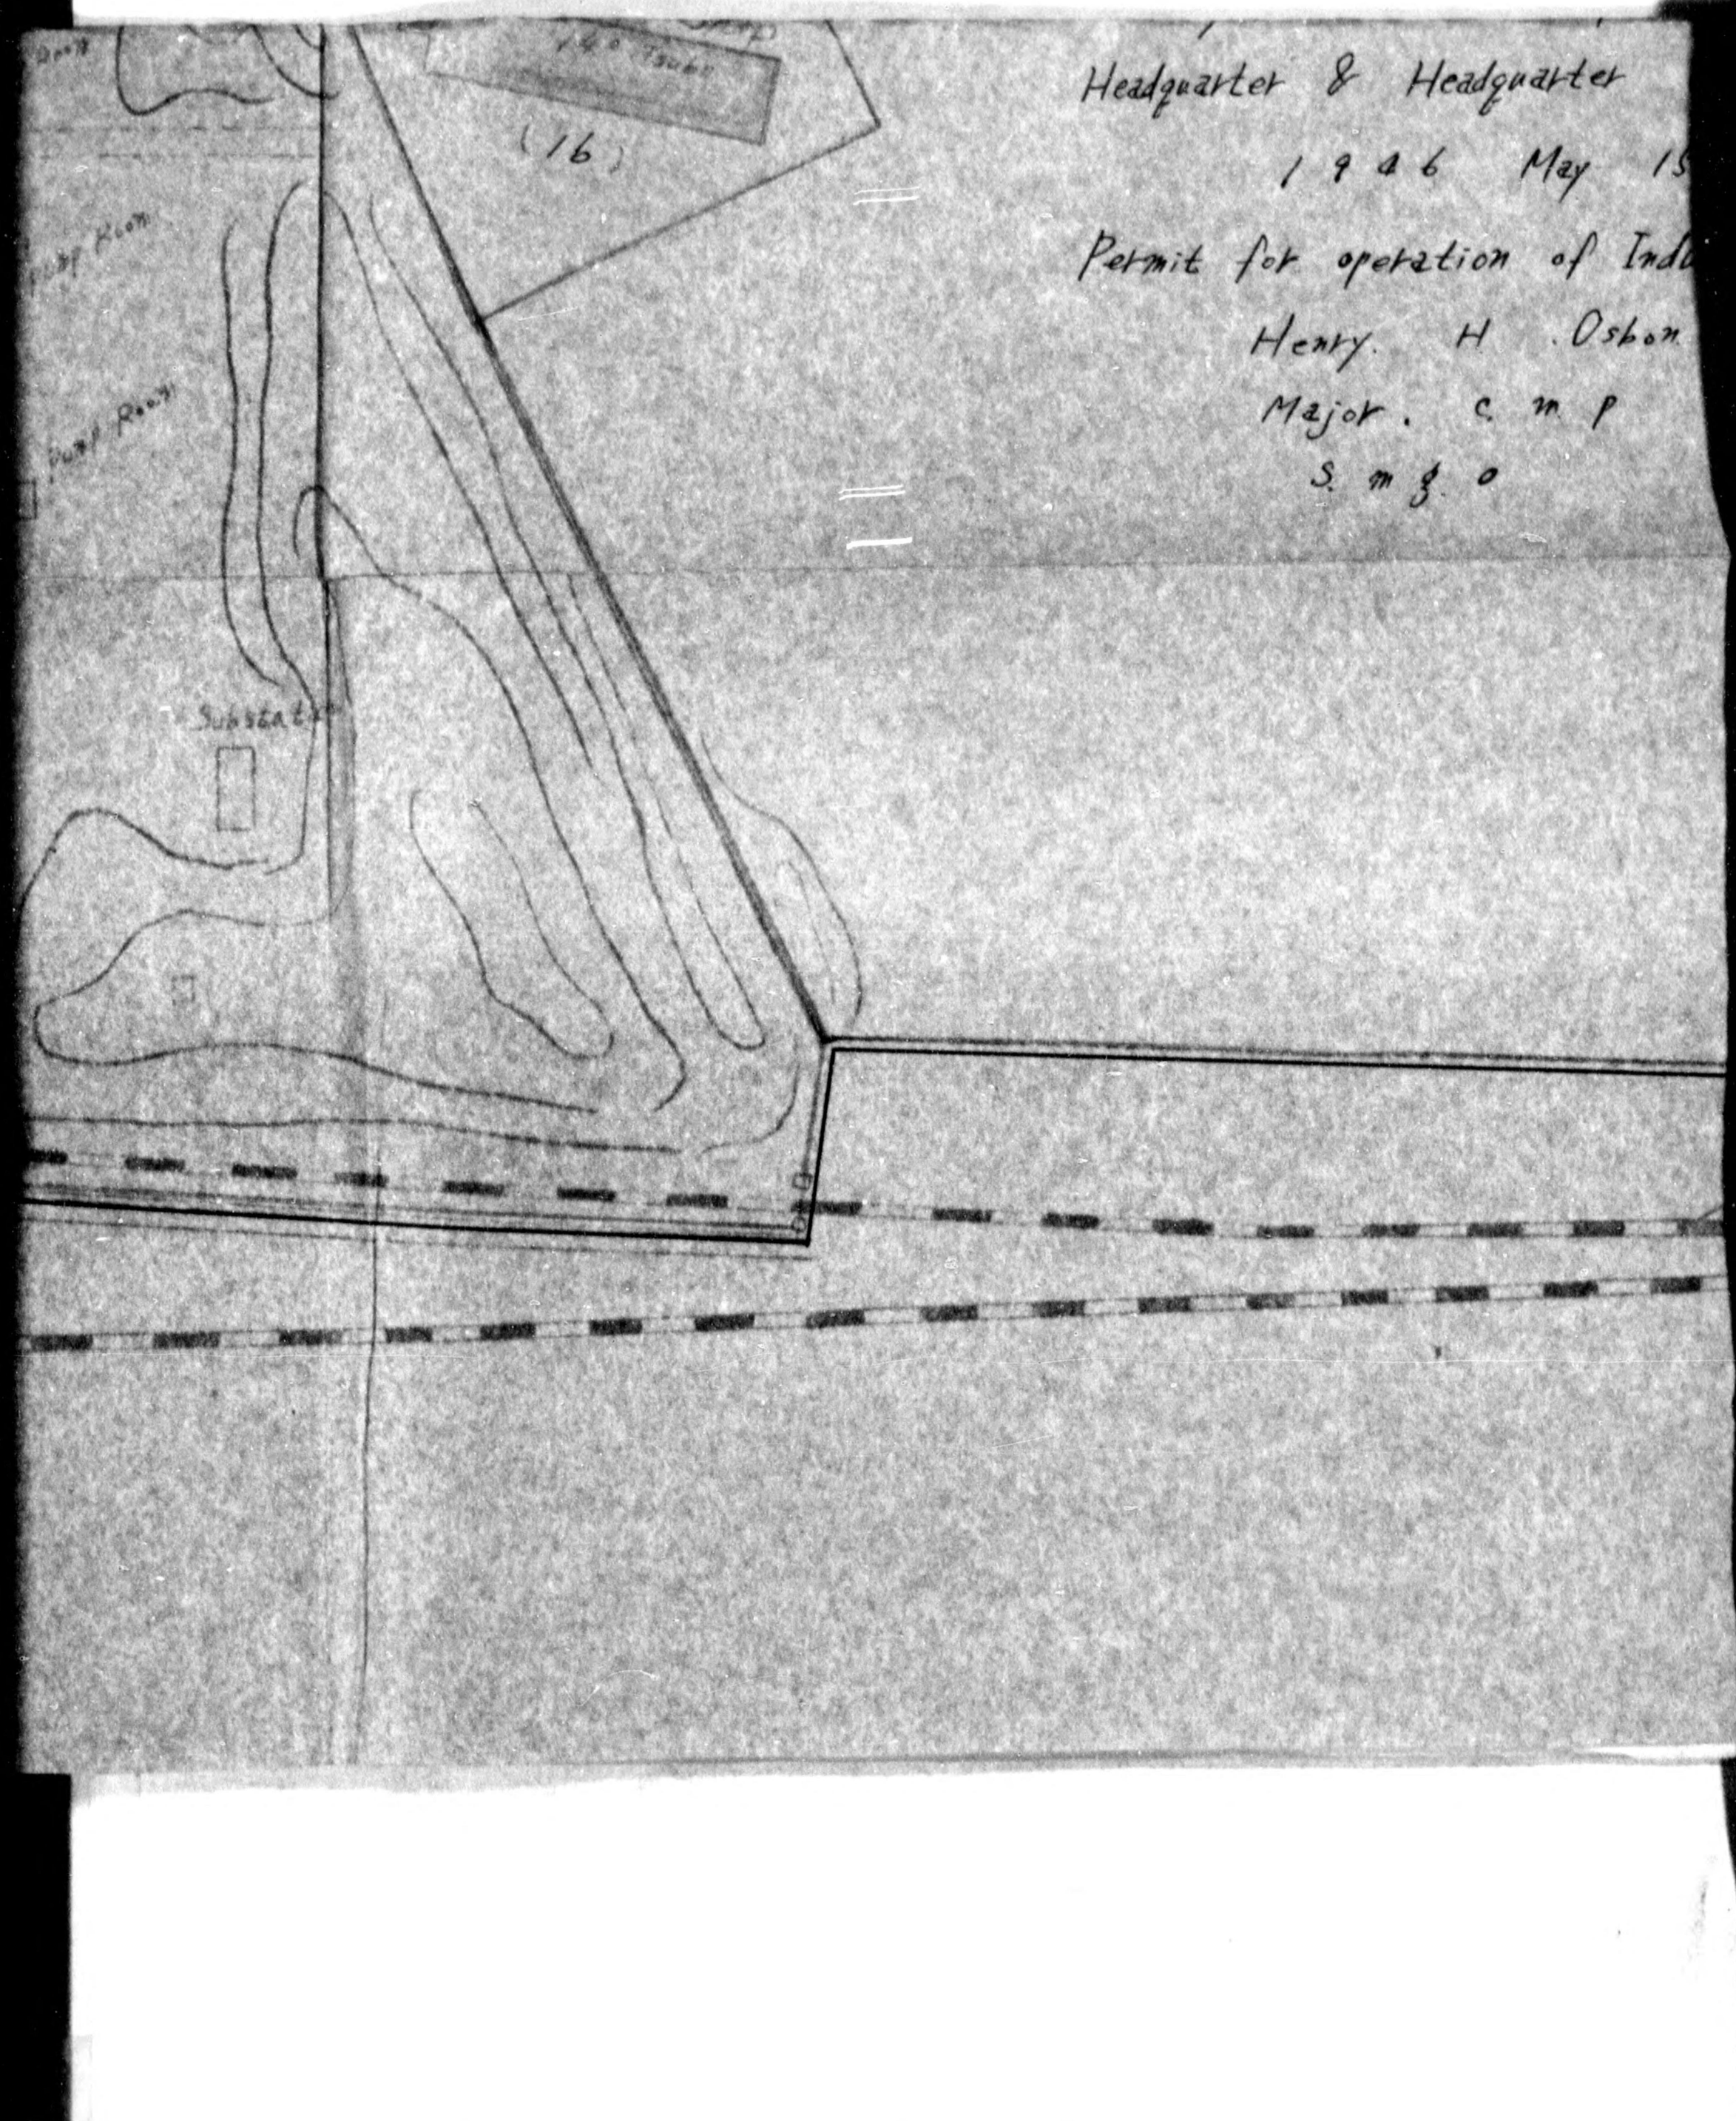

Headquarter & Headquarter

1946 May 15

Permit for operation of Indu

Henry H. Osbon

Major. C. m p

S. m g. o

DECLASSIFIED E.O. 12065 SECTION 3 402 7 NNBS NO.

Headquarter Company.

6 May 15

ation of Industrial Facilities

H. Osbon

c m p

g. o
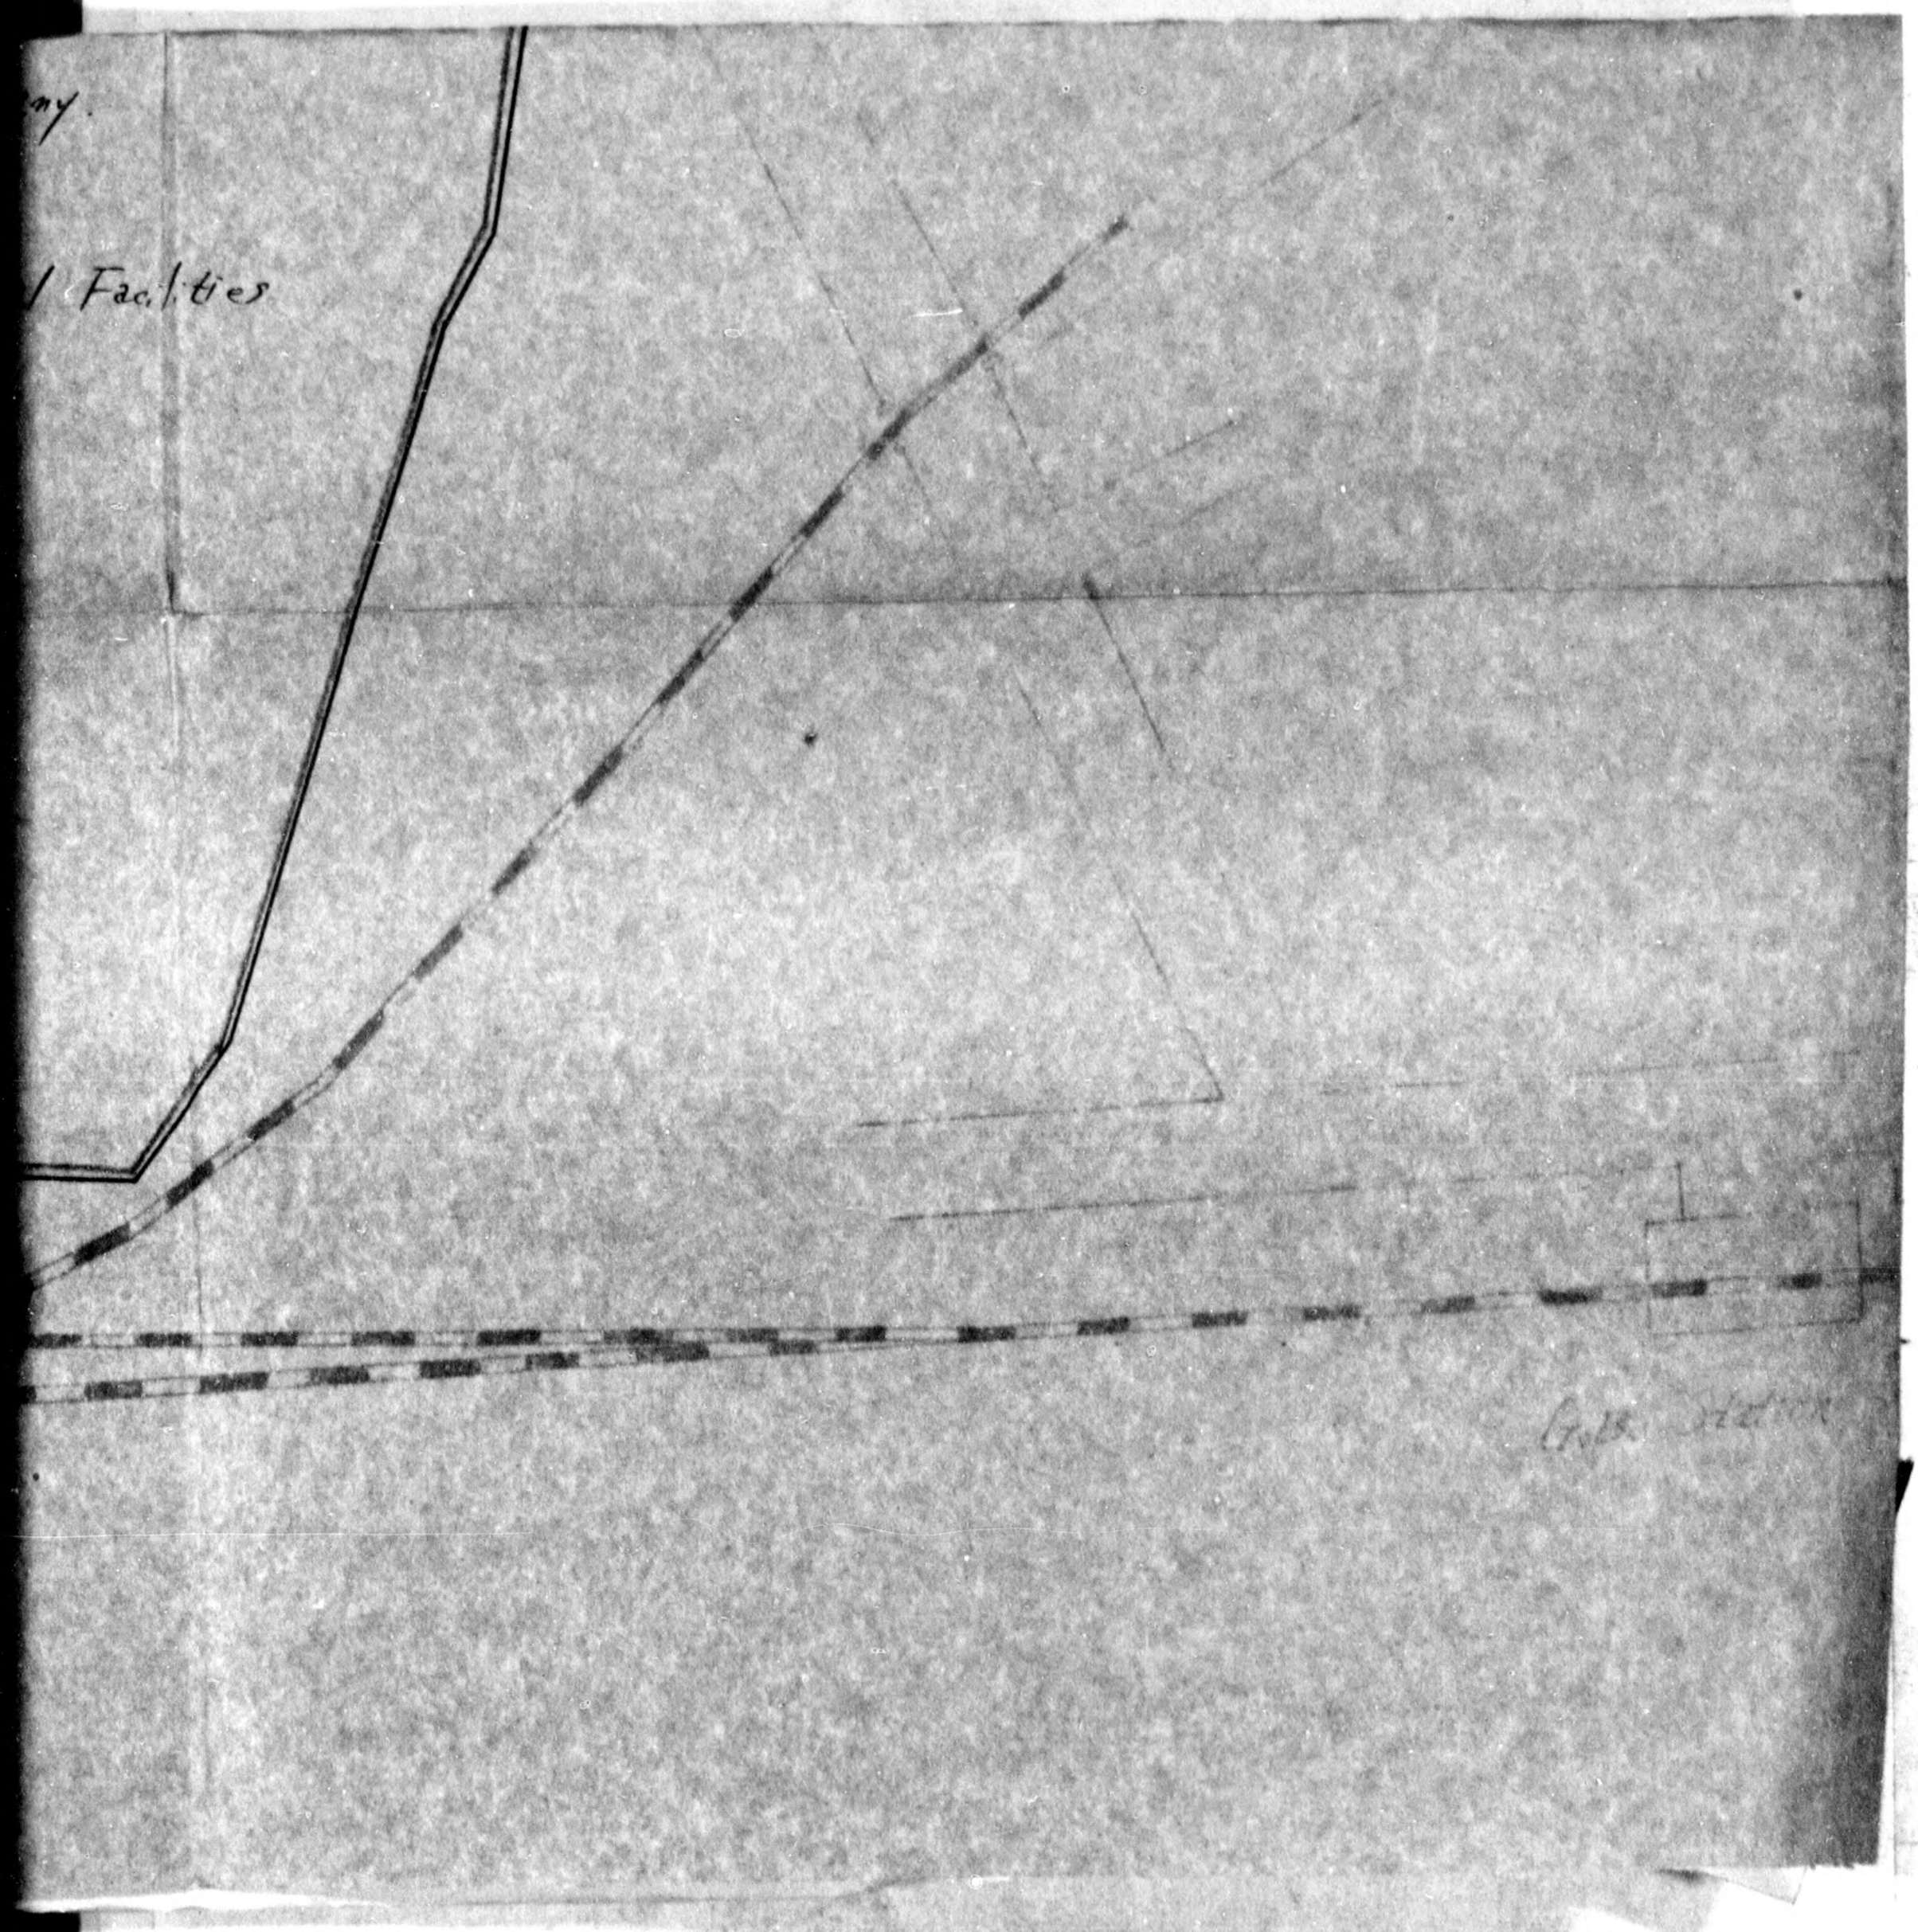
DECLASSIFIED E.O. 12065 SECTION 3-402 / NNBS NO.