

GHQ/SCAP Records (RG 331, National Archives and Records Service)

Description of contents

- (1) Box no. 2903
- (2) Folder title/number: (10)  
No Title

(3) Date: ?

(4) Subject:

Classification	Type of record
9212, 9230	e, r

(5) Item description and comment:

Shiga

(6) Reproduction:  Yes  No

(7) Film no. Sheet no.

(Compiled by National Diet Library)



10

J.M. Fra

MR GOLDSBY  
KINKI CAR

These are inclosures to our ltr 22 June 50 on  
release of Majum Arzanal under OD54. It's  
not answered. Inclosures returned informally  
with instructions to request cancellation of releases.

See tel abstracts 191 7 July  
193 8 July

See ltr 10 Aug 1950 + tel abstract 10 Aug 50  
tel abstract 11 Aug ~~11 Aug~~  
15 Aug stated we take no action  
on Majum till we get  
result on test case  
on 43-04.

22 June 1950



775013

242  
237

M. Fragee

Here are the  
enclosures

R. GOLDSBY  
NKI CAR

RA

Serial 1-7 to  
REAR 51 the  
22 June 1950

June 50 on  
OD 54. Its  
turned informally  
collation releases.

July  
July  
Instrud 10 Aug 50  
we take no action  
Maizum tell we get  
all on test case  
+ 3-04.

S. Freeman



C O P Y

RELEASE OF FORMER JAPANESE MILITARY AND NAVAL INSTALLATIONS

Page 1 of 2 Pages

( 1 ) RECEIVED FROM: CAPT E W MERCER 35TH INFANTRY OTSU SHIGA  
NAME OF OFFICER ORGANIZATION LOCATION PREF.

( 2 ) DATE RECEIVED: 28 Nov 47 (~~PARTIAL~~) (FINAL) RELEASE  
(delete one)

(READ INSTRUCTIONS ON BACK OF THIS FORM)

( 3 ) LOCATION ( 4 ) INSTALLATIONS ( 10 ) ESTIMATED VALUE IN YEN  
OBTAINED FROM MINISTRY OF FINANCE, BUREAU OF STATE PROPERTY

Maizuru Naval Arsenal 2d Arsenal Dept. Kuratani, Maizuru shi, Kyoto fu. Grid Coord: (1033.9-1386.2)	9 buildings, wooden, 1 & 2 storied. Floor space: 819.25 tsubo.	¥ 65,540.00
--	--	-------------

( 5 ) IMPROVEMENTS BY OCCUPATION FORCES ( 9 ) IMPROVEMENT VALUATION IN DOLLARS  
 No Improvements \_\_\_\_\_

( 6 ) DROPPED FROM PROPERTY RECORDS OF Not on Property Records of 35th Infantry  
PROPERTY RECORDS OF BY ORGANIZATION ACCOUNTABLE OFFICER RANK

REMARKS:  
 CERTIFIED CORRECT EXCEPT AS NOTED INITIATED

( 7 ) BY Enos L. Commons Jr. Capt AC Kyoto Mil Govt Team, APO 713 4 Dec 1947  
RELEASING OFFICER ORGANIZATION DATE

( 8 ) BY Director of Kyoto Pref general affair Dept. Nov. 28  
JAPANESE REPRESENTATIVE AGENCY DATE

OGA FORM 1 as amended,  
 Incl No. 3, Annex 10, Adm O 25.

*Incl. No. 1*



C O P Y

RELEASE OF FORMER JAPANESE MILITARY AND NAVAL INSTALLATIONS

Page 1 of 2 Pages

( 1 ) RECEIVED FROM: 1st Lt F T BOCKOVEN 35TH INF REGT OTSU SHIGA

NAME OF OFFICER ORGANIZATION LOCATION PREF.

( 2 ) DATE RECEIVED: 3 Apr 48 (~~PARTIAL~~) (FINAL) RELEASE  
(delete one)

(READ INSTRUCTIONS ON BACK OF THIS FORM)

( 3 ) LOCATION ( 4 ) INSTALLATIONS ( 10 ) ESTIMATED VALUE IN YEN  
OBTAINED FROM MINISTRY  
OF FINANCE, BUREAU OF  
STATE PROPERTY

Former Maizuru Naval  
Arsenal, Main Arsenal  
District, Kyoto fu,  
Maizuru shi, Aza Yobe  
Grid Coord: (1037.2 -  
1390.4).

Land: 199,417 tsubo.  
Bldgs: 159 houses; wooden  
flat two storied, steel  
framed flat two storied ¥ 17,507,826.00  
and brick flat two storied  
and 10 fixtures. Floor space:  
35,682 tsubo.  
Land: 76,310 tsubo.  
Bldg: 43 houses; wooden flat  
two storied and steel framed

( 5 ) IMPROVEMENTS BY ( 9 ) IMPROVEMENT  
OCCUPATION FORCES VALUATION IN DOLLARS

NO IMPROVEMENT

( 6 ) DROPPED FROM  
PROPERTY RECORDS OF \_\_\_\_\_ BY \_\_\_\_\_  
ORGANIZATION ACCOUNTABLE OFFICER RANK

REMARKS:  
CERTIFIED CORRECT EXCEPT AS NOTED INITIATED

( 7 ) BY \_\_\_\_\_  
RELEASING OFFICER ORGANIZATION DATE

( 8 ) BY \_\_\_\_\_  
JAPANESE REPRESENTATIVE AGENCY DATE

OGA FORM 1 as amended,  
Incl No. 3, Annex 10, Adm O 25.

*Incl No. 2*



C O P Y

RELEASE OF FORMER JAPANESE MILITARY AND NAVAL INSTALLATIONS

Page 2 of 2 Pages

( 1 ) RECEIVED FROM: 1st Lt F T BOCKOVEN 35TH INF REGT OTSU SHIGA  
NAME OF OFFICER ORGANIZATION LOCATION PREF.

( 2 ) DATE RECEIVED: 3 Apr 48 (~~PARSIAL~~) (FINAL) RELEASE  
(delete one)

(READ INSTRUCTIONS ON BACK OF THIS FORM)

( 3 ) LOCATION ( 4 ) INSTALLATIONS ( 10 ) ESTIMATED VALUE IN YEN  
OBTAINED FROM MINISTRY OF FINANCE, BUREAU OF STATE PROPERTY

Former Maizuru Naval Arsenal, Main Arsenal District, Kyoto fu, Maizuru shi, Aza Yobe, Grid Coord: (1037.2 - 1390.4).

flat two storied. 2,843 tsubo floor space. Land: 13,340 tsubo. Bldgs: 9 houses; wooden flat two storied and 1 fixture. 1,528 tsubo floor space.

( 5 ) IMPROVEMENTS BY OCCUPATION FORCES ( 9 ) IMPROVEMENT VALUATION IN DOLLARS  
 NO IMPROVEMENT

( 6 ) DROPPED FROM PROPERTY RECORDS OF 35th Inf Regt BY 1st Lt F T BOCKOVEN 3 Apr 48  
ORGANIZATION ACCOUNTABLE OFFICER RANK

REMARKS:  
 CERTIFIED CORRECT EXCEPT AS NOTED INITIATED

( 7 ) BY ENOS L. COMMONS Jr. Capt AC Kyoto Mil Govt Team 23 April 1948  
RELEASING OFFICER ORGANIZATION DATE

( 8 ) BY Chief of the Kyoto district office of the osaka financial bureau of the financial department. 20 April 1948  
JAPANESE REPRESENTATIVE AGENCY DATE

OGA FORM 1 as amended,  
 Incl No. 3, Annex 10, Adm O 25.

*Incl No. 3*



C O P Y

RELEASE OF FORMER JAPANESE MILITARY AND NAVAL INSTALLATIONS

Page 1 of 1 Pages

( 1 ) RECEIVED FROM: 1st Lt F T BOCKOVEN 35TH INF REGT OTSU SHIGA  
NAME OF OFFICER ORGANIZATION LOCATION PREF.

( 2 ) DATE RECEIVED: 8 Apr 48 (~~PARTIAL~~) (FINAL) RELEASE  
 (delete one)

(READ INSTRUCTIONS ON BACK OF THIS FORM)

( 3 ) LOCATION ( 4 ) INSTALLATIONS ( 10 ) ESTIMATED VALUE IN YEN  
 OF FINANCE, BUREAU OF STATE PROPERTY

Former Maizuru Naval Arsenal #2 Arms Manu- factory (outside the factory site), Maizuru shi, Kyoto fu. Grid Coord: (1033.8 - 1386.3).

Land: 115,986 tsubo.  
 Bldgs: 7 houses, wooden, flat, two storied. Floor space: 1,727 tsubo. ¥ 2,180,714.00

( 5 ) IMPROVEMENTS BY OCCUPATION FORCES ( 9 ) IMPROVEMENT VALUATION IN DOLLARS  
 NO IMPROVEMENT

( 6 ) DROPPED FROM PROPERTY RECORDS OF 35th Inf Regt BY F T BOCKOVEN 1st Lt 8 Apr 48  
ORGANIZATION ACCOUNTABLE OFFICER RANK

REMARKS:  
 CERTIFIED CORRECT EXCEPT AS NOTED INITIATED


( 7 ) BY ENOS L. COMMONS Jr. Capt AC. Kyoto Mil Govt Team 23 April 1948  
RELEASING OFFICER ORGANIZATION DATE  
 Chief of the Kyoto district office of the Osaka financial  
 ( 8 ) BY bureau of the financial department. 20 April 1948  
JAPANESE REPRESENTATIVE AGENCY DATE

OGA FORM 1 as amended,  
 Incl No. 3, Annex 10, Adm O 25.

*Incl. No. 4*



775013

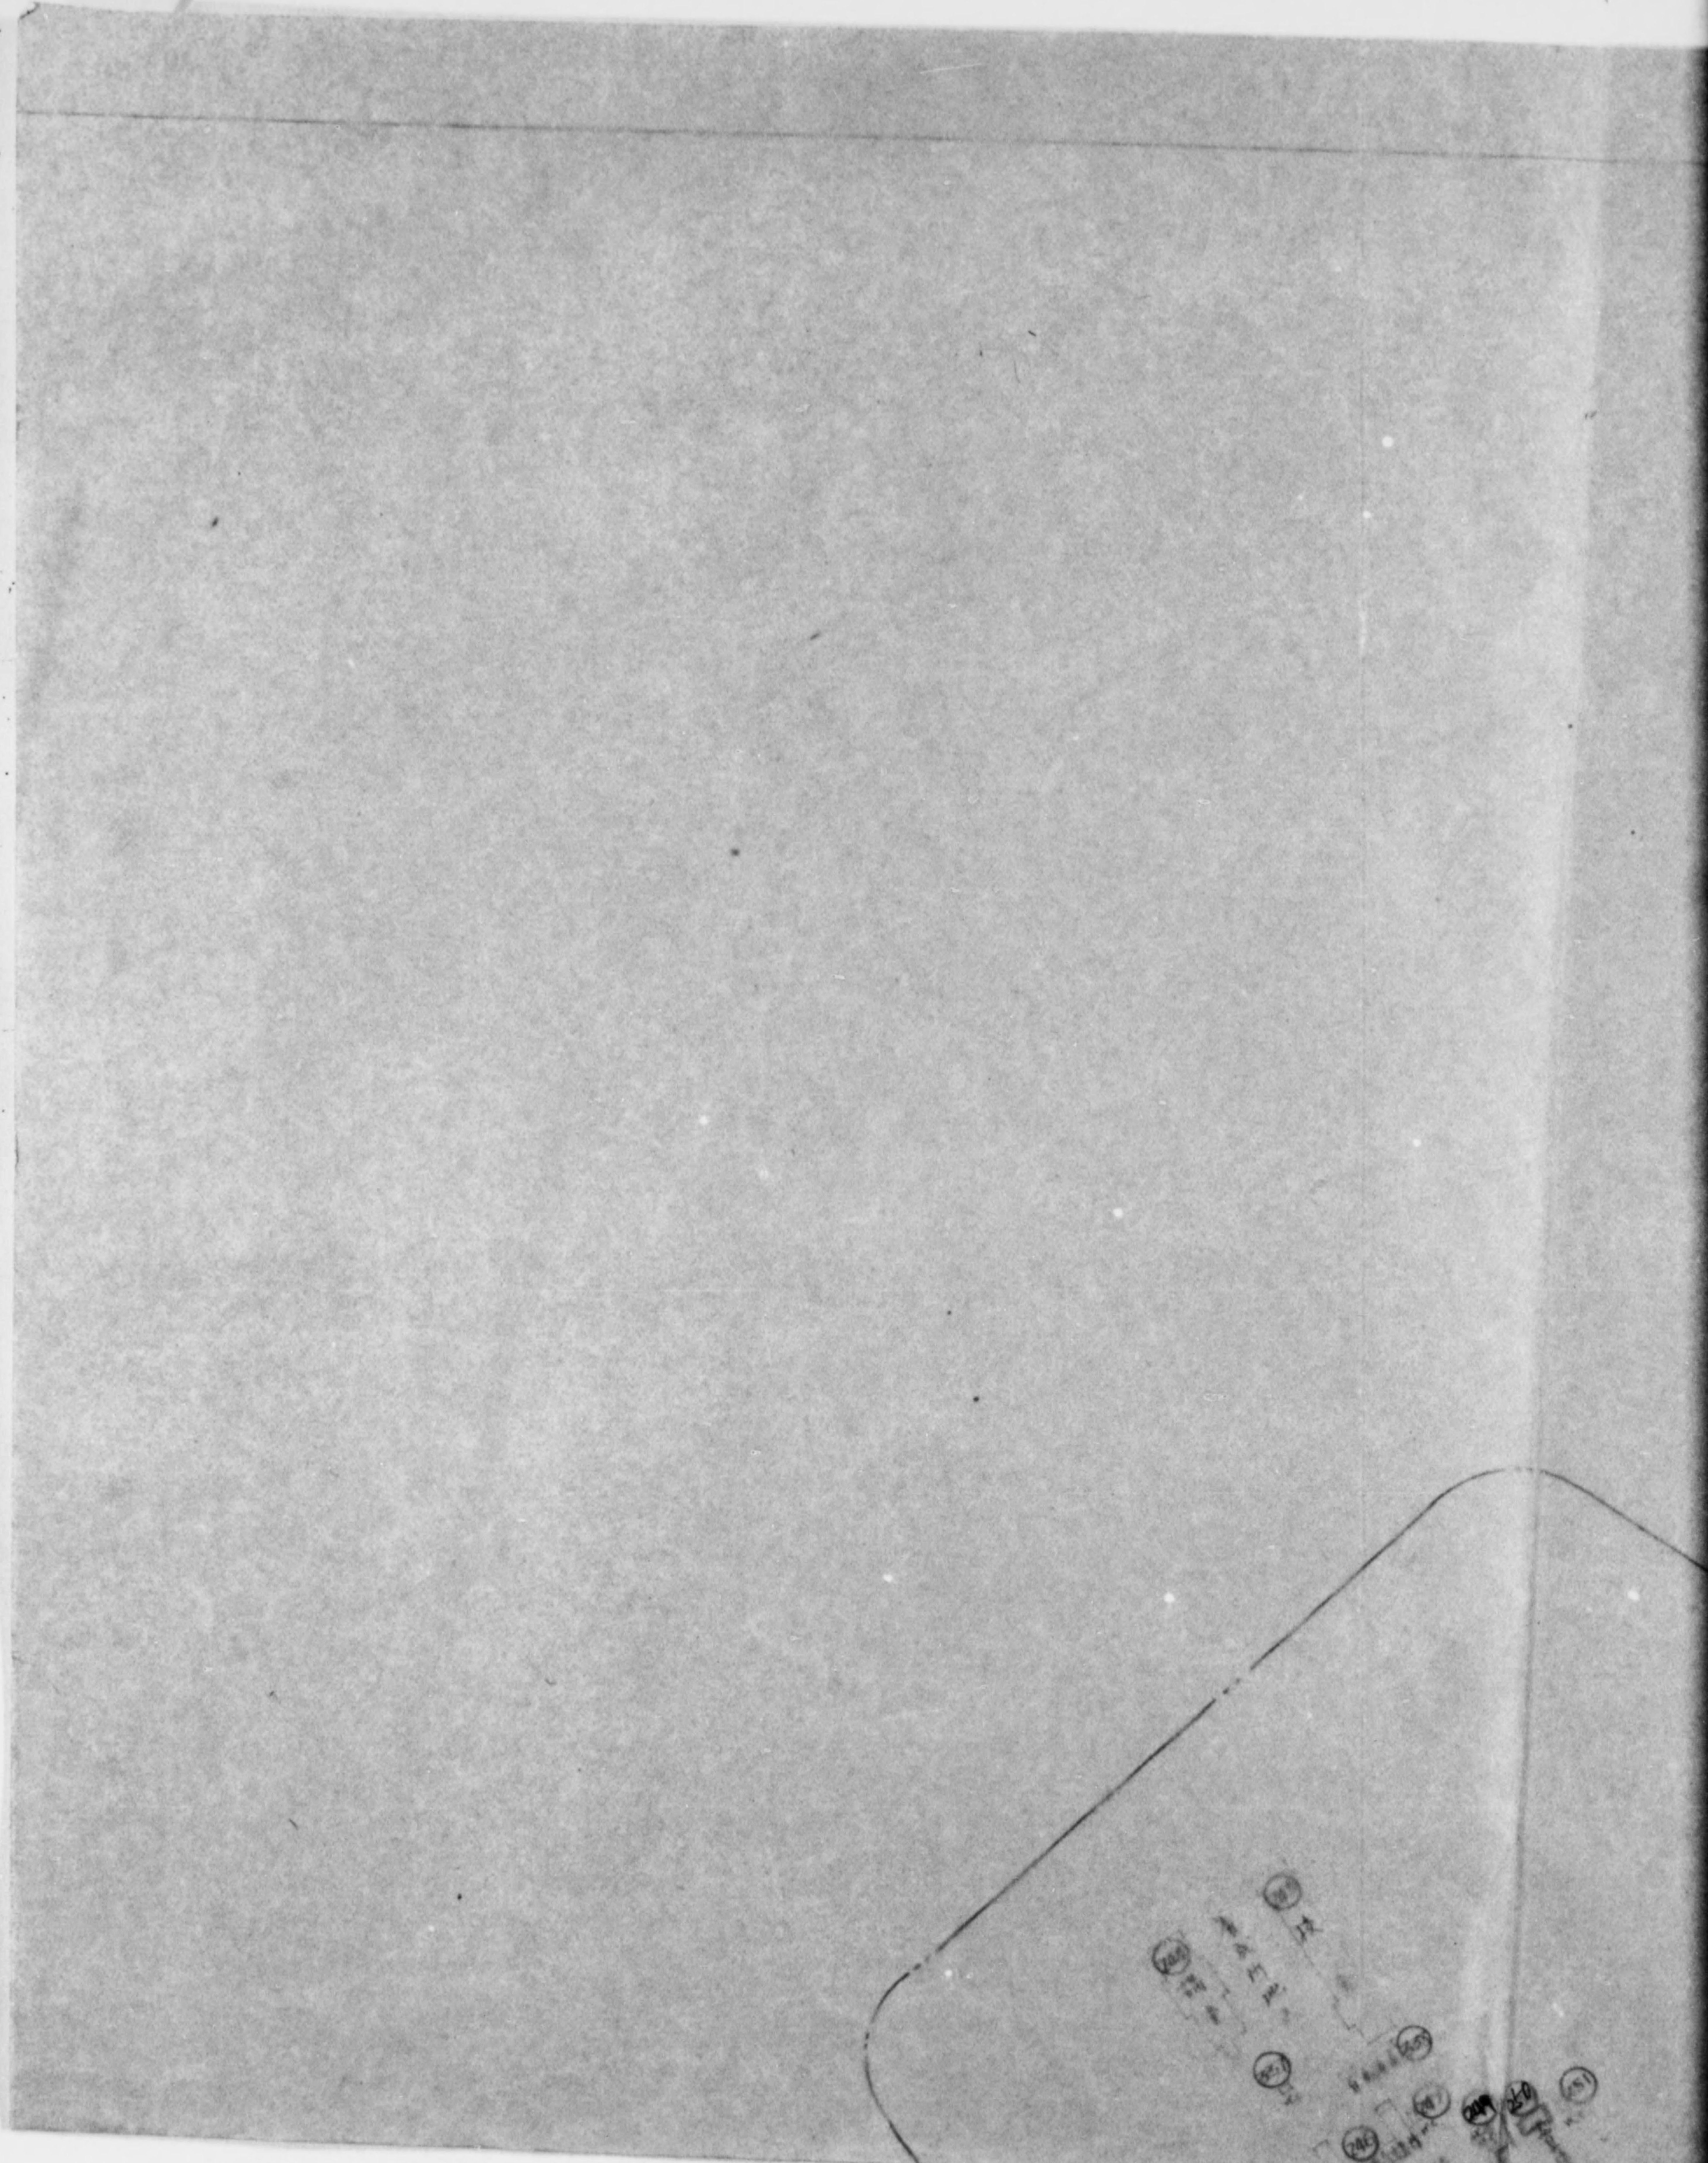




775013


22-257

長

中


小

短

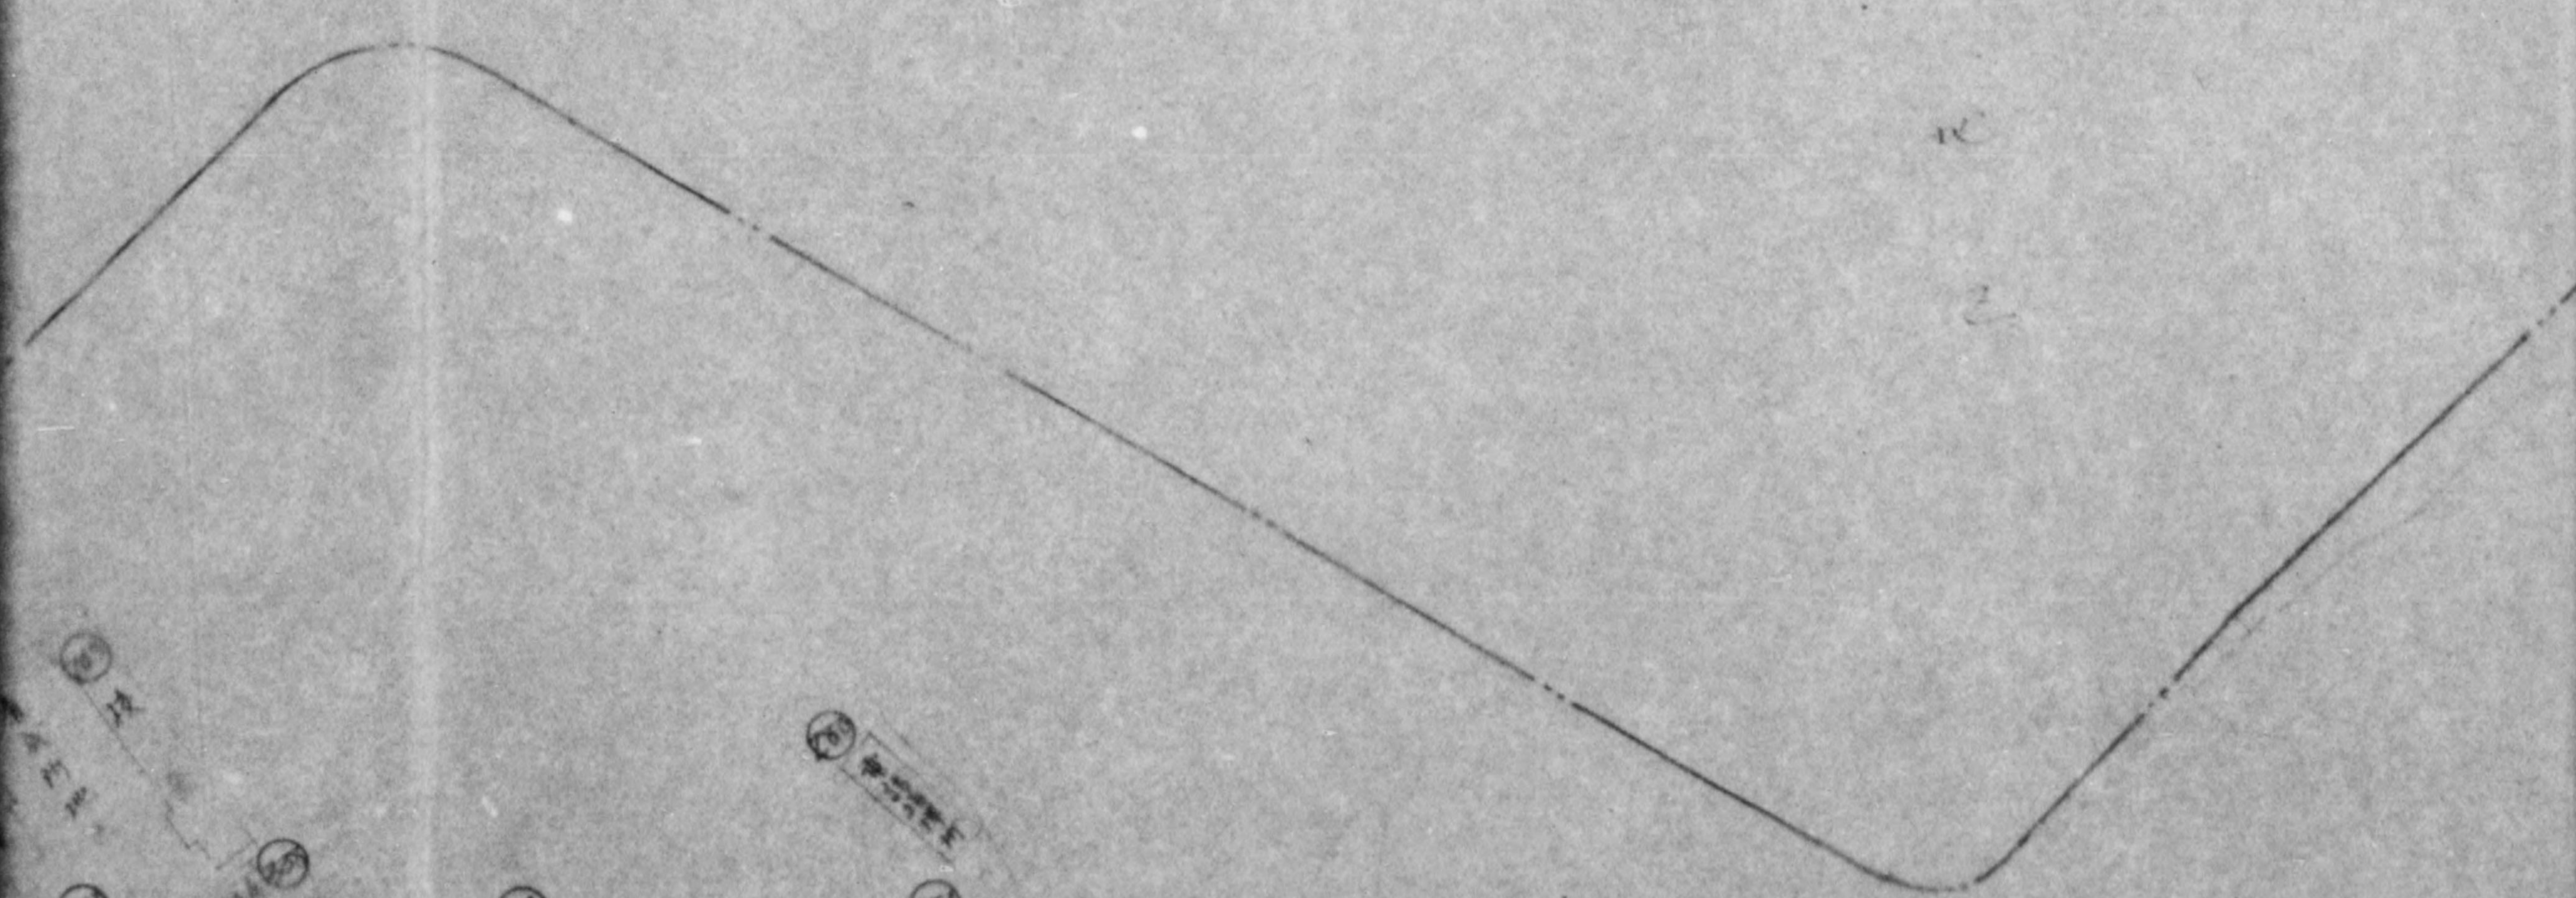


①  



 



775013

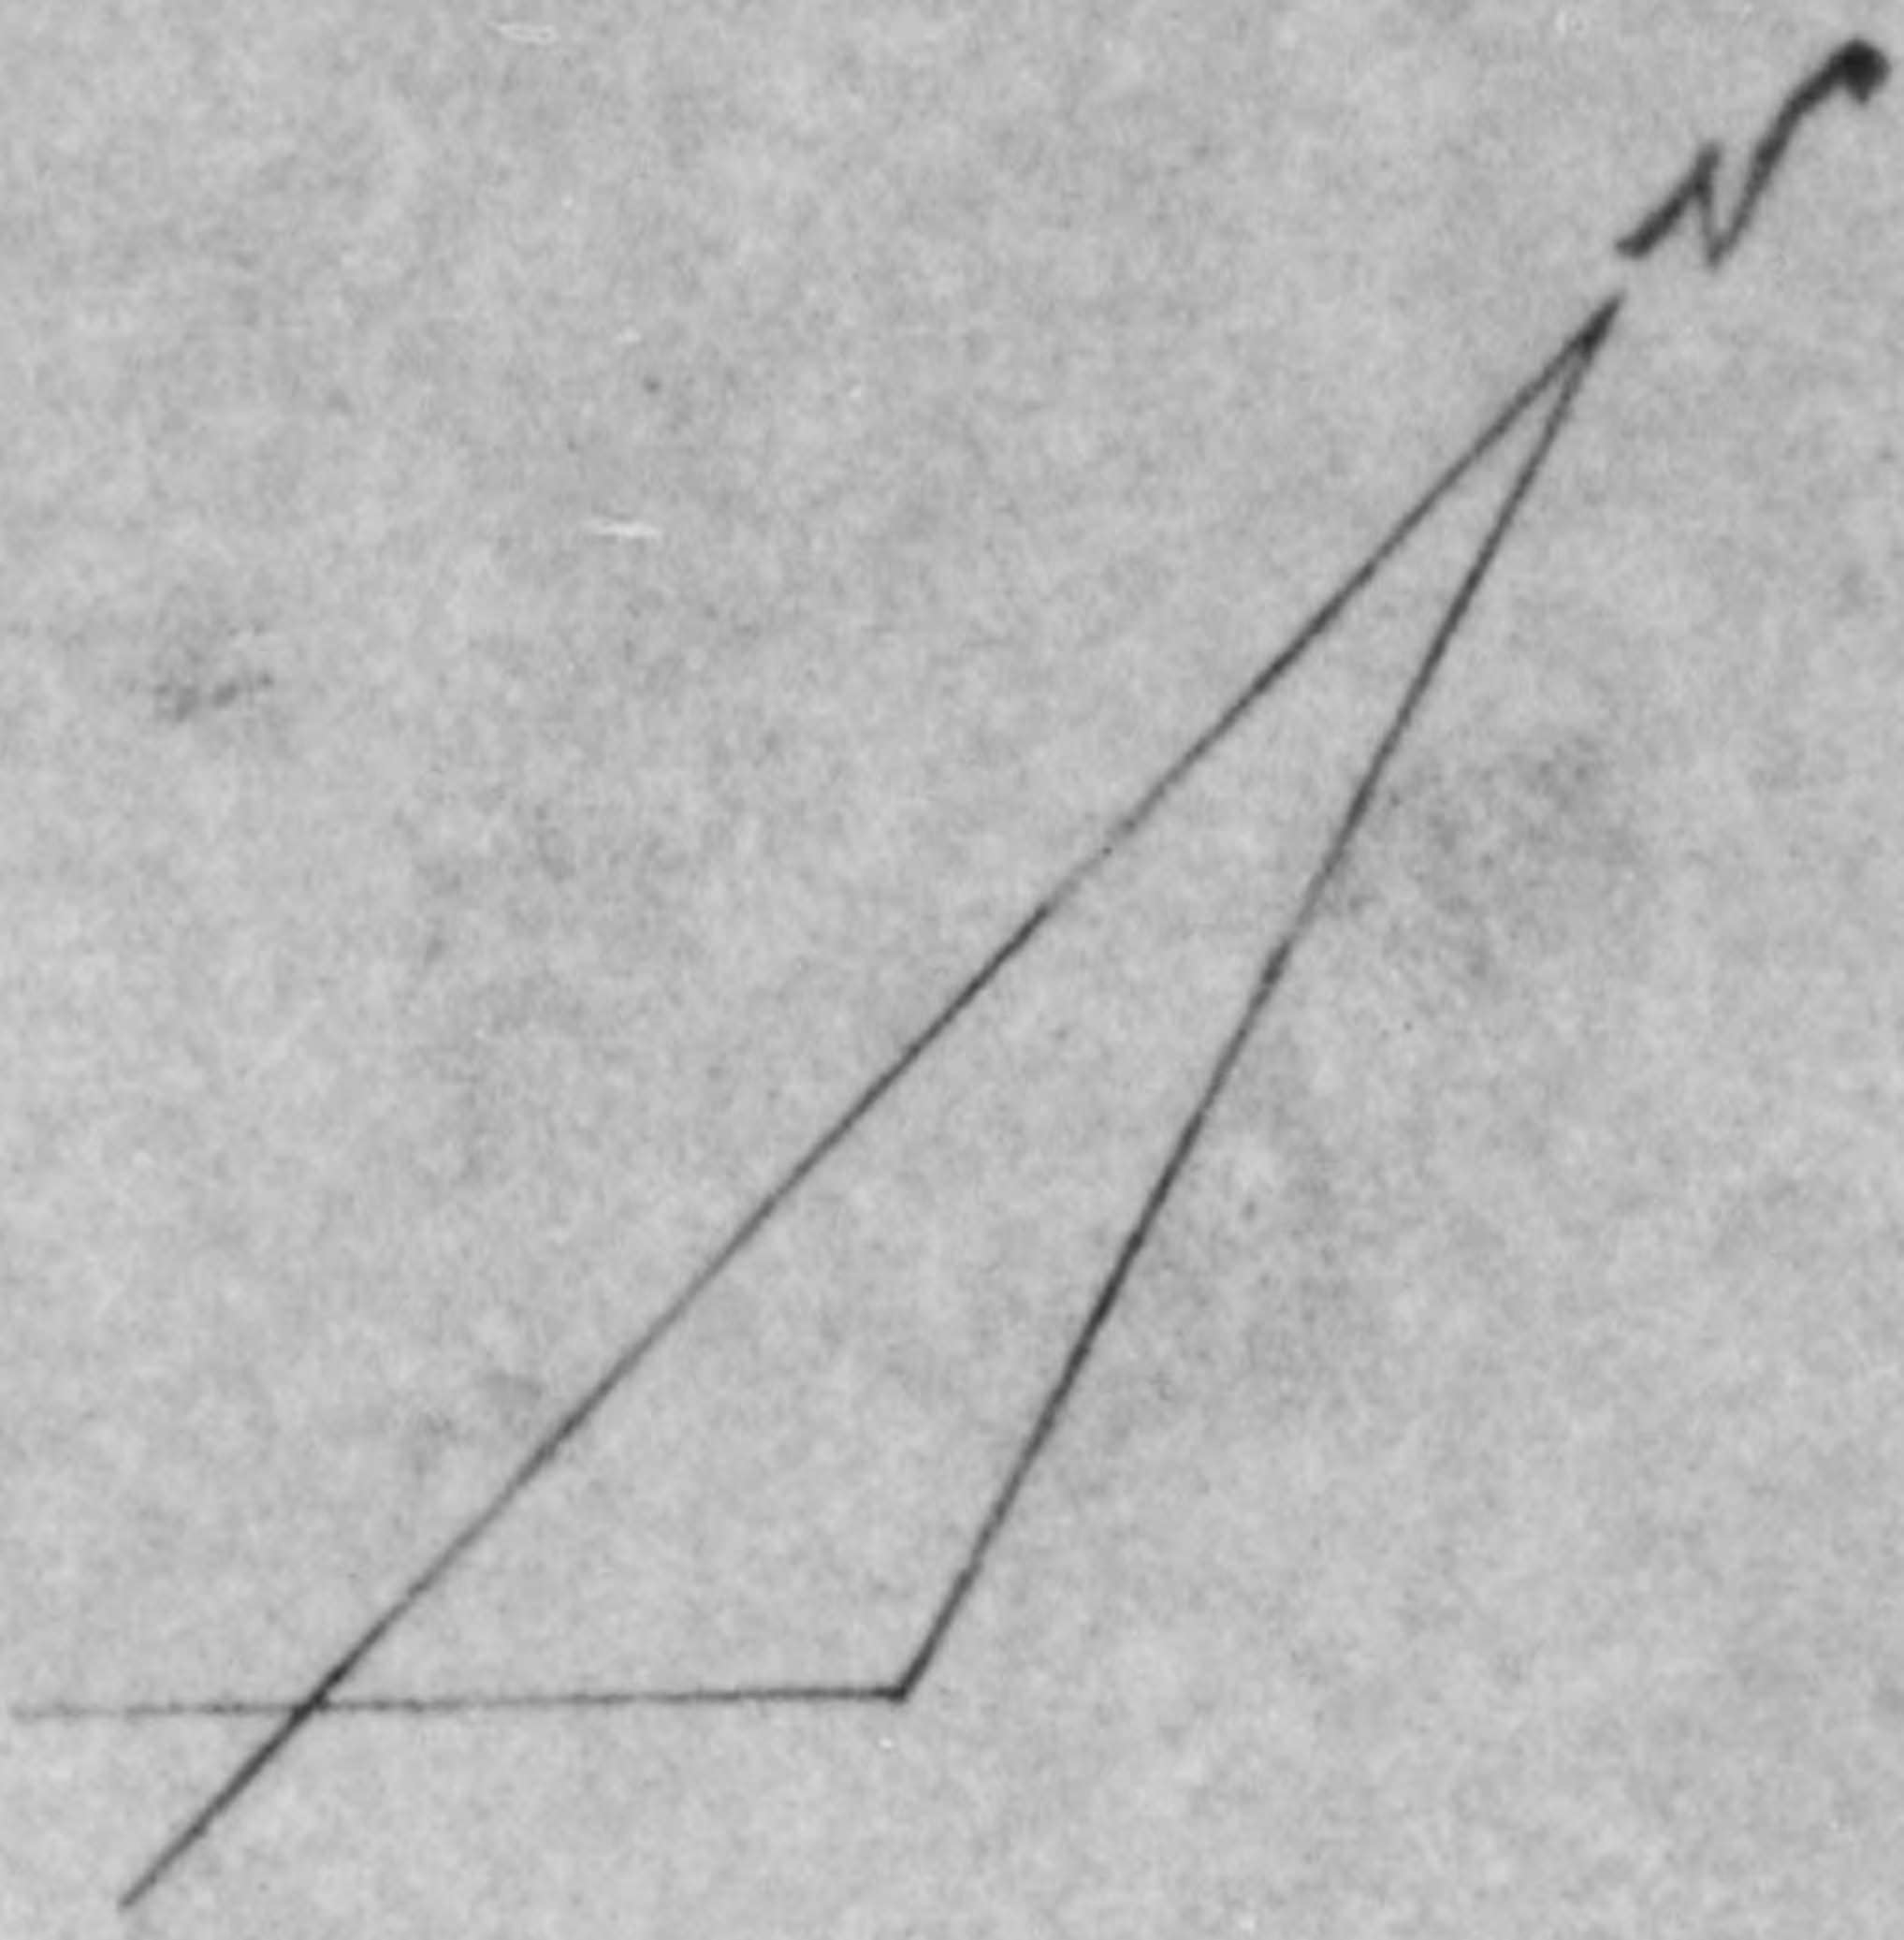

本瓦雁

所崎又

地地地

己己己

舞鶴造船

建物及構造物位置圖

縮尺課長部長技師技手

1/2500


飯野中男

昭和22年10月30日







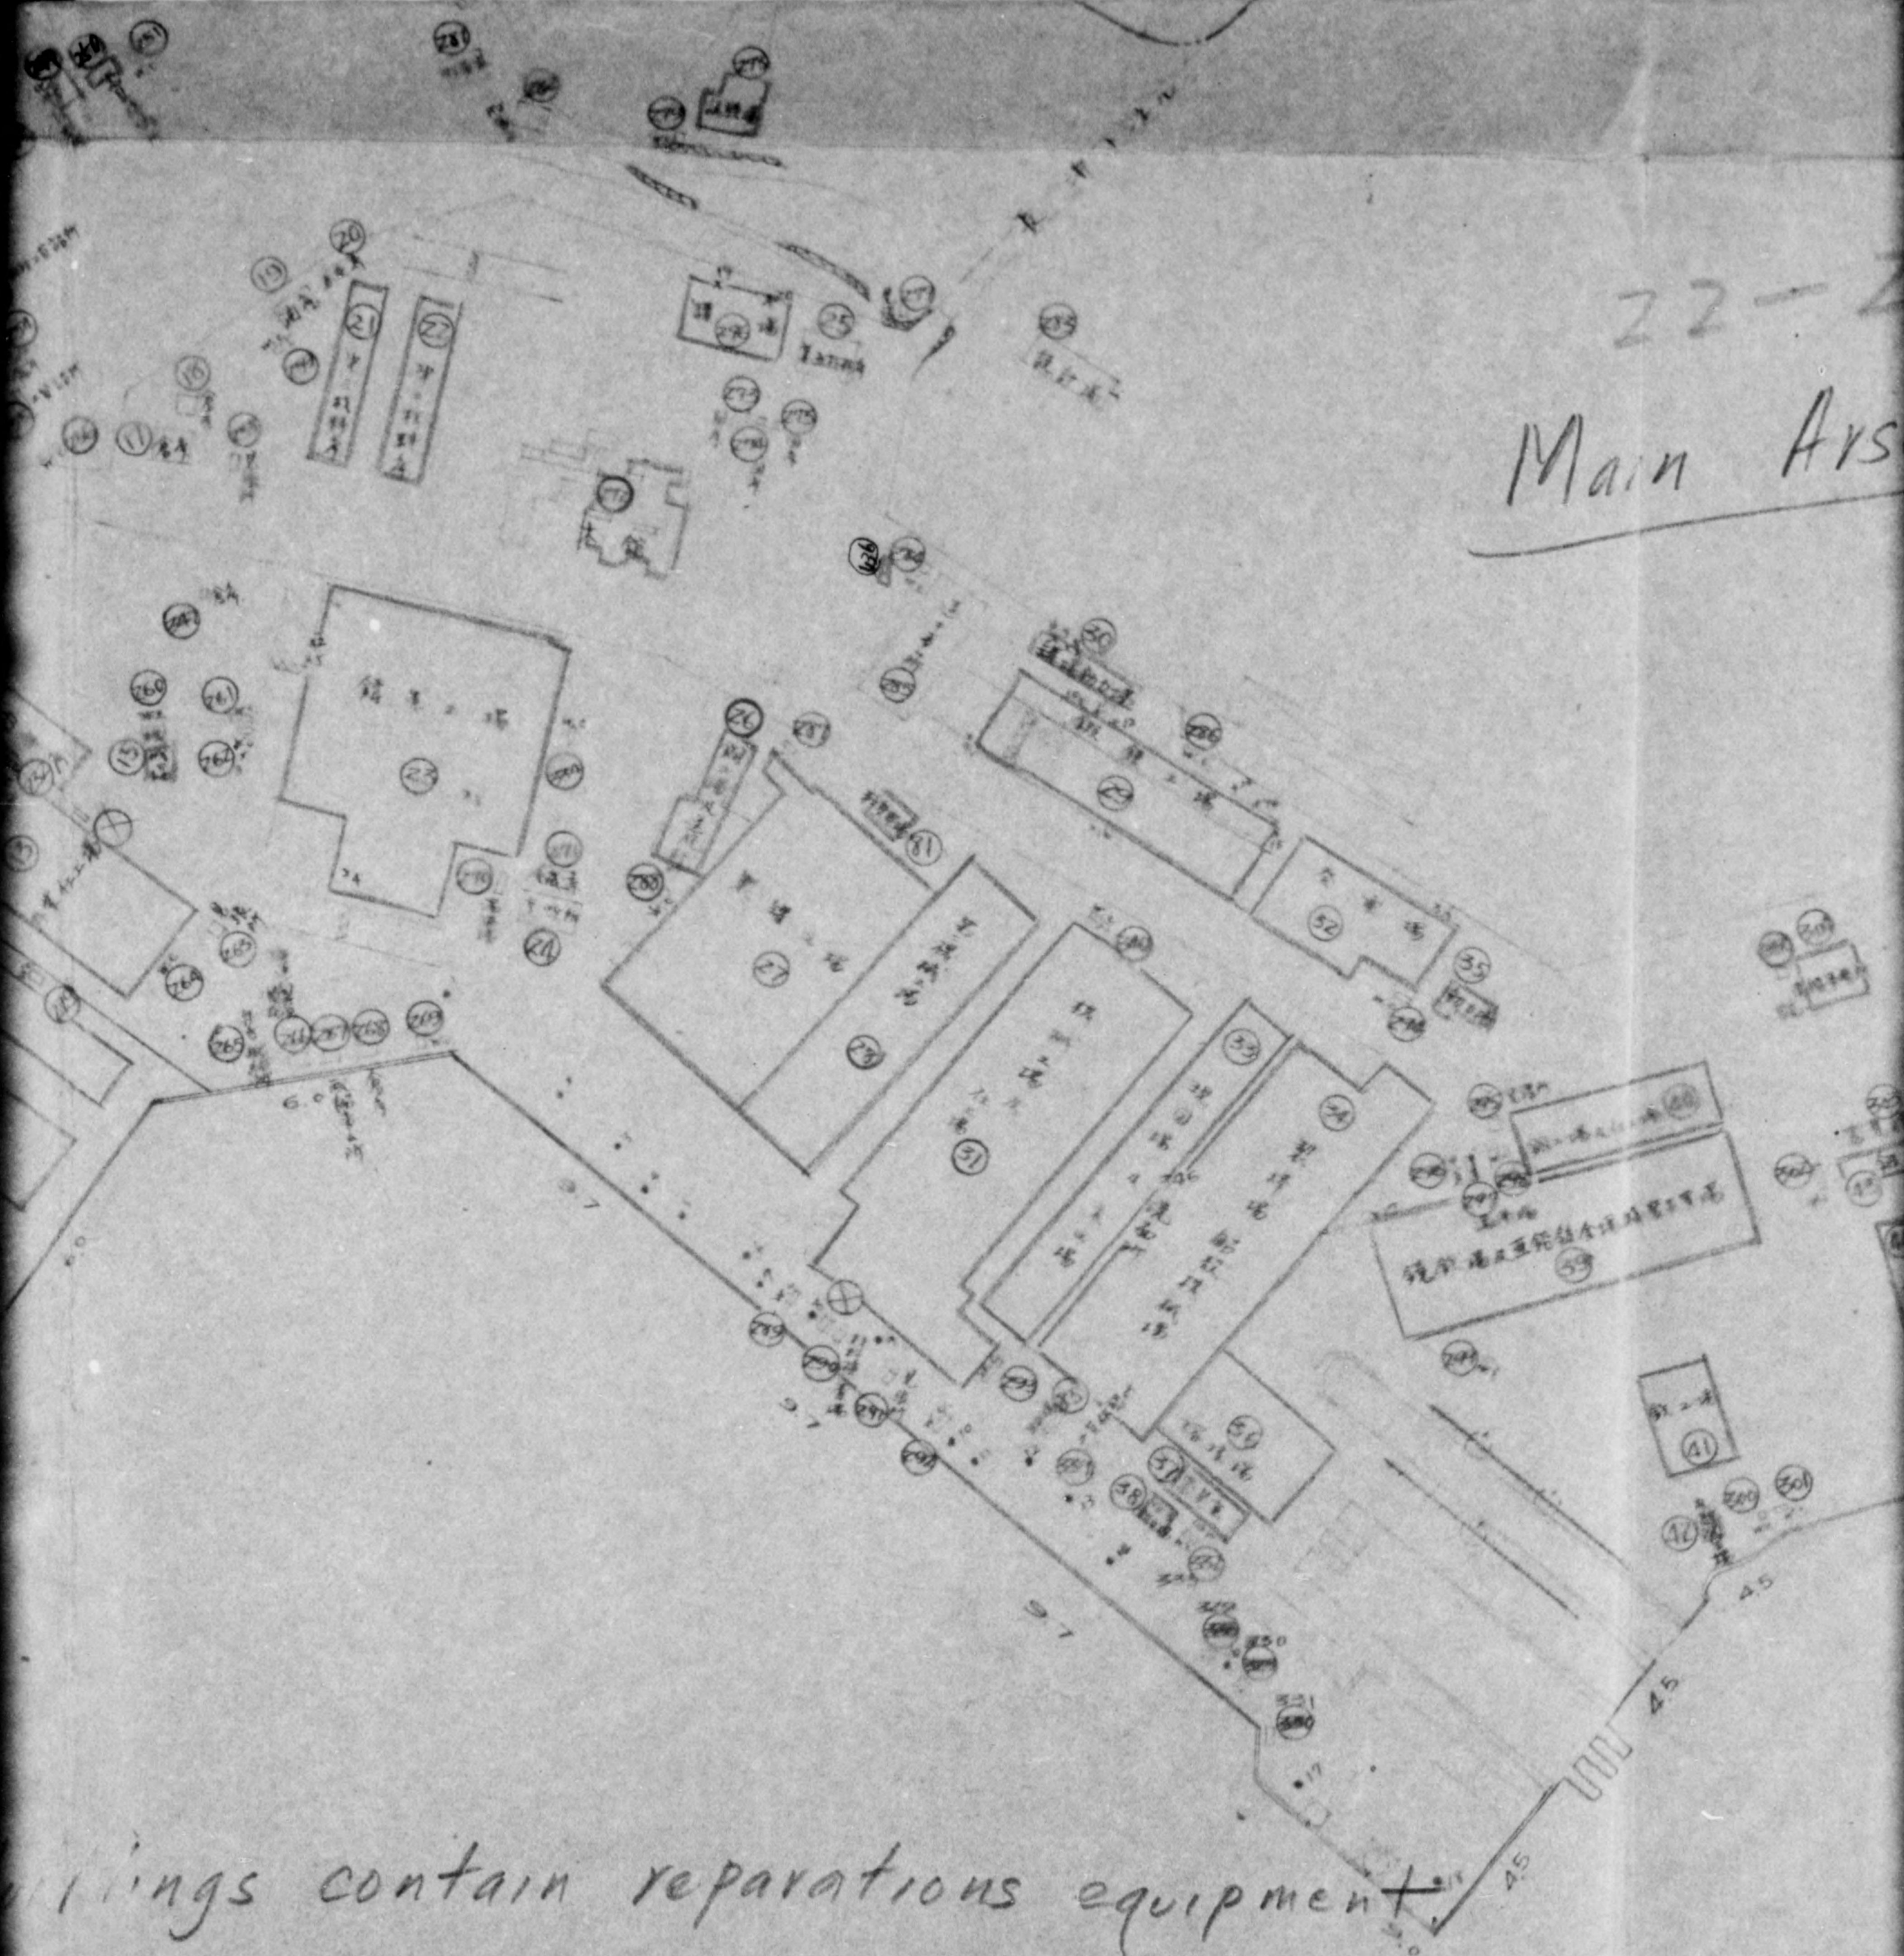

22-2

Main Ays


Billings contain reparations equipment

45



22-24

Main Arsenal

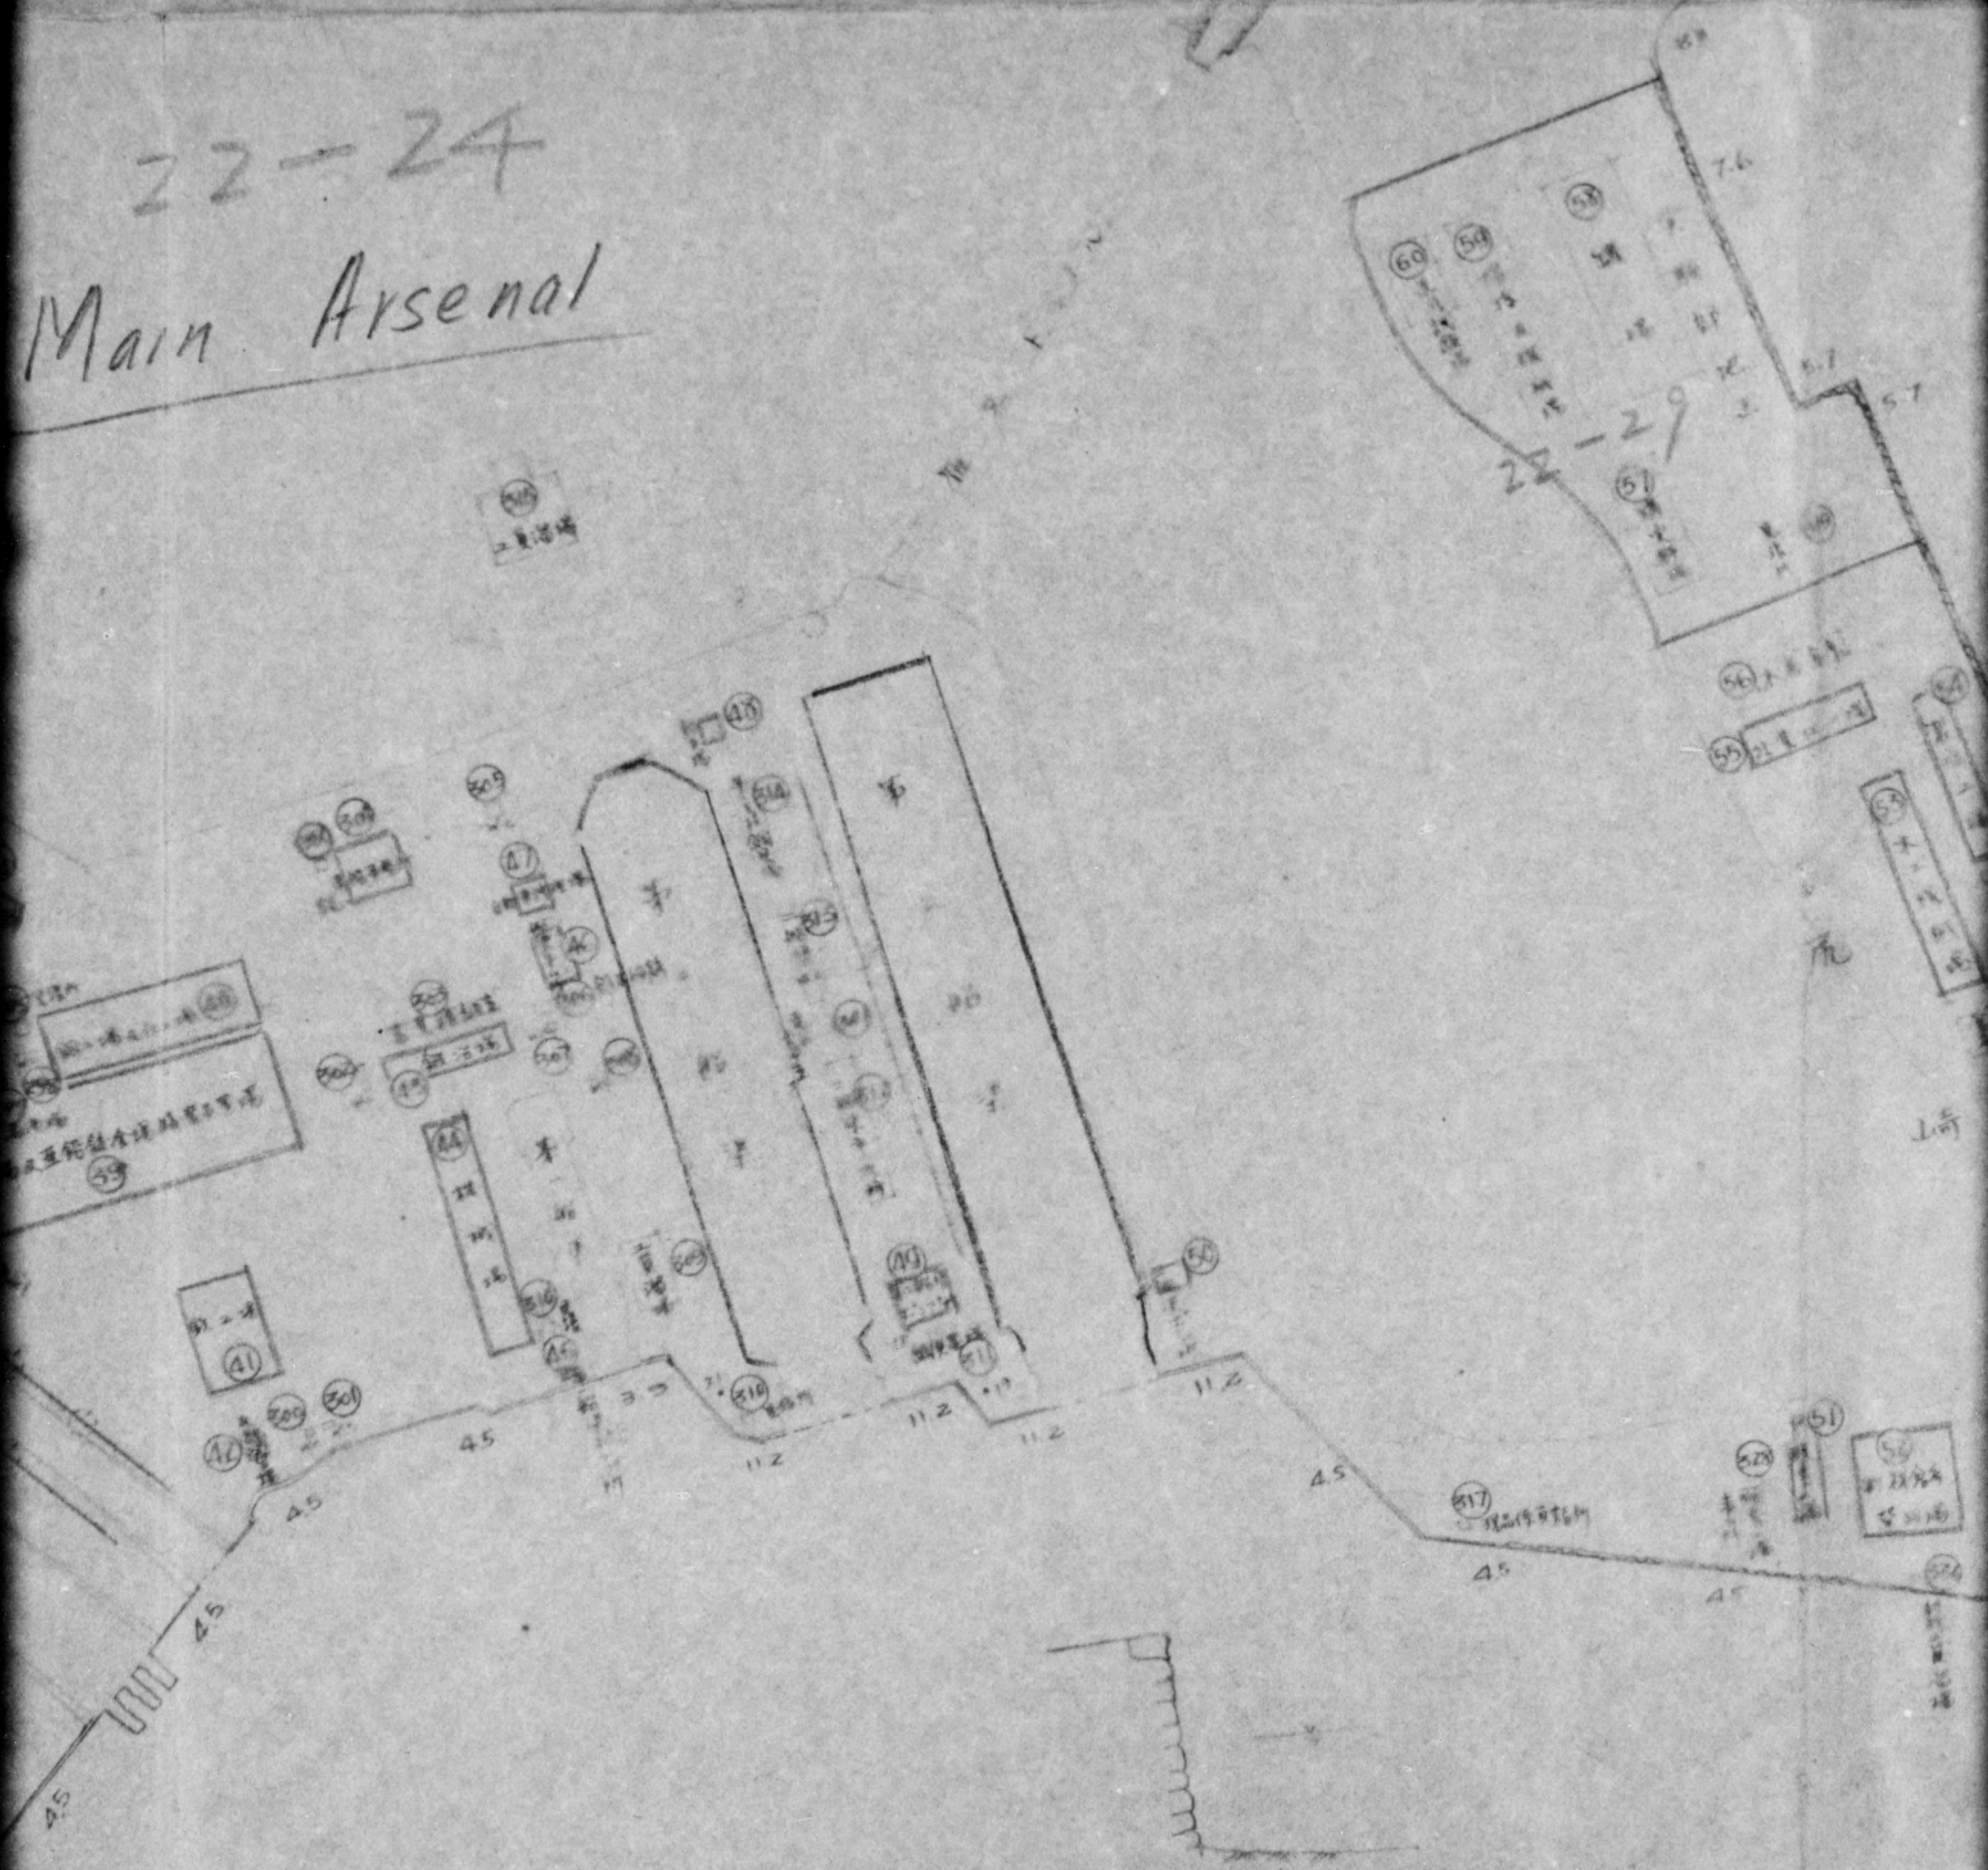








22-24

飲野産業株式會社 倉庫

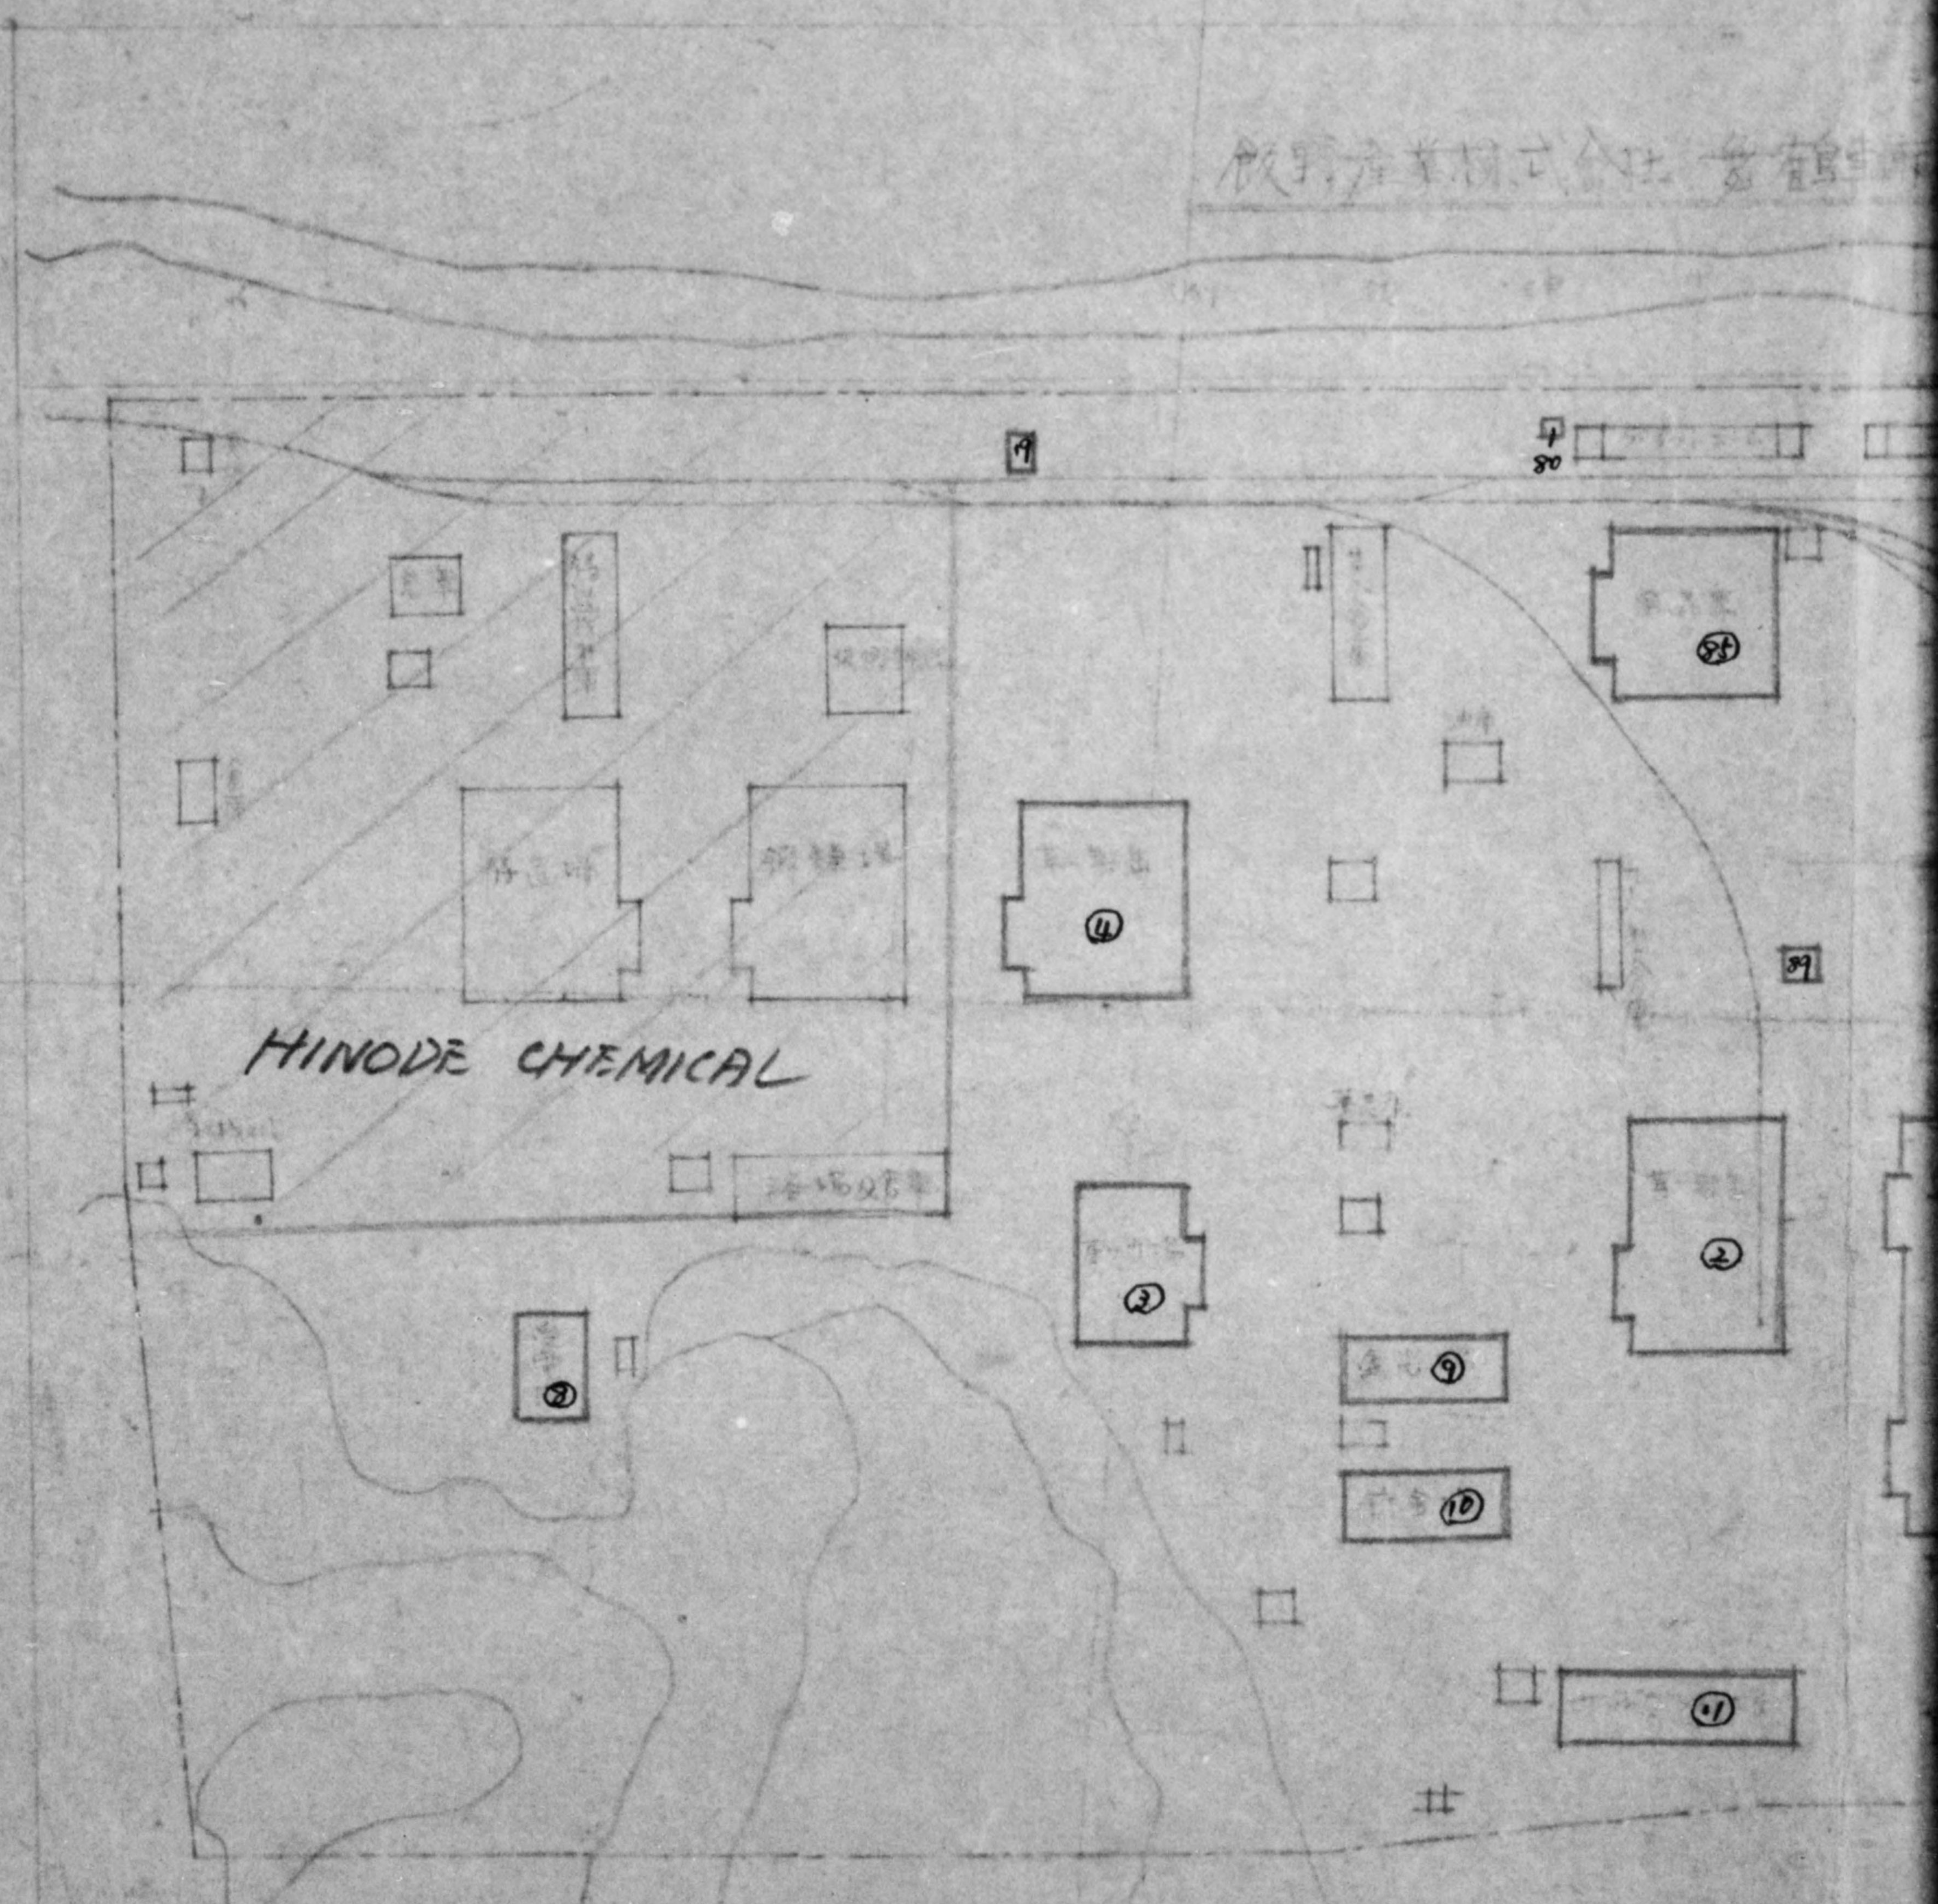

HINODE CHEMICAL


Red-outlined buildings contain reparations equ



775013

24 B

各館中製位所位置圖

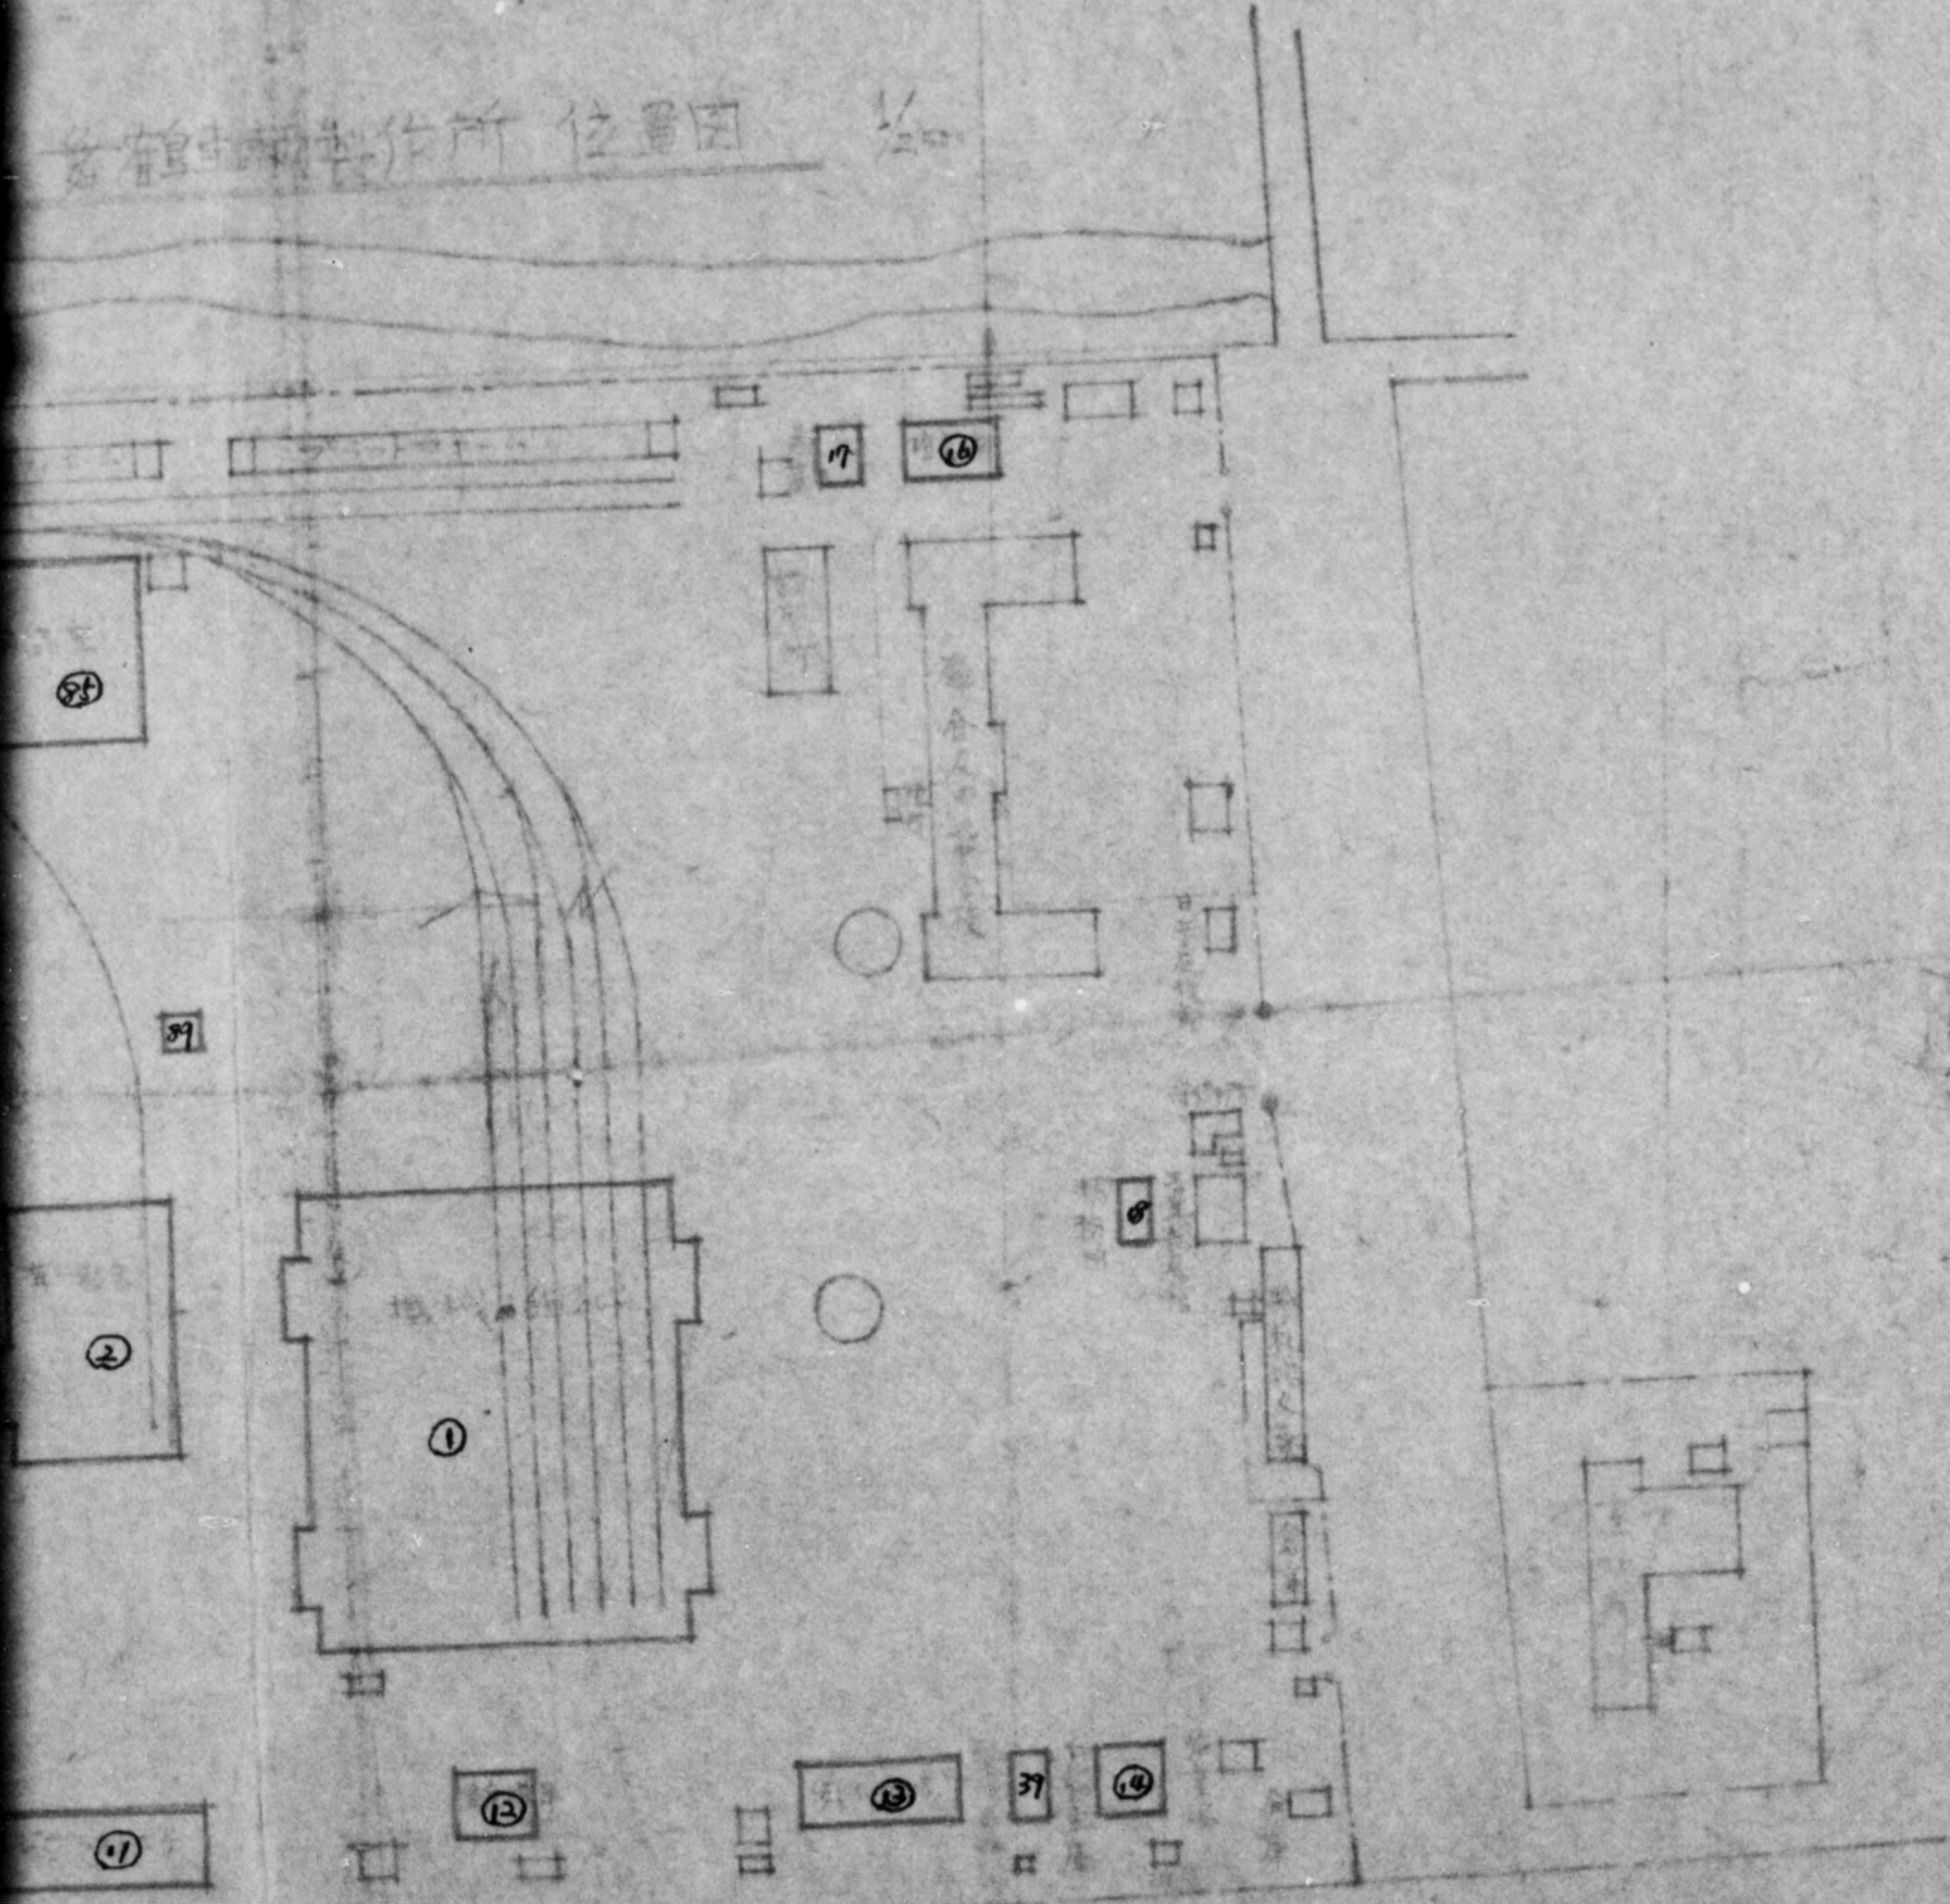

tions equipment












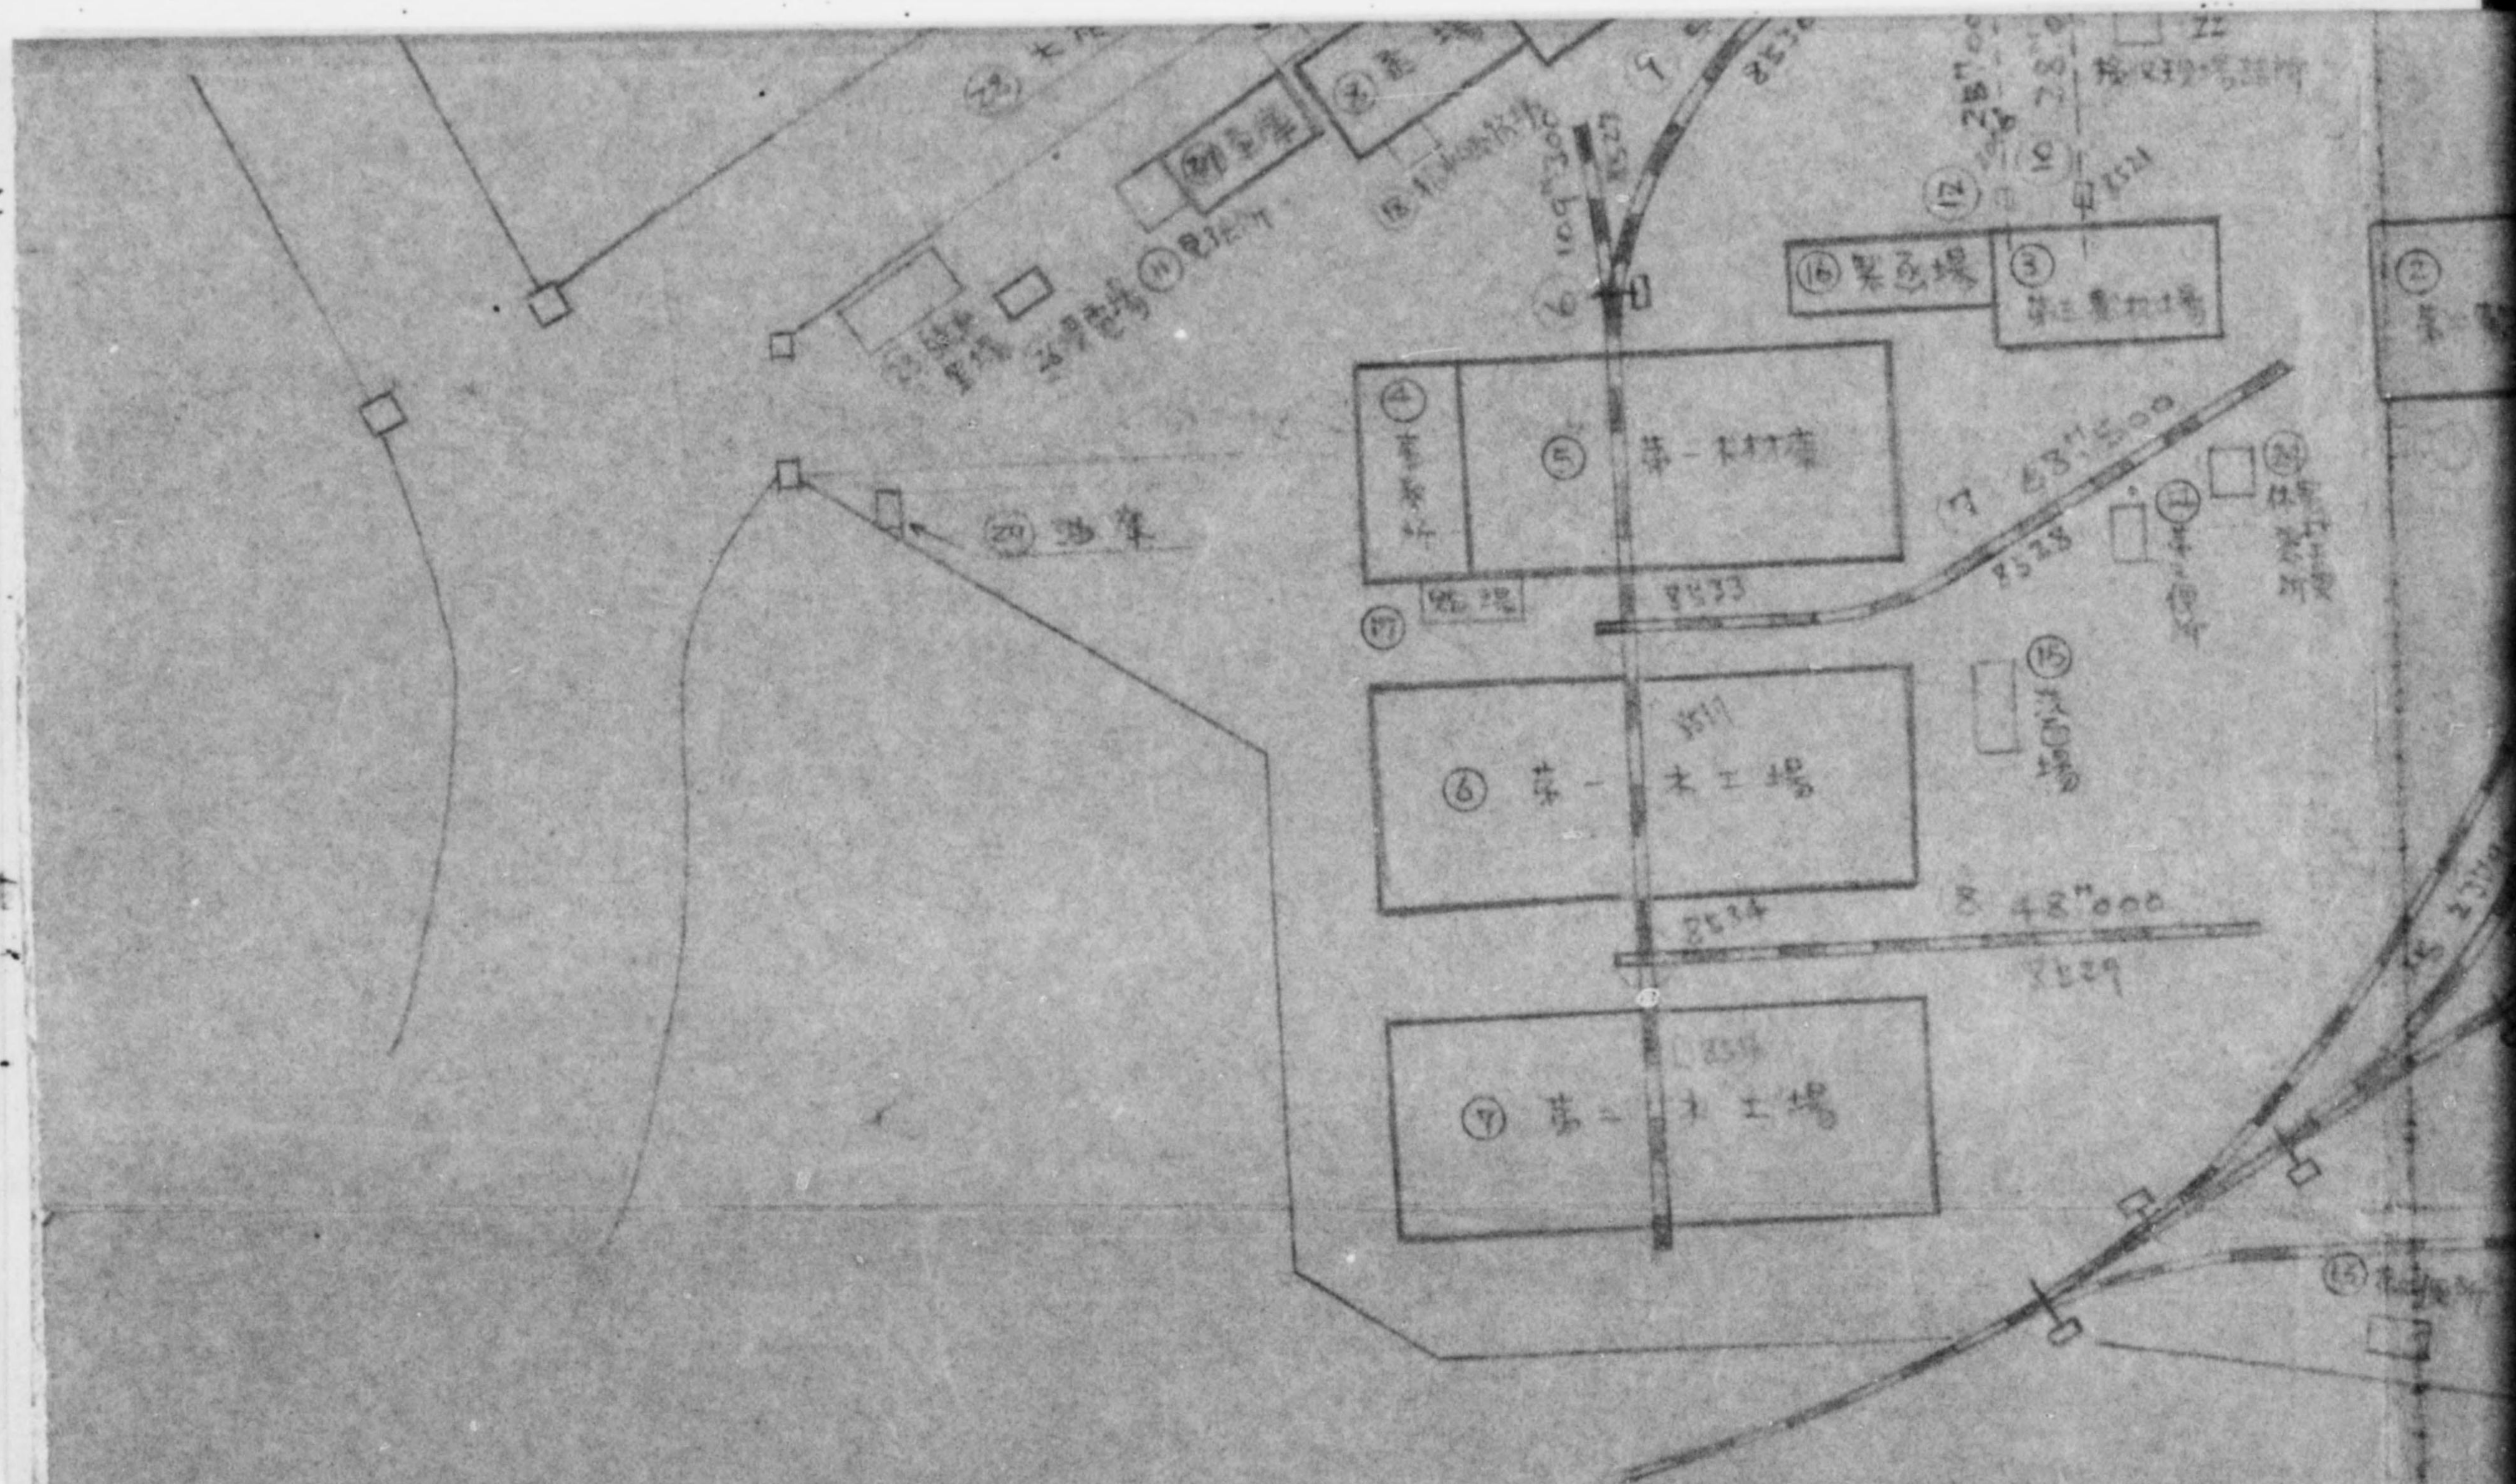

Red-out lined buildings contain reparations equipment



