愛知時計電機株式會社配置圖

縮尺千二百分ノ壱

凡例

○ 短延大型　四三発

◎ 短延大又ハ中型　一四発（一〇〇〇キロ程度）

△ 瞬発大又ハ中型　九発（五〇〇キロ以上）

二〇発（五〇〇キロ程度）

愛知鐘壁機株式會社舟方工場

凡例
愛知航空機株式會社舟方工場
○ 短延大型
◎ 短延大又ハ中型
計 四三発
一四発（一〇〇〇キロ程度）
九発（五〇〇キロ以上）
BOMB HUT LEGEND

(13)
(12)
(11)
(10)
(7)
(5)
(4)
(3)
(2)
(1)
(17)
(20)
(21)
(22)
(23)
(24)
(25)
(26)
(27)
(14)
(15)
(16)
(18)
(19)
(6)
(8)
(9)
1.
2.
3.
4.
5.
6.
7.
8.
9.
10.
11.
12.
13.
14.
15.
16.
17.
18.
19.
22.
23.
24.
25.
26.
27.
26'16'
S
Direction of Attack

BOMB PLOT LEGEND
4000 LC - NO CRATER
4000 LC - CRATER
2000 GP - NO CRATER
2000 GP - CRATER
1000 GP - NO CRATER
1000 GP - CRATER
S
26'6"

Bomb Plot

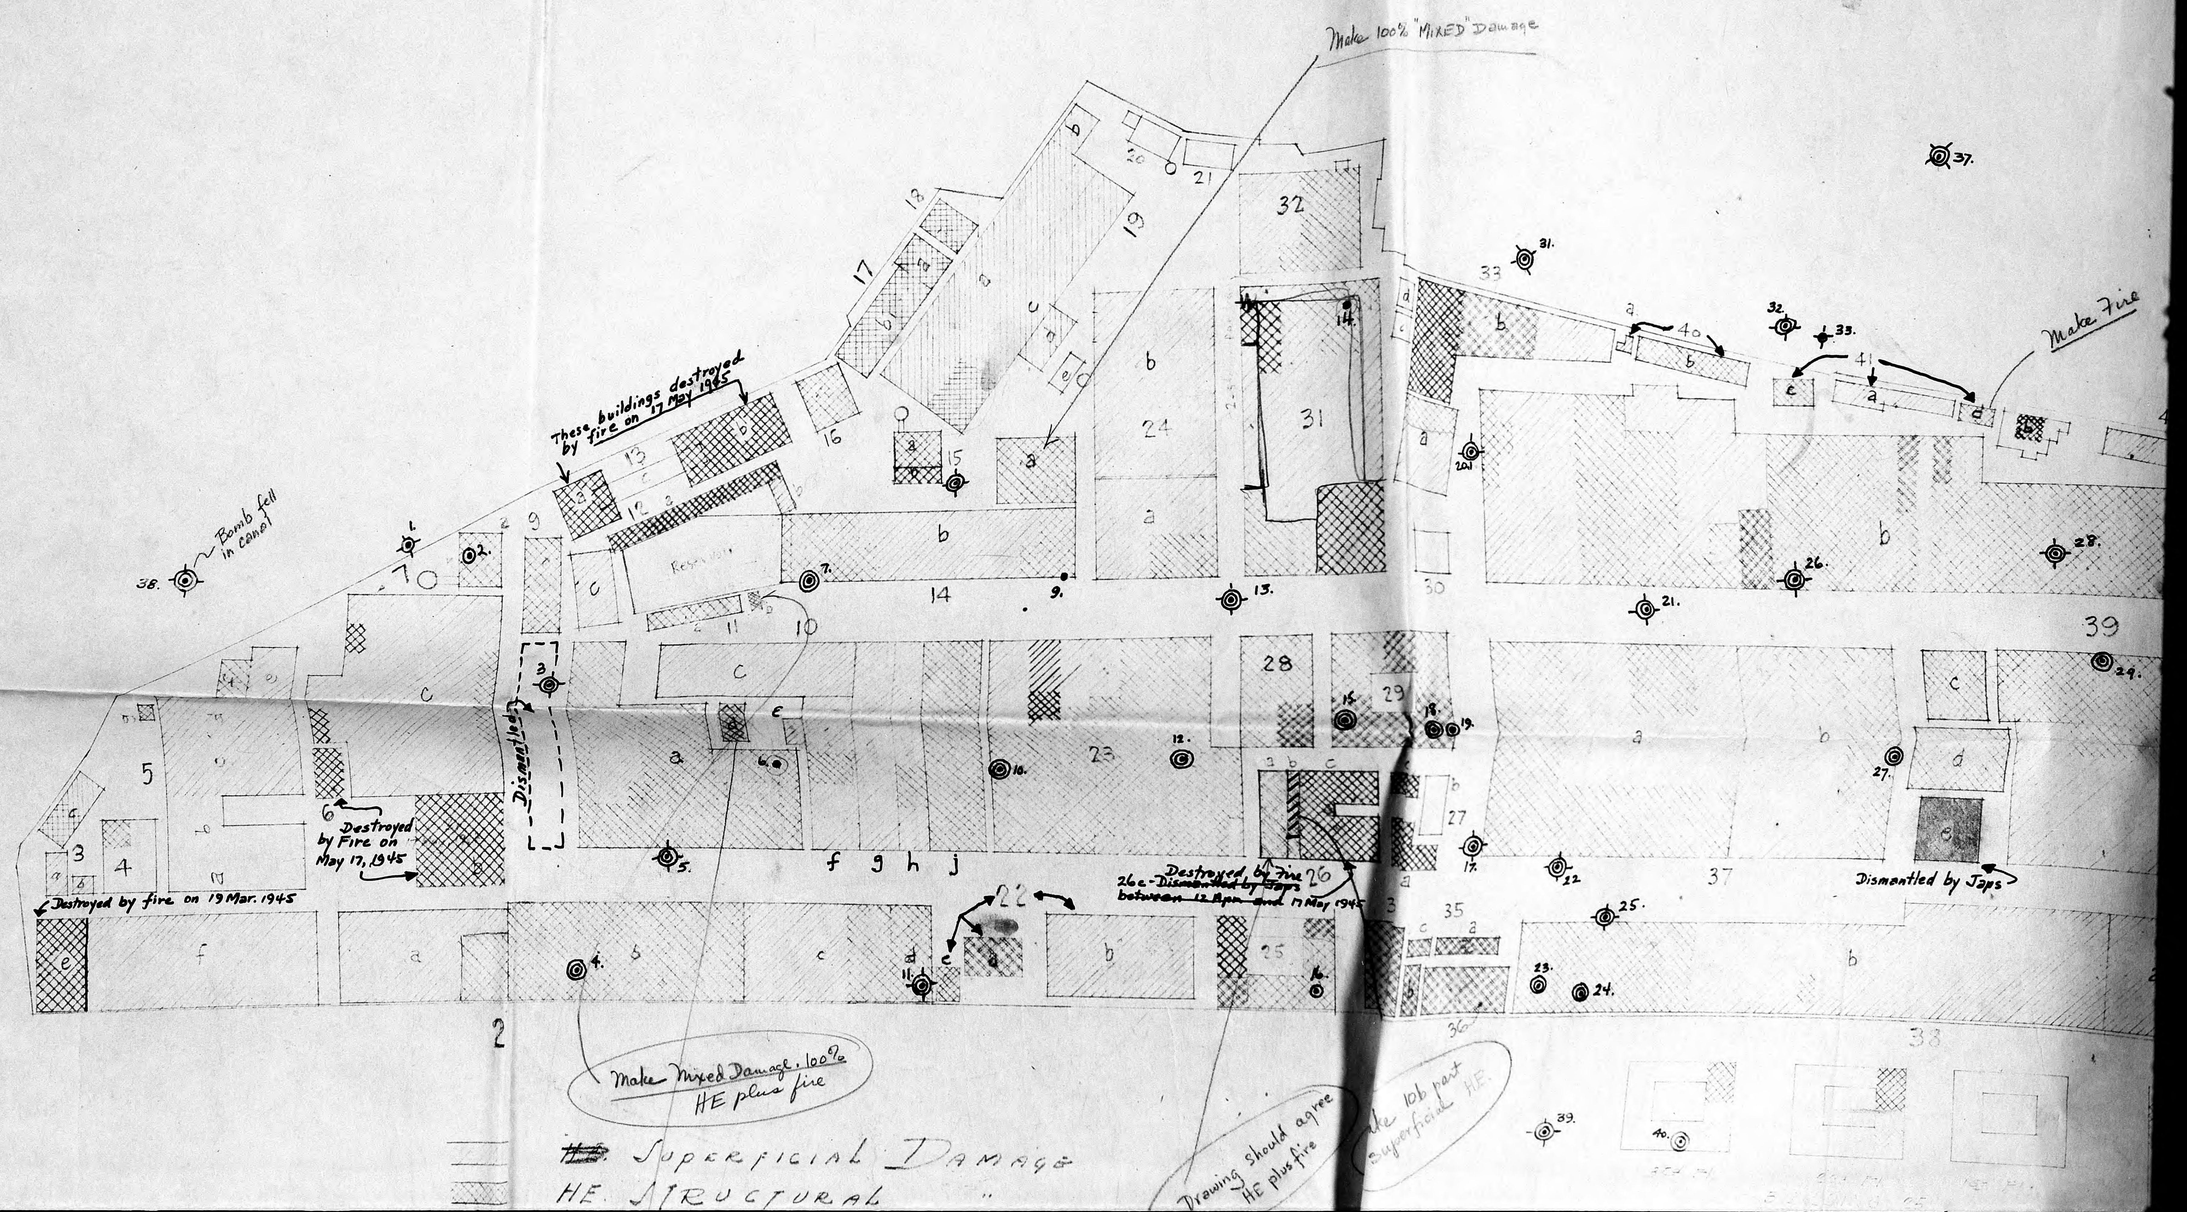
Make 100% "MIXED" Damage
These buildings destroyed by fire on 17 May 1945
Bomb fell in canal
Destroyed by Fire on May 17, 1945
Destroyed by fire on 19 Mar. 1945
Dismantled
Destroyed by Fire
26c - Dismantled by Japs between 12 Apr and 19 May 1945
Dismantled by Japs
Make Fire
Make Mixed Damage. 100% HE plus fire
SUPERFICIAL DAMAGE
HE STRUCTURAL "
Drawing should agree
HE plus fire
Make 100 part superficial HE

Bomb plot.

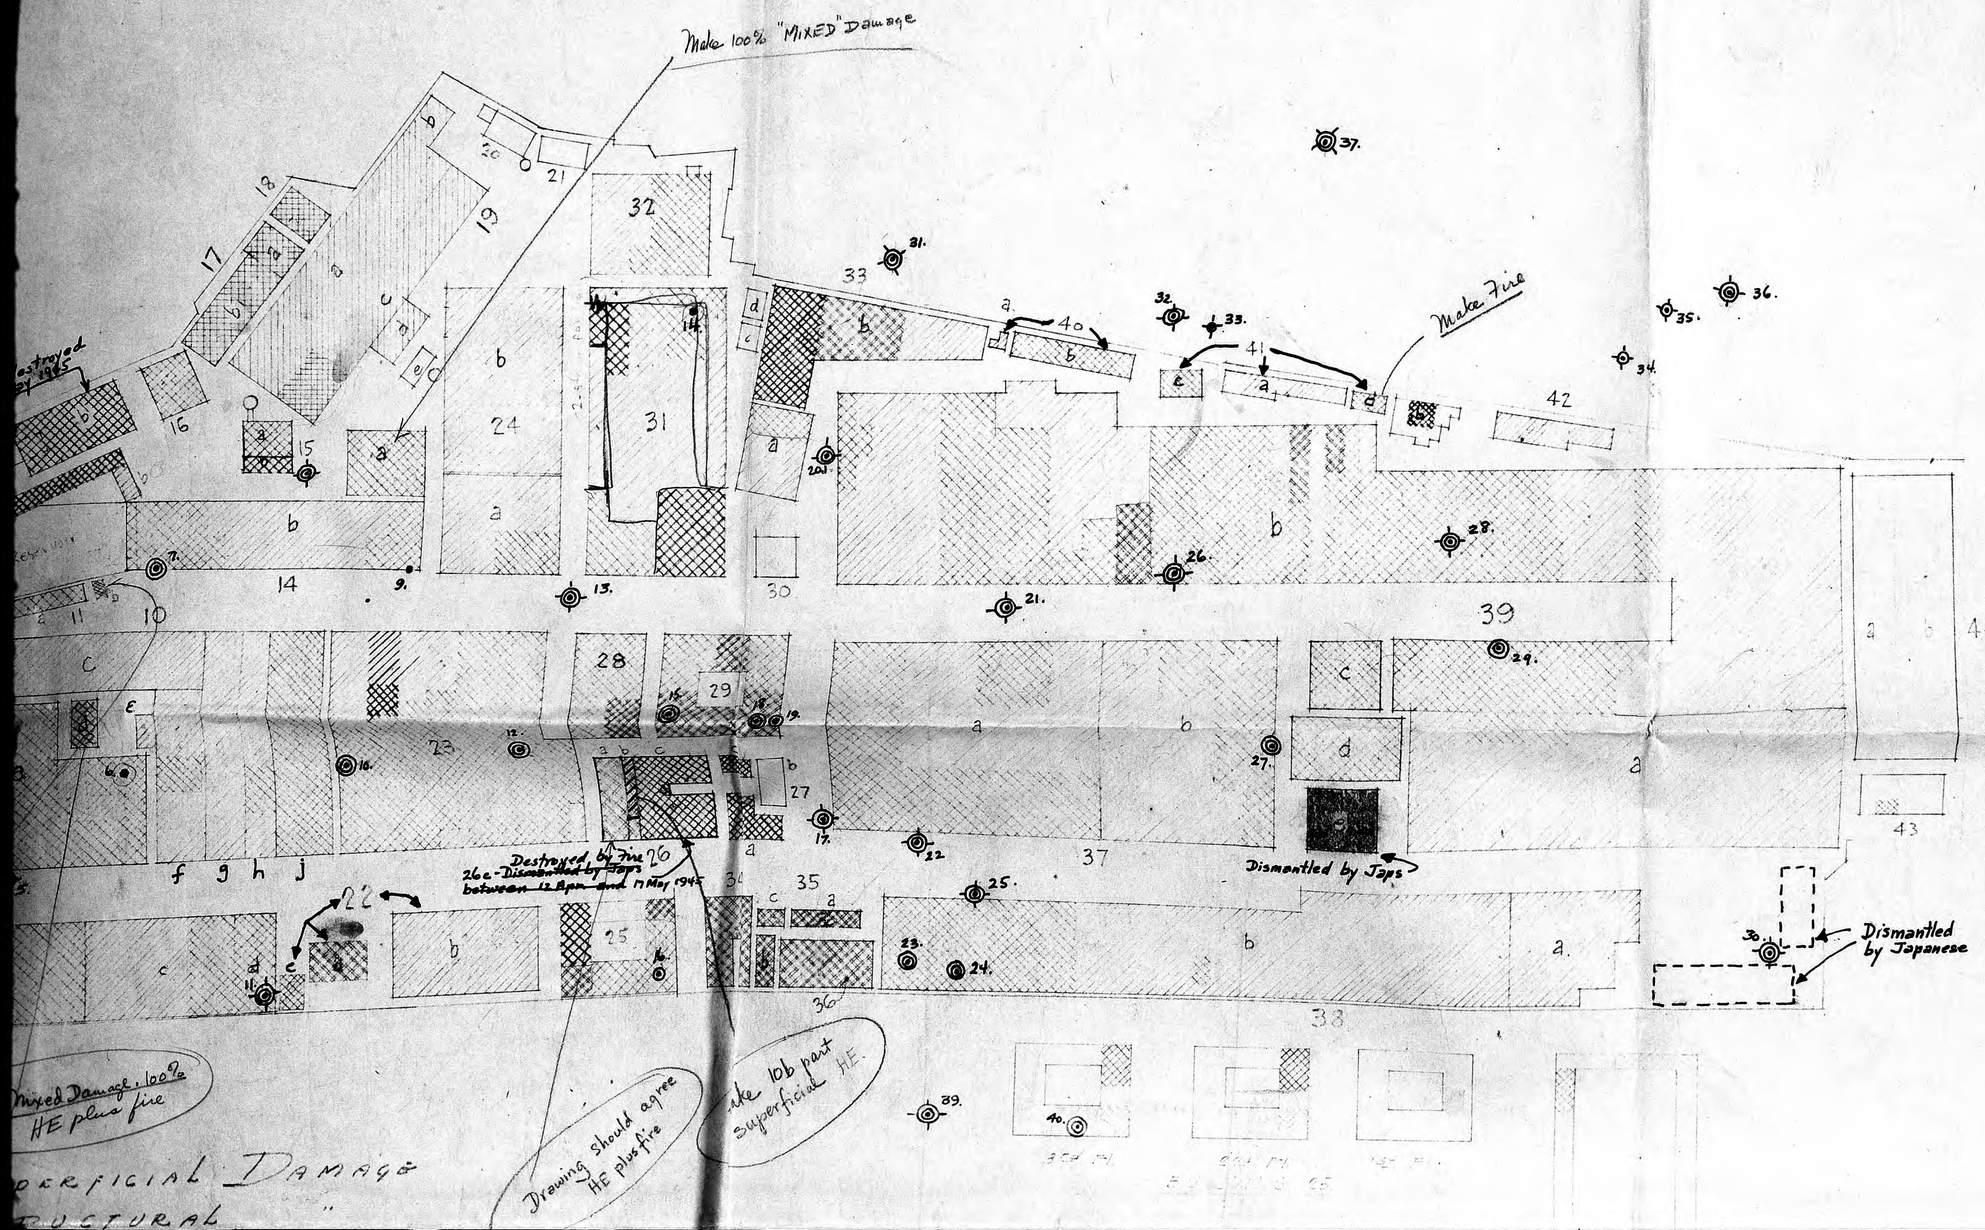
Make 100% "MIXED" Damage
Make Fire
Destroyed by 1945
Destroyed by Fire
26c - Dismantled by Japs between 12 Apr and 17 May 1945
Dismantled by Japs
Dismantled by Japanese
Mixed Damage, 100% HE plus fire
Drawing should agree HE plus fire
Make 10b part superficial HE.
SUPERFICIAL DAMAGE
STRUCTURAL "

4.6

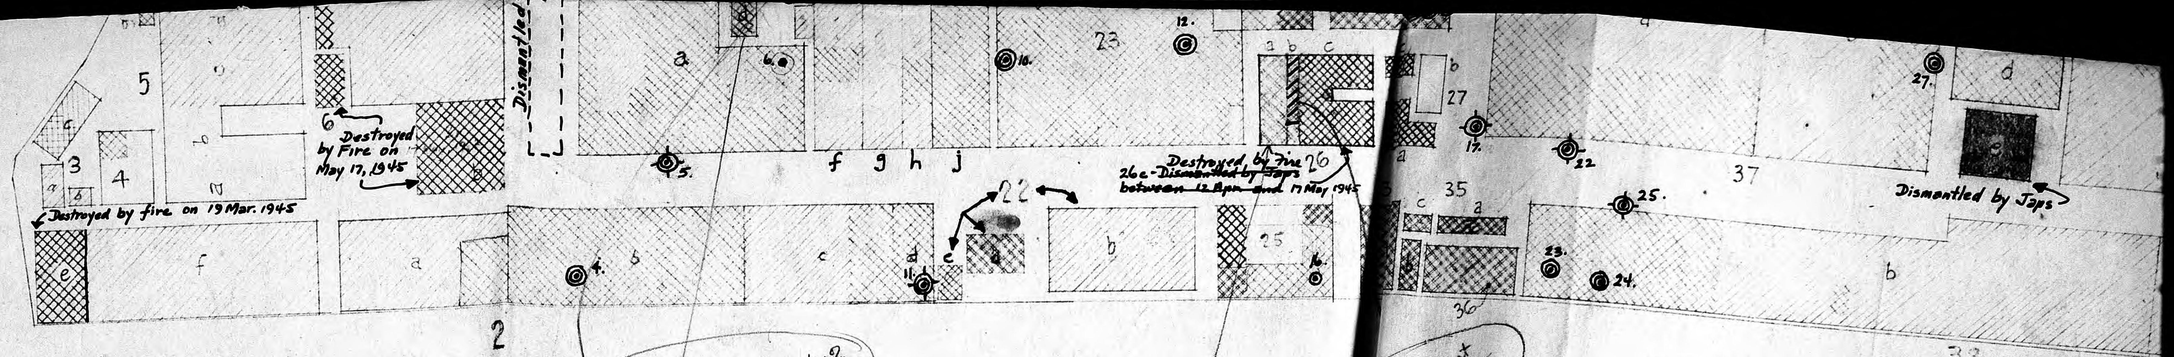

Make Mixed Damage. 100% HE plus fire

Drawing should agree HE plus fire

Make 10b part superficial HE.

~~HE~~ SUPERFICIAL DAMAGE
HE STRUCTURAL
~~FIRE Superficial~~
FIRE STRUCTURAL
HE PLUS FIRE

Make 10d - 100% Structural HE

Move Bldg 25 sketch to clear Room #40

Bomb Legend
- 1000-lb G
- 2000-lb G
- 4000-lb
Four points in crater.

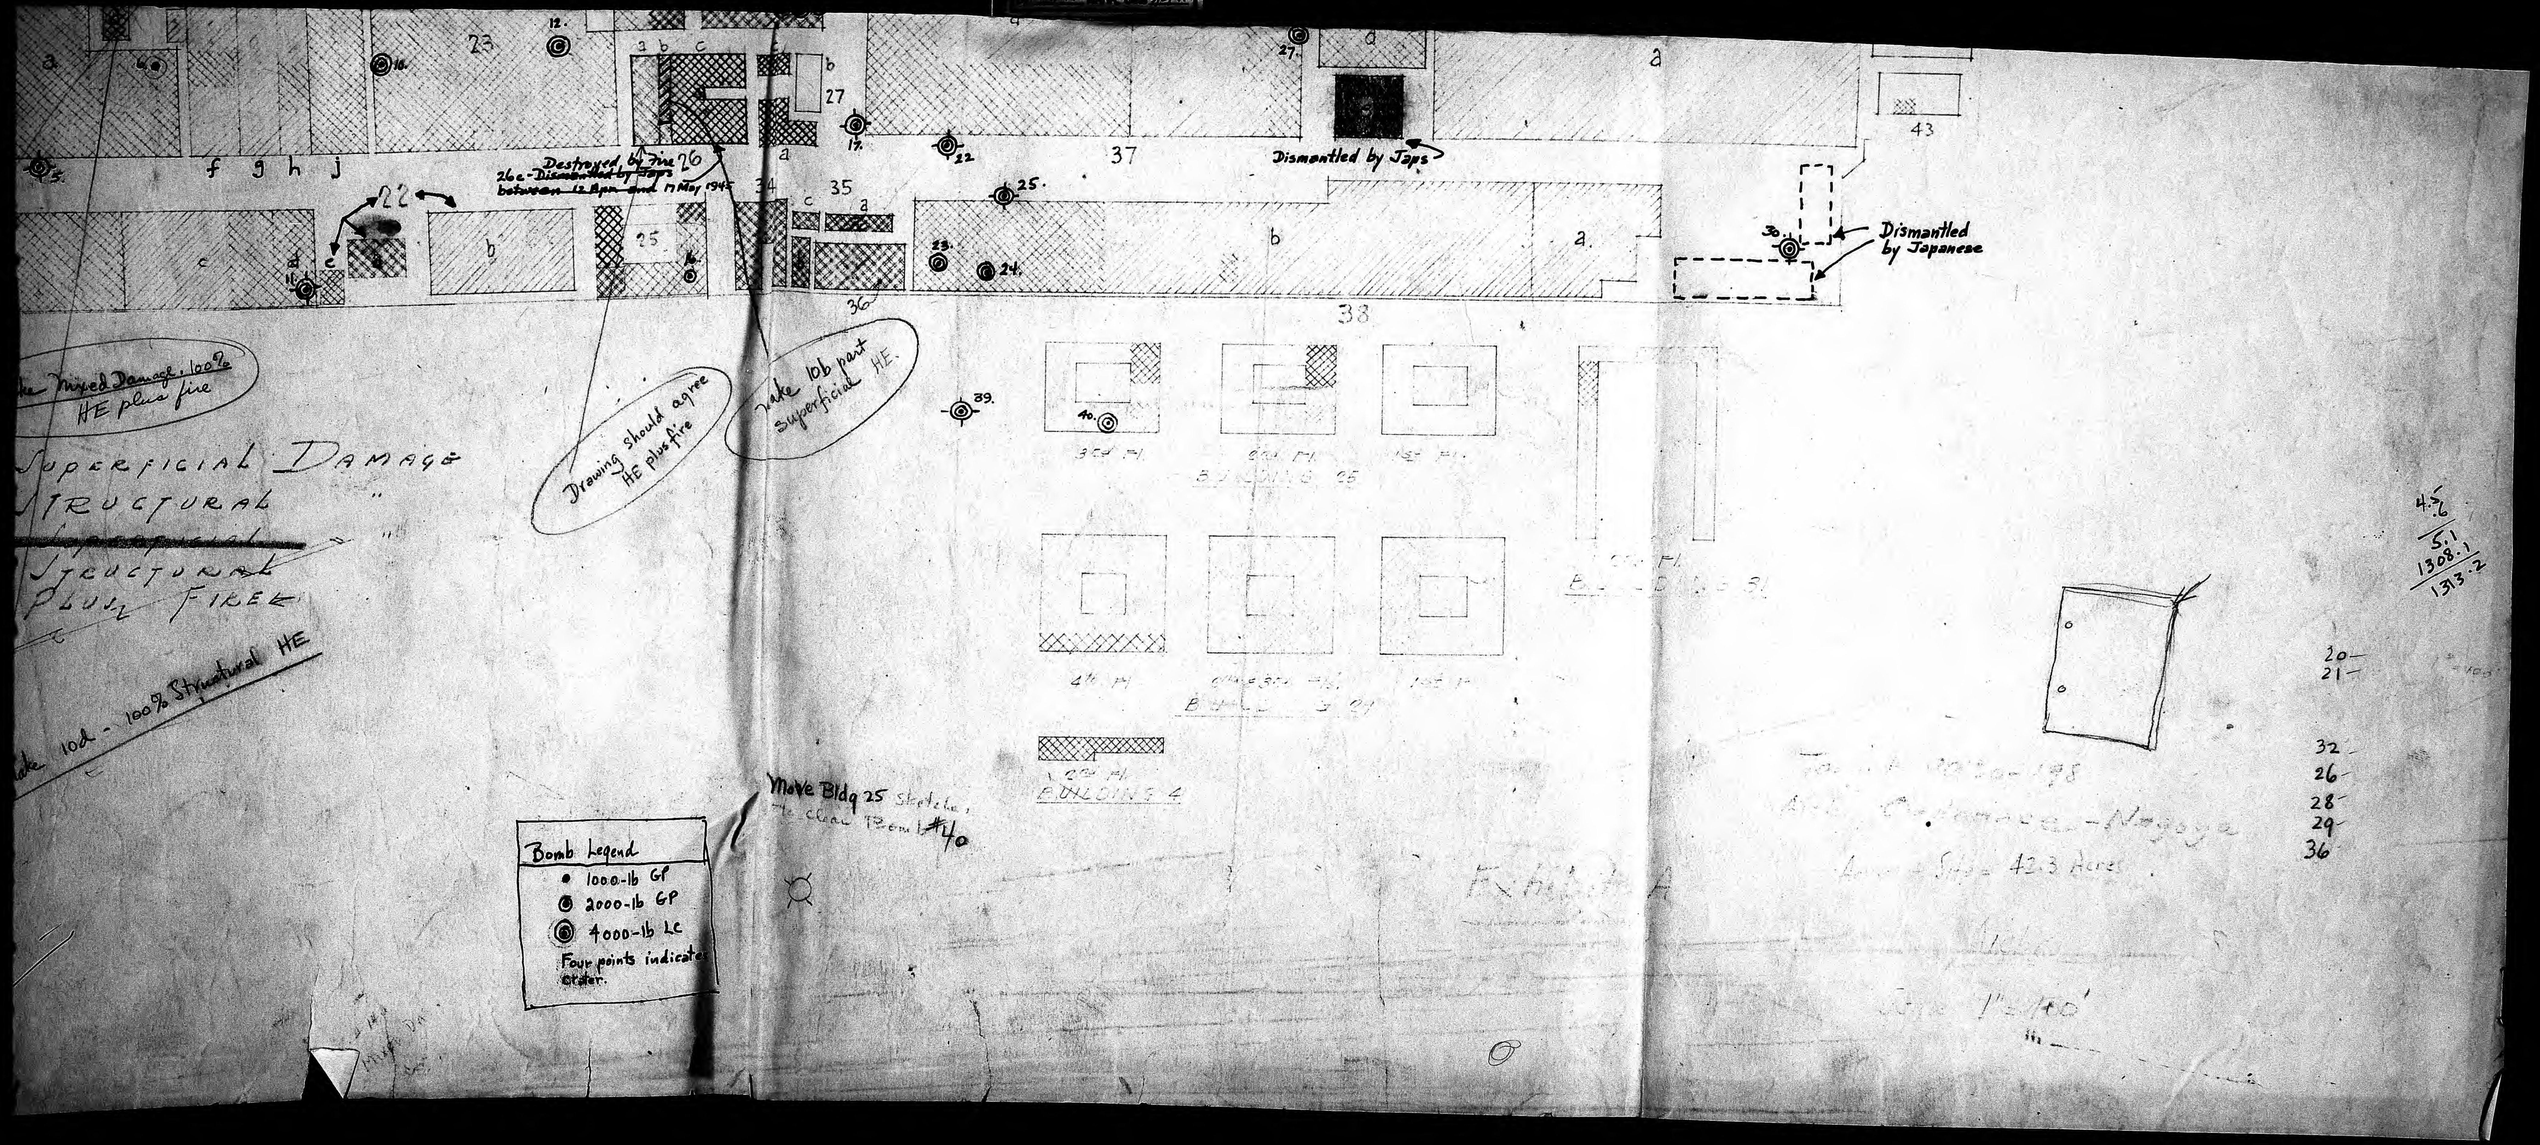
Destroyed by Fire
26a - Dismantled by Japs between 12 Apr and 17 May 1945
Dismantled by Japs
Dismantled by Japanese
Drawing should agree HE plus fire
Take 10b past superficial HE.
Superficial Damage
Structural
Structural Plus Fire
Take 10d - 100% Structural HE
Move Bldg 25
Bomb Legend
1000-lb GP
2000-lb GP
4000-lb LC
Four points indicate crater.

愛知時計電機株式會社配置図

縮尺 千二百分ノ壱

凡例

愛知航空機株式會社 舟方工場

計

○ 短延大型 四三発

◎ 短延大又ハ中型 一四発（一〇〇〇キロ程度）

△ 瞬発大又ハ中型 九発（五〇〇キロ以上）

二〇発（五〇〇キロ程度）

By HR-M NARA, Date 3/5/91

(14)
(13)
(12)
(10)
(9)
(7)
(6)
(5)
(4)
(2)
(1)
(15)
(17)
(19)
(20)
(22)
(23)
(24)
(73)
(70)
(69)
(68)
(67)
(66)
(65)
(74)
S

S

WAR DEPARTMENT
OFFICE OF THE ASSISTANT SECRETARY
WASHINGTON, D. C.

OFFICIAL BUSINESS

PENALTY FOR PRIVATE USE TO AVOID
PAYMENT OF POSTAGE, $300

Original Bomb Plot

Aiche — 90:20-198

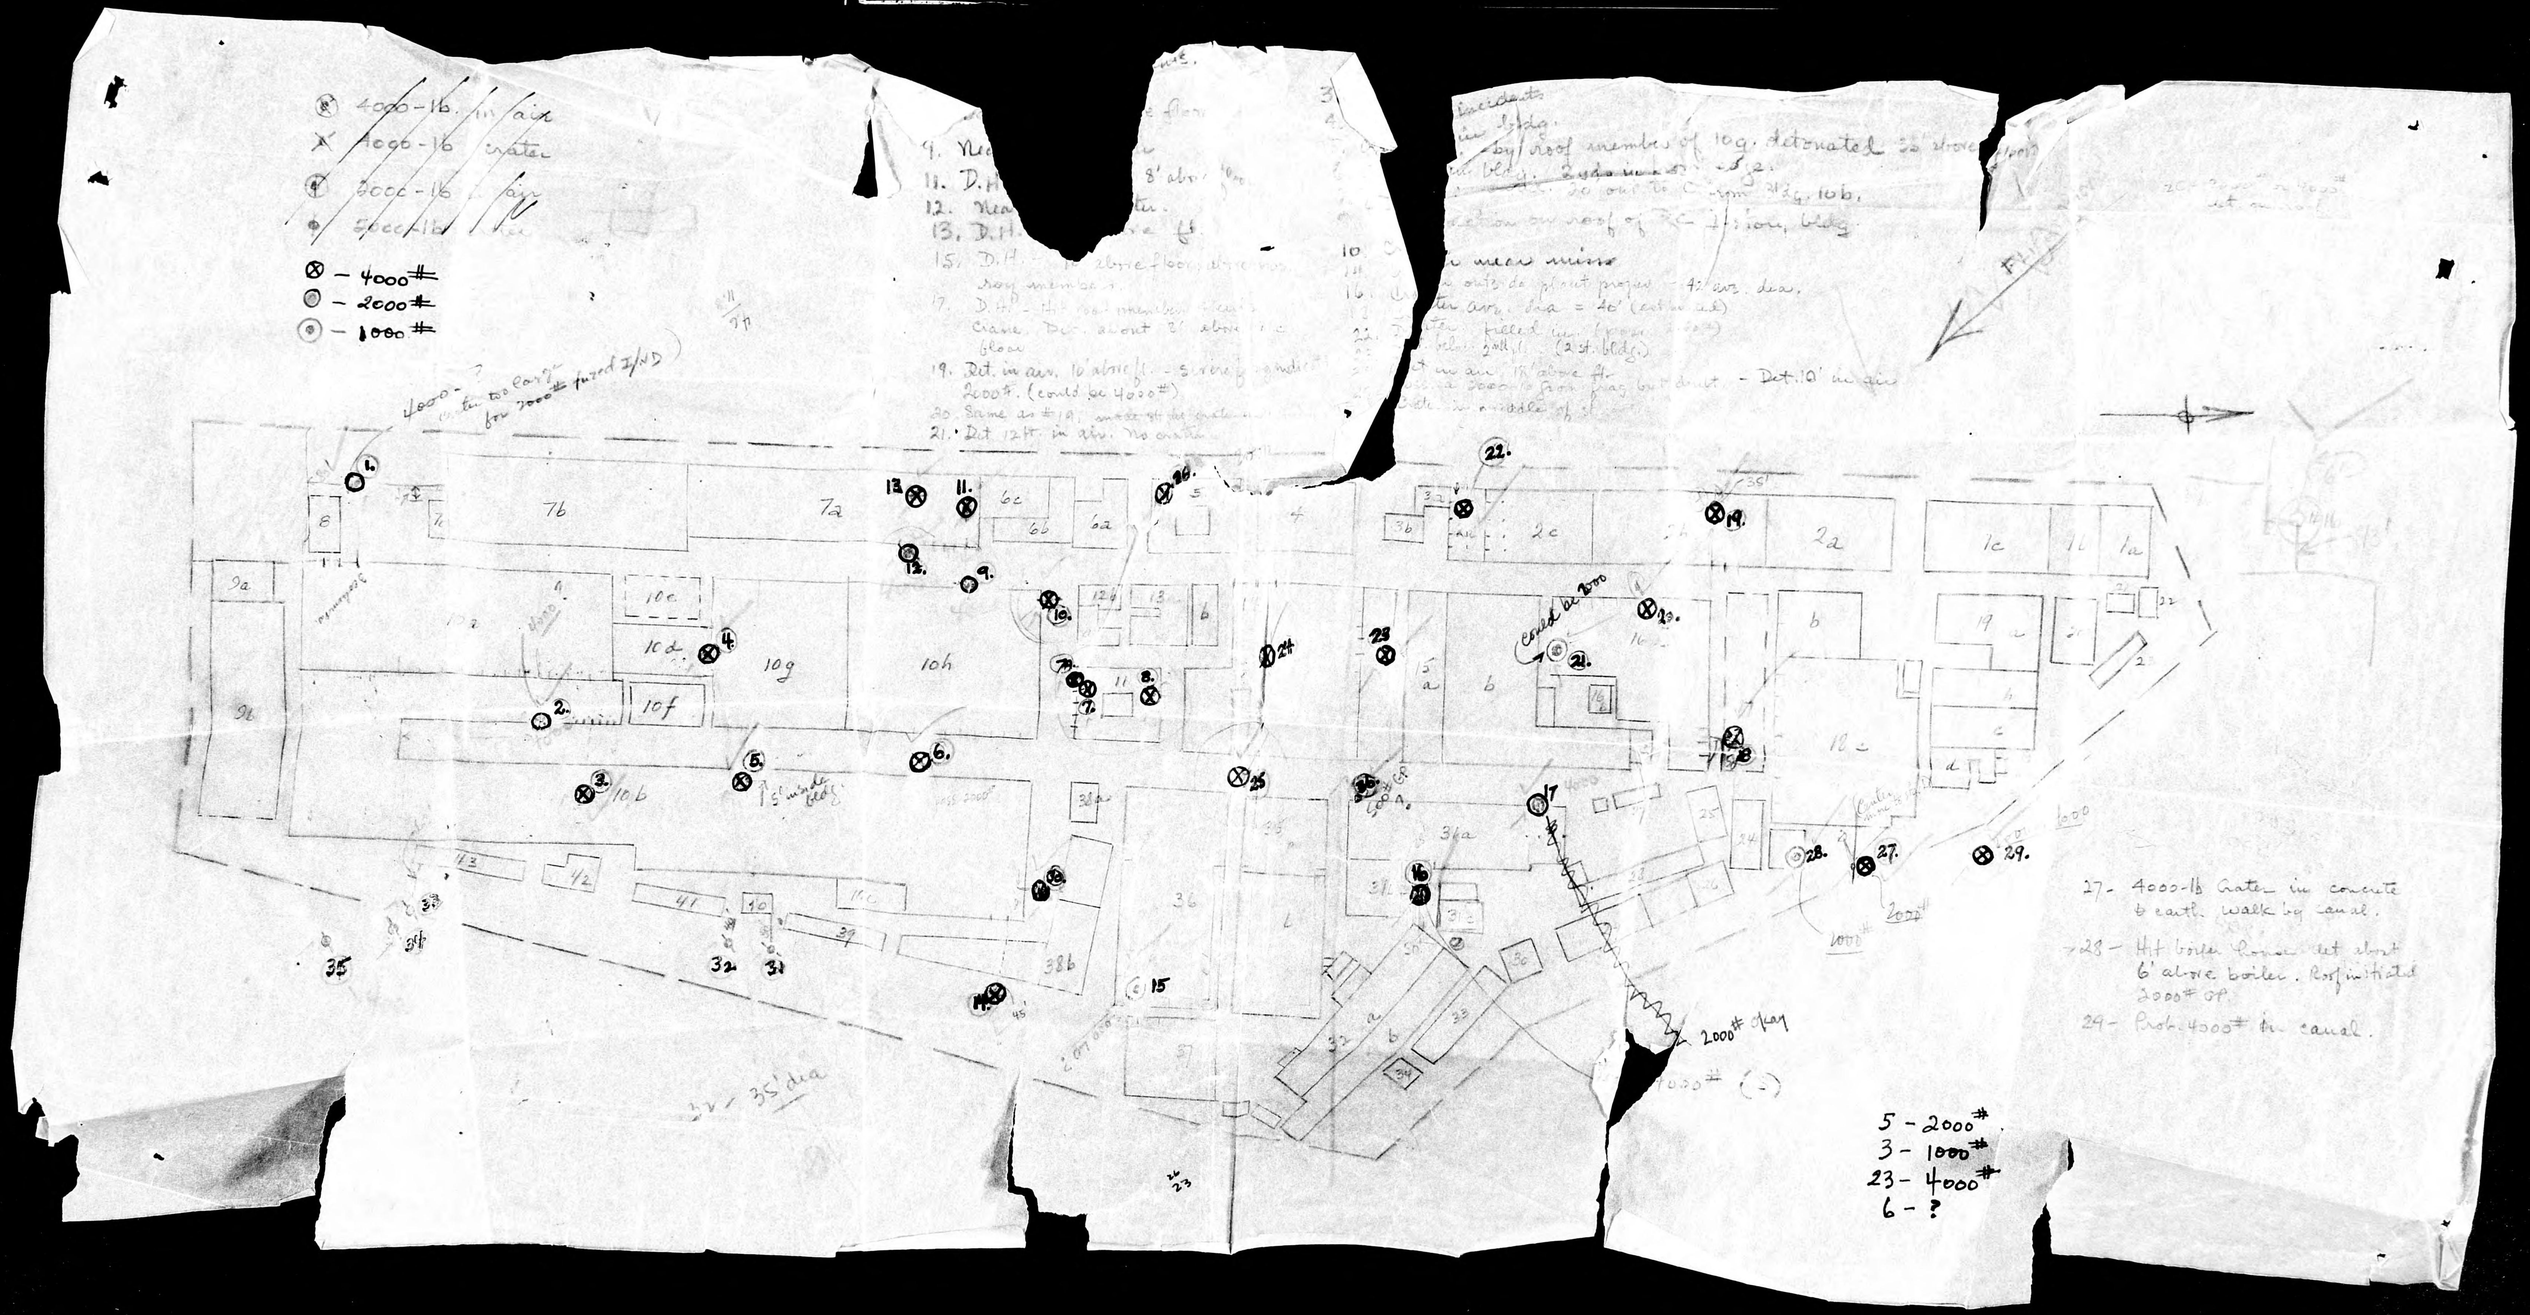
4000-lb. in air
4000-lb crater
2000-lb air
5000-lb
⊗ - 4000#
⊗ - 2000#
⊗ - 1000#
9. Near
11. D.H.
12. Near
13. D.H.
15. D.H. 8' above floor, above roof members
17. D.H. - Hit roof members, near crane. Det. about 2' above floor
19. Det. in air, 10' above floor - 5 were given 2000#. (could be 4000#)
20. Same as #19, [illegible]
21. Det 12ft. in air. No crater
Incidents
in bldg.
by roof members of 10g. detonated 25 above floor
in bldg. 2000 [illegible]
20 out to C-yard 2½, 10b.
[illegible] on roof of [illegible] floor, bldg.
mean mine
outside plant proper - 4' avg. dia.
crater avg. dia = 40' (actual size)
crater filled in [illegible]
below [illegible] (2 st. bldg.)
in air 10' above flr.
2000 to from frag but dent - Det. 10' in air
in middle of
could be 2000
4000 - ? crater too large for 2000# fused 3/ND
Fire
2000# dump
2000# (-)
35' dia
27 - 4000-lb crater in concrete & earth walk by canal.
28 - Hit boiler house, det about 6' above boiler. Roof initiated 2000# OP.
29 - Prob. 4000# in canal.
5 - 2000#
3 - 1000#
23 - 4000#
6 - ?