BRITISH VENTURE
MIDSHIP SECTION
S.S. No. 847

SCALE ½" = 1 FOOT

LLOYDS NUMERALS		
1ST LONGITUDINAL Nº	L × D = 383.33 × 27.5	= 10541.57
2ND LONGITUDINAL Nº	L × (B + D) = 383.33 × 77.5	= 29708.07
1ST D TO UPPER DECK	383.33 × 27.5	= 3.93
	d = 27.5 − (10.0 + 3.0)	= 14.50

383.4 OVR L.W.L.

DIMENSIONS . 38440 B.P. × 50.0 MLD. × 27.0 MLD. TO UPPER DECK

TO LLOYDS GLASS 100 A1 CARRYING PETROLEUM IN BULK

LONGITUDINAL FRAMING

THE SCANTLINGS AND DETAILS OF CONSTRUCTION NOTED HEREON ARE SUBMITTED ON THE UNDERSTANDING THAT THEY ARE THE MINIMUM WHICH WILL BE ACCEPTED FOR CLASS. ERRORS AND OMISSIONS EXCEPTED.

BUB ANGLES APPROVED TO 1924 BRITISH STANDARD

STEM	9 × 27
RUDDER POST	9 × 7½
STERN POST	0 × 7½

EQUIPMENT NUMBER		
SECOND LONGITUDINAL NUMBER L × (B + D)		= 29708.07
POOP	31.3 × 8.0 × ¾	= 347.80
BRIDGE	30.0 × 8.0 × ¾	= 180.00
FORECASTLE	50.0 × 8.0 × ¾	= 334.00
HOUSE ON UPPER DECK	30.0 × 8.0 × 1	= 120.00
CHART & WHEL HOUSE	5.0 × 7.5 × 1	= 18.75
BOOM HOUSES & CARGO	80.0 × 8.0 × 1	= 550.00
	EQUIPMENT NO	= 31330.12

EQUIPMENT

2 BOWER ANCHORS 20 C.WT. EACH STOCKLESS.
1 SHORE ANCHOR 4.75 CWTS STOCKLESS.
1 STREAM ANCHOR 3 CWTS EX. STOCK.
270 FATHOMS 2⅛ STUD LINK CHAIN CABLE 508 ½ CWTS.
90 FATHOMS 1¾ STUD LINK CHAIN CABLE 41 STEEL WIRE
120 FATHOMS 4½ STEEL WIRE
2 HAWSERS 90 FATHOMS EACH 7" HEMPLED ROPE MANILA
2 HAWSERS 90 FATHOMS EACH 7"

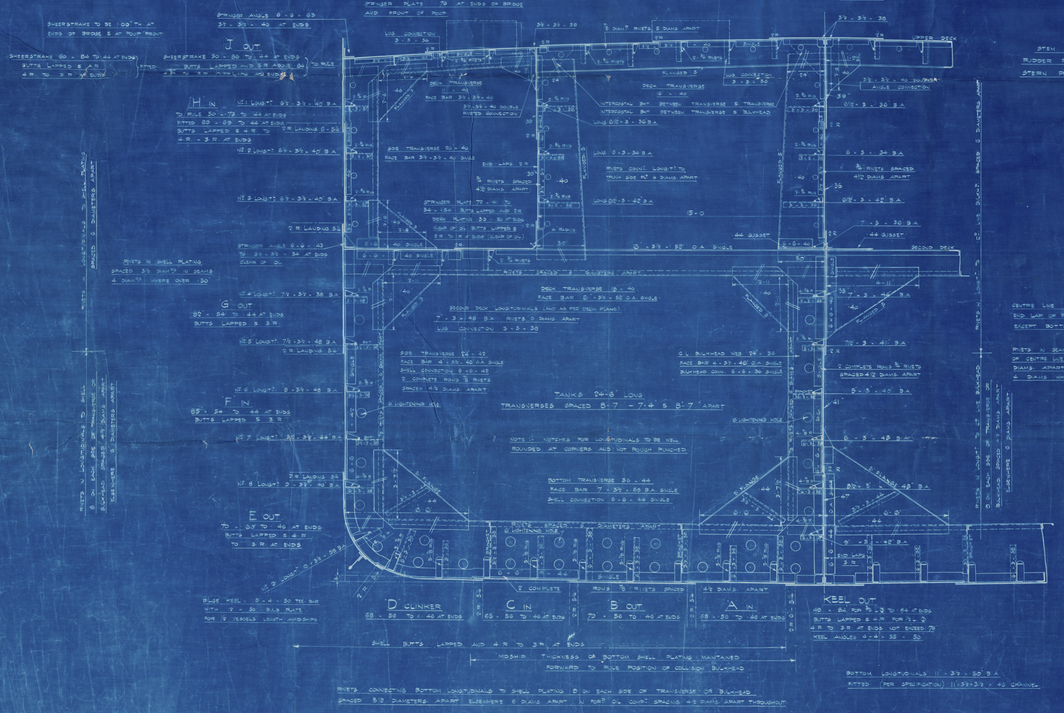

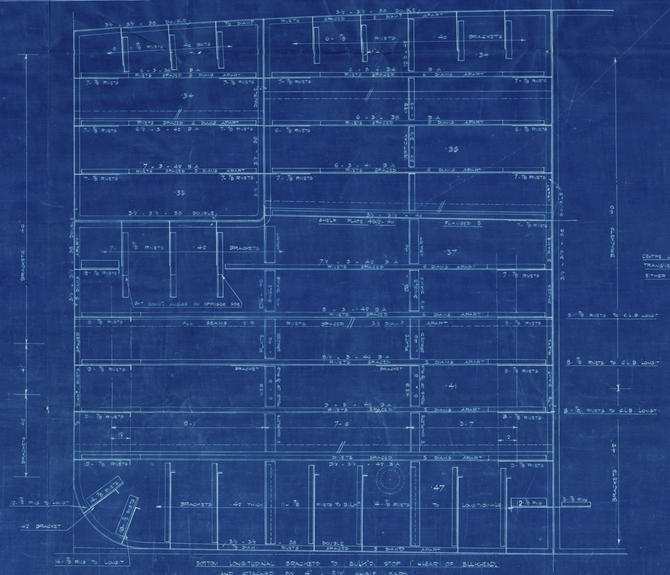

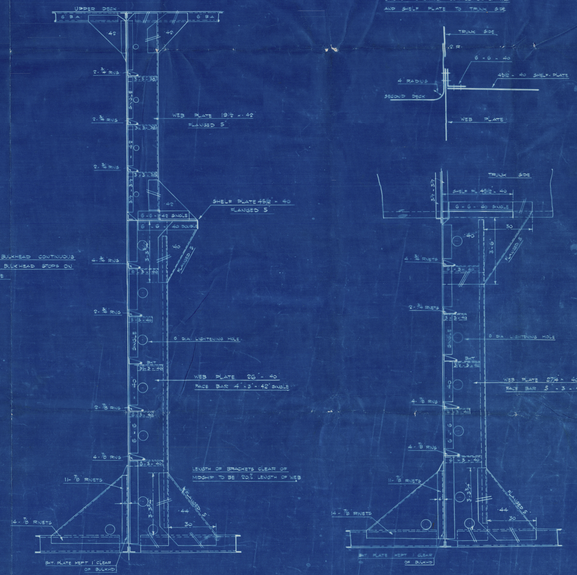

LITHGOWS LTD

No 847.

"BRITISH VENTURE"

MIDSHIP SECTION

(AS BUILT).

GRN. 1st ENTRY REPORT No. 19267.

© 2019
Lloyd's Register
Foundation

W234 - 0090